


31/3/04

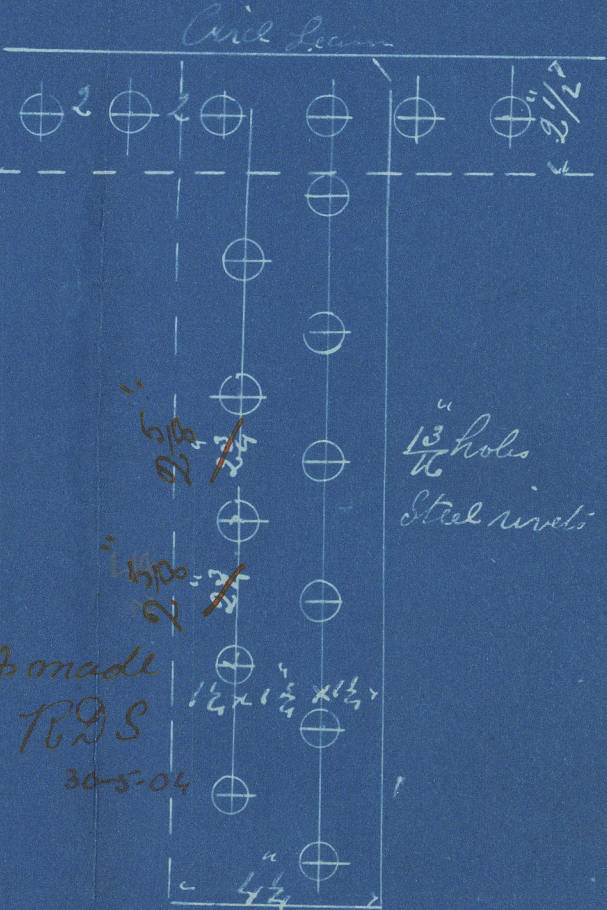

Line of firehole and of funnel

As made
TDS
30-5-04
1 1/2 x 1 1/2 x 1 1/2
4 1/2

6 Iron Stays 2" off dia

STEEL BOILER



10'-6" x 6'-0"

SCALE 1" = 1 FOOT

WP 80 LBS (Lloyds)

For Messrs Harker & Sons Ltd

WP 161 Vessel

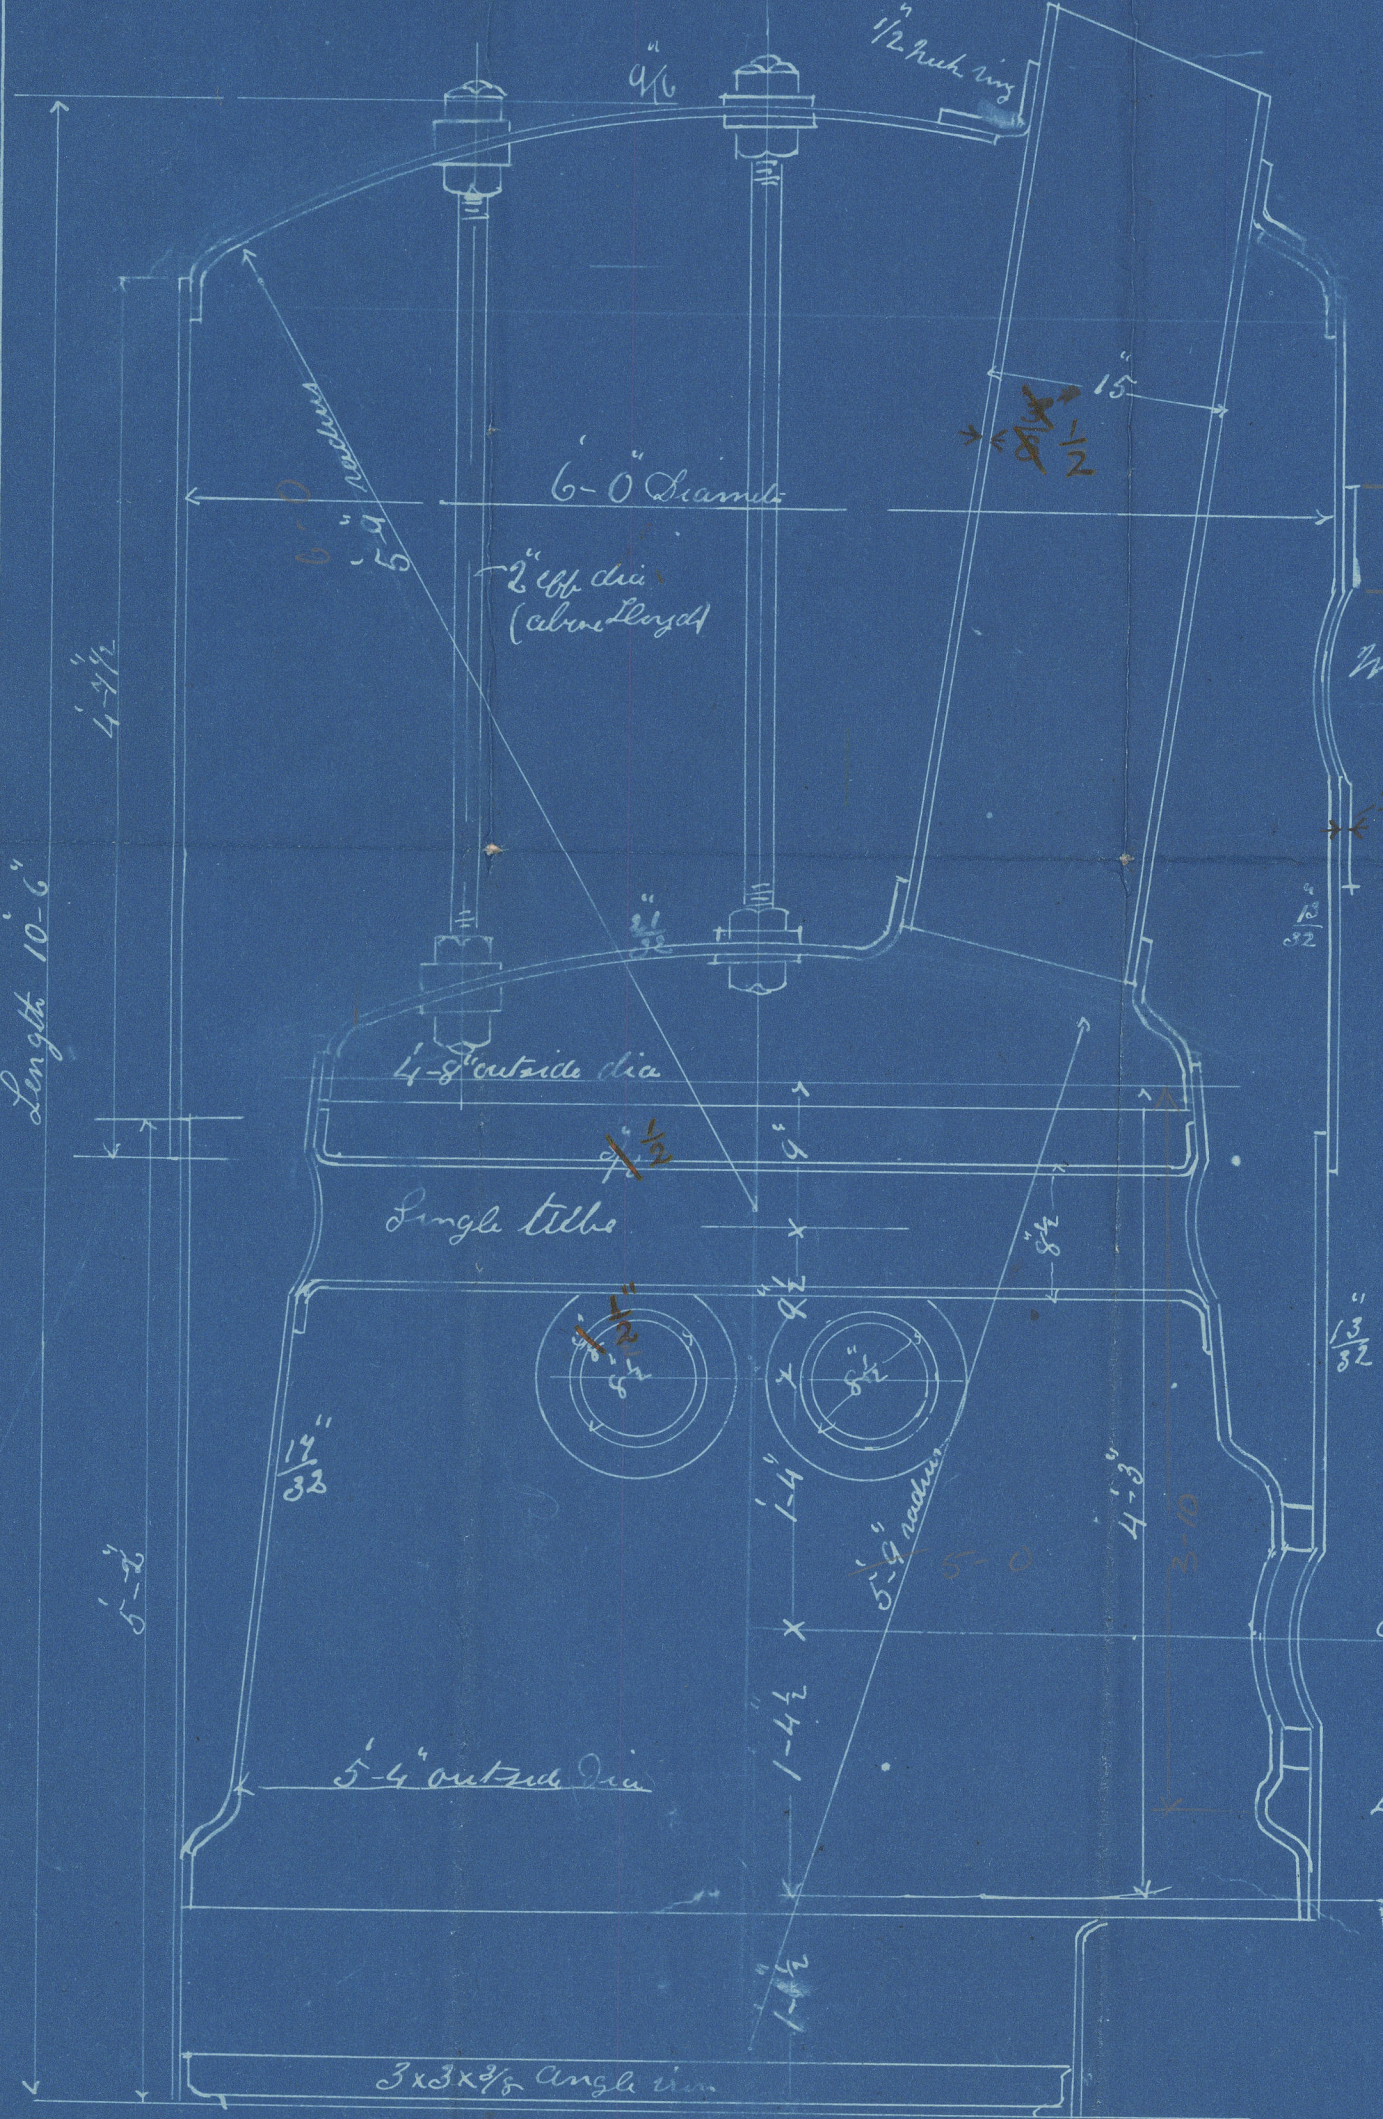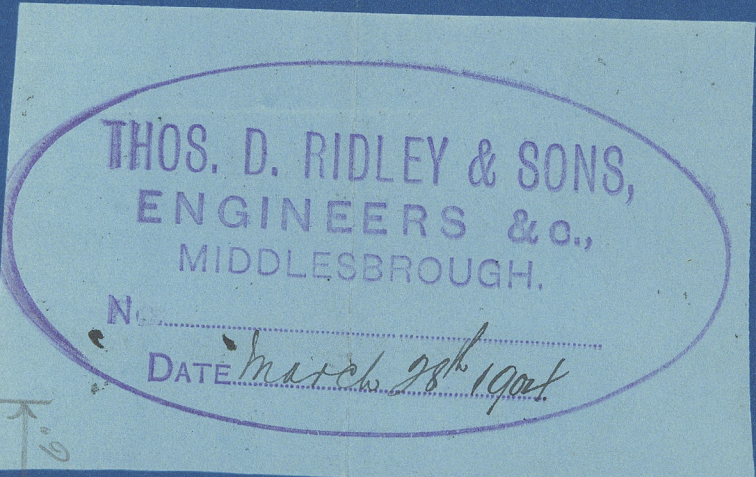


Manhole 15" x 12" at Side

Hand hole to each tube
7/16 compensating ring

Firehole 15" x 11"

4 hand holes round base

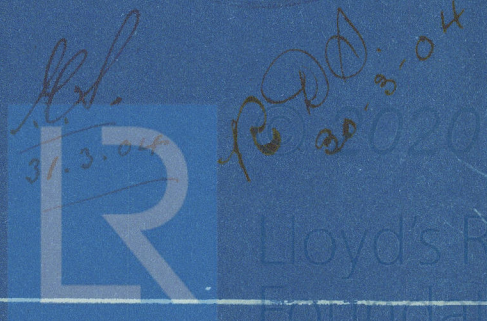

W84-0172

Donkey Boiler
W Harkness & Son
S.S. No 161

T.D. Ridley & Sons



"Cherrybrook"

Mdb. Rpt. No 3942

the 24-32
7 13 26-6-30

© 2020

Lloyd's Register
Foundation

W84-0172