




1:4:08

— N<sup>o</sup> 79-80. —  
— PUMPING PLAN —  
— SCALE 1/4" = 1 FOOT. —

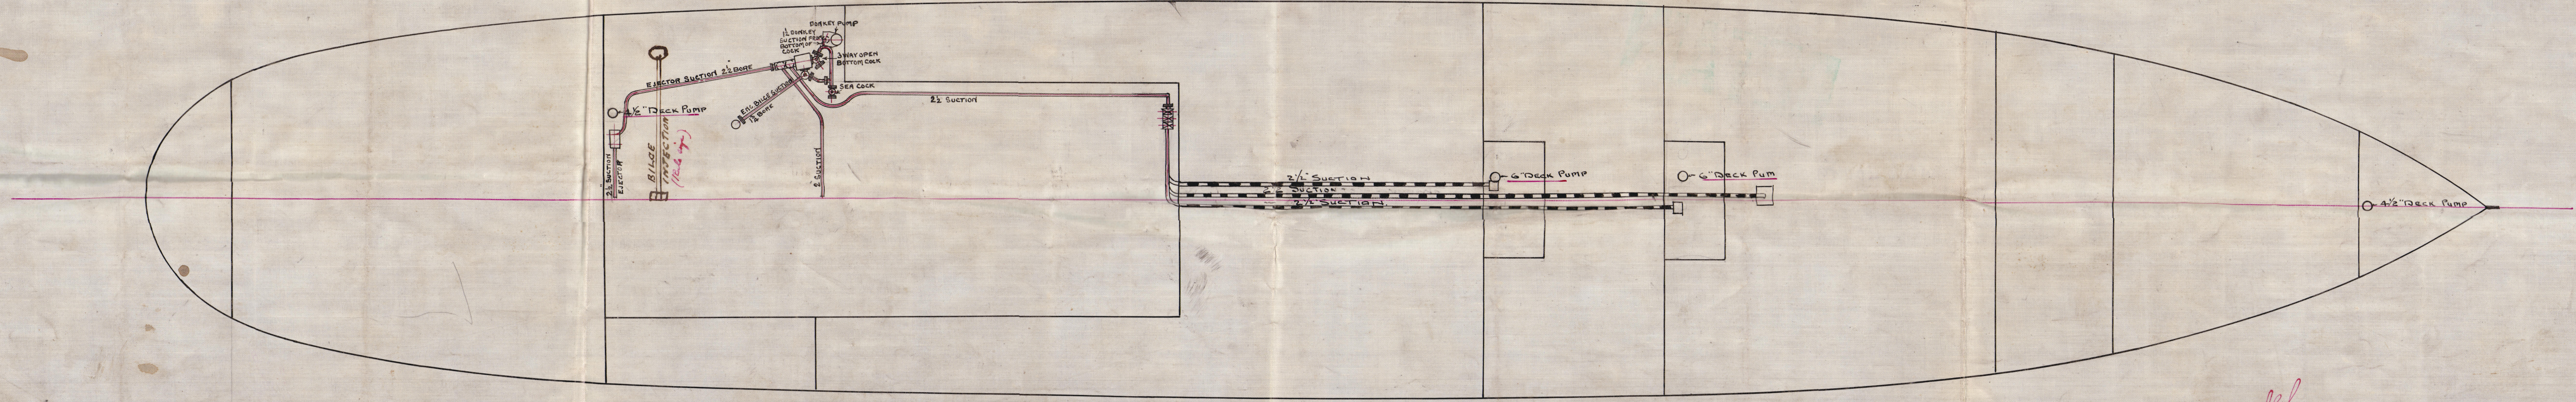

*Handwritten signature and date:*  
R.L.  
30.6.05

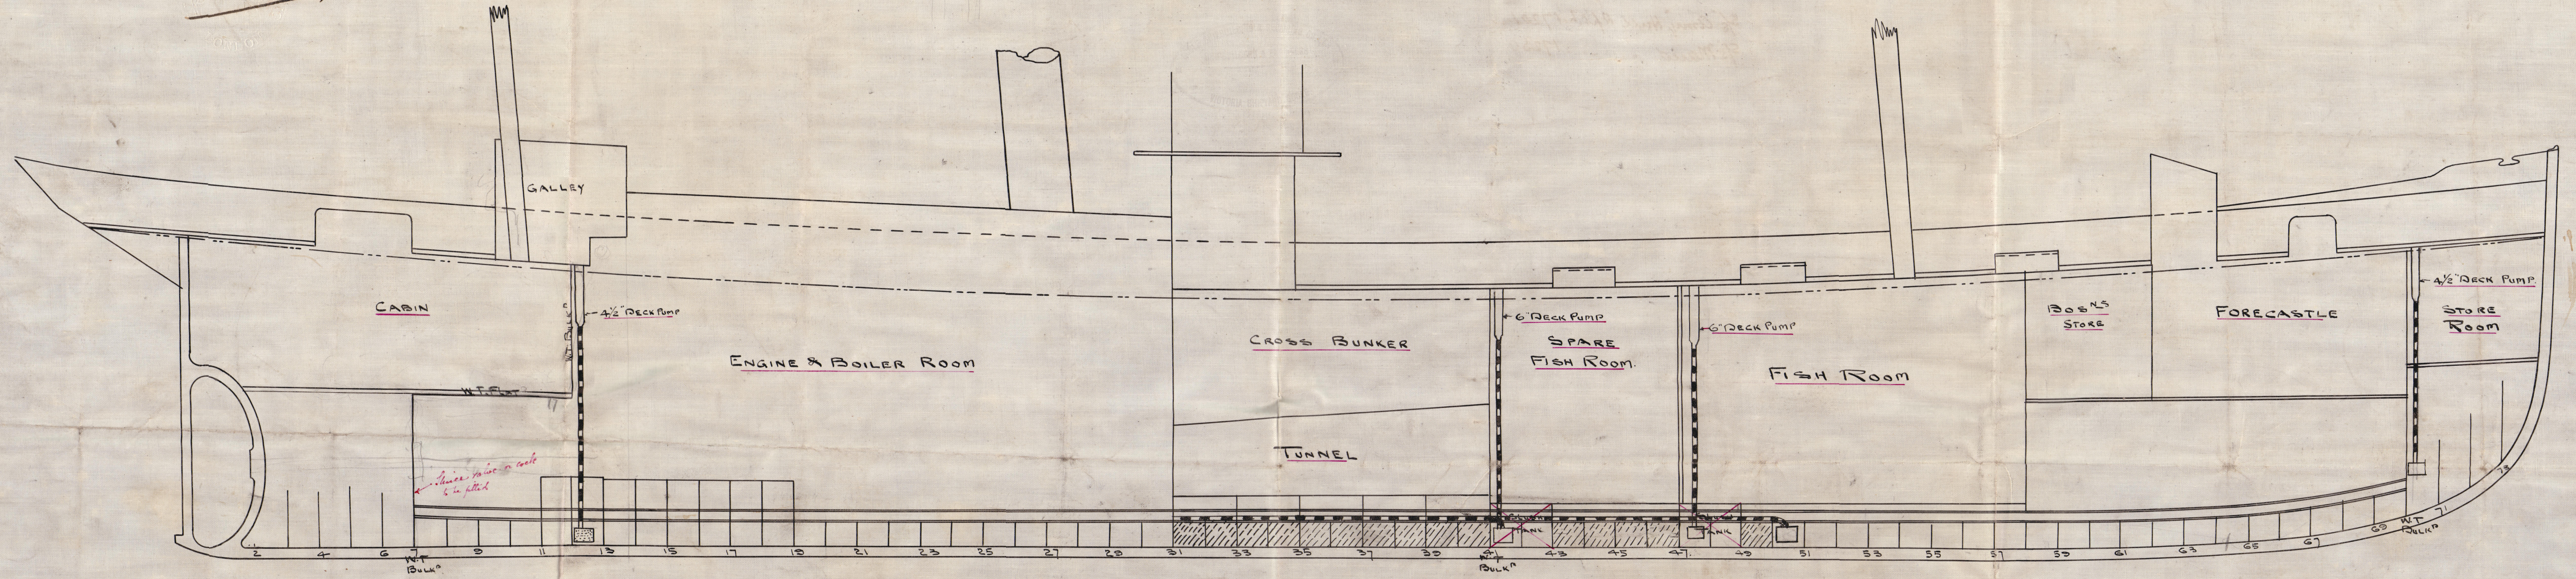

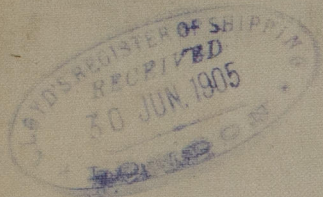

Essole S. & R. Co.  
Nos 49. & 50.

# Pumping Arrangements

S/s Amy, Hull Rpt No. 17201  
S/s Maud. - - - 17250

RETAIN

W840-0079



© 2020

Lloyd's Register  
Foundation