


T.S.S. N^{OS} 461-2 & 3.

STEELWORK PROFILE

SCALE $\frac{1}{8} = 1$ FOOT.

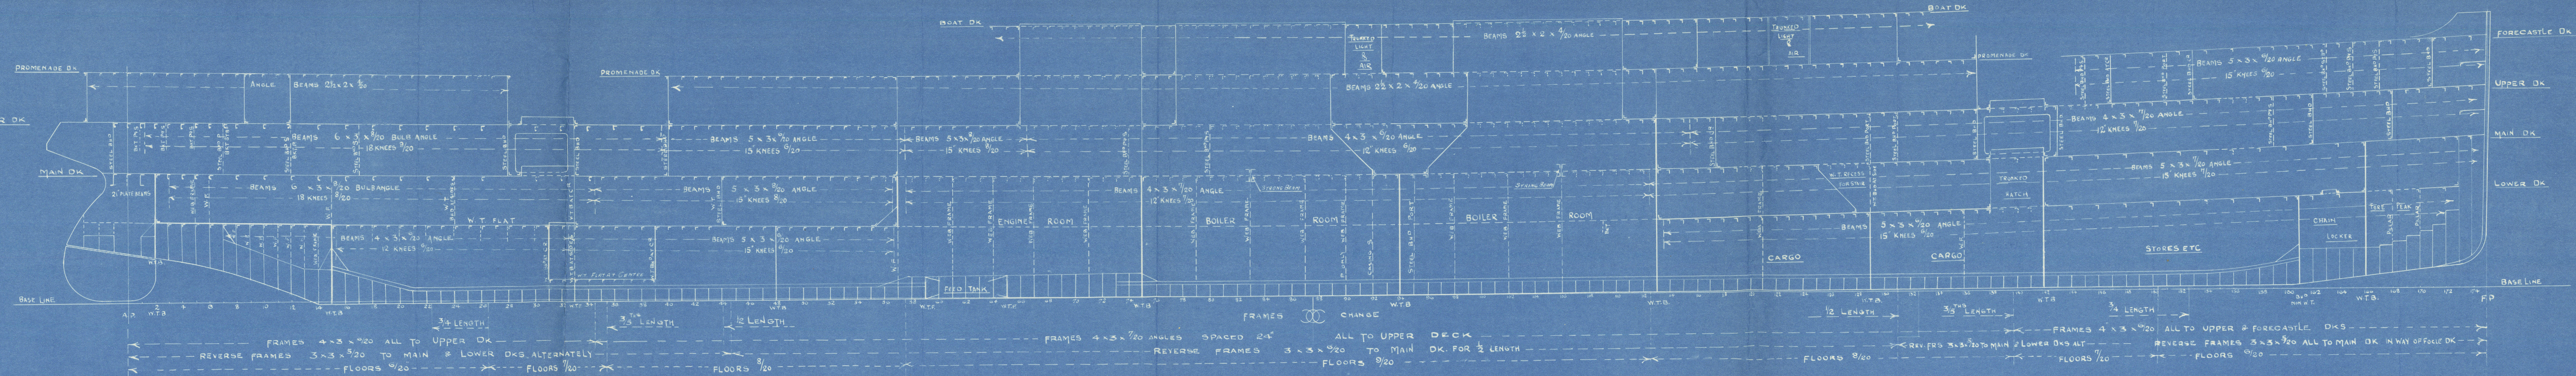

RETAIN


The Fairfield & Co.

No 463

"Mechanical"

Profile (as built)

GLASGOW REPORT No. 28403.

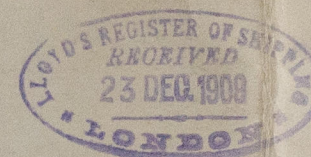

W842-0156



© 2021

Lloyd's Register
Foundation