



844-0006

DIMENSIONS 760'-0" x 87'-6" x 60'-0" TO SHELTER DECK

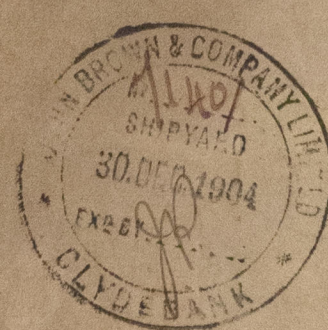

# MIDSHIP SECTION


SCALE 1/2" = 1 FOOT

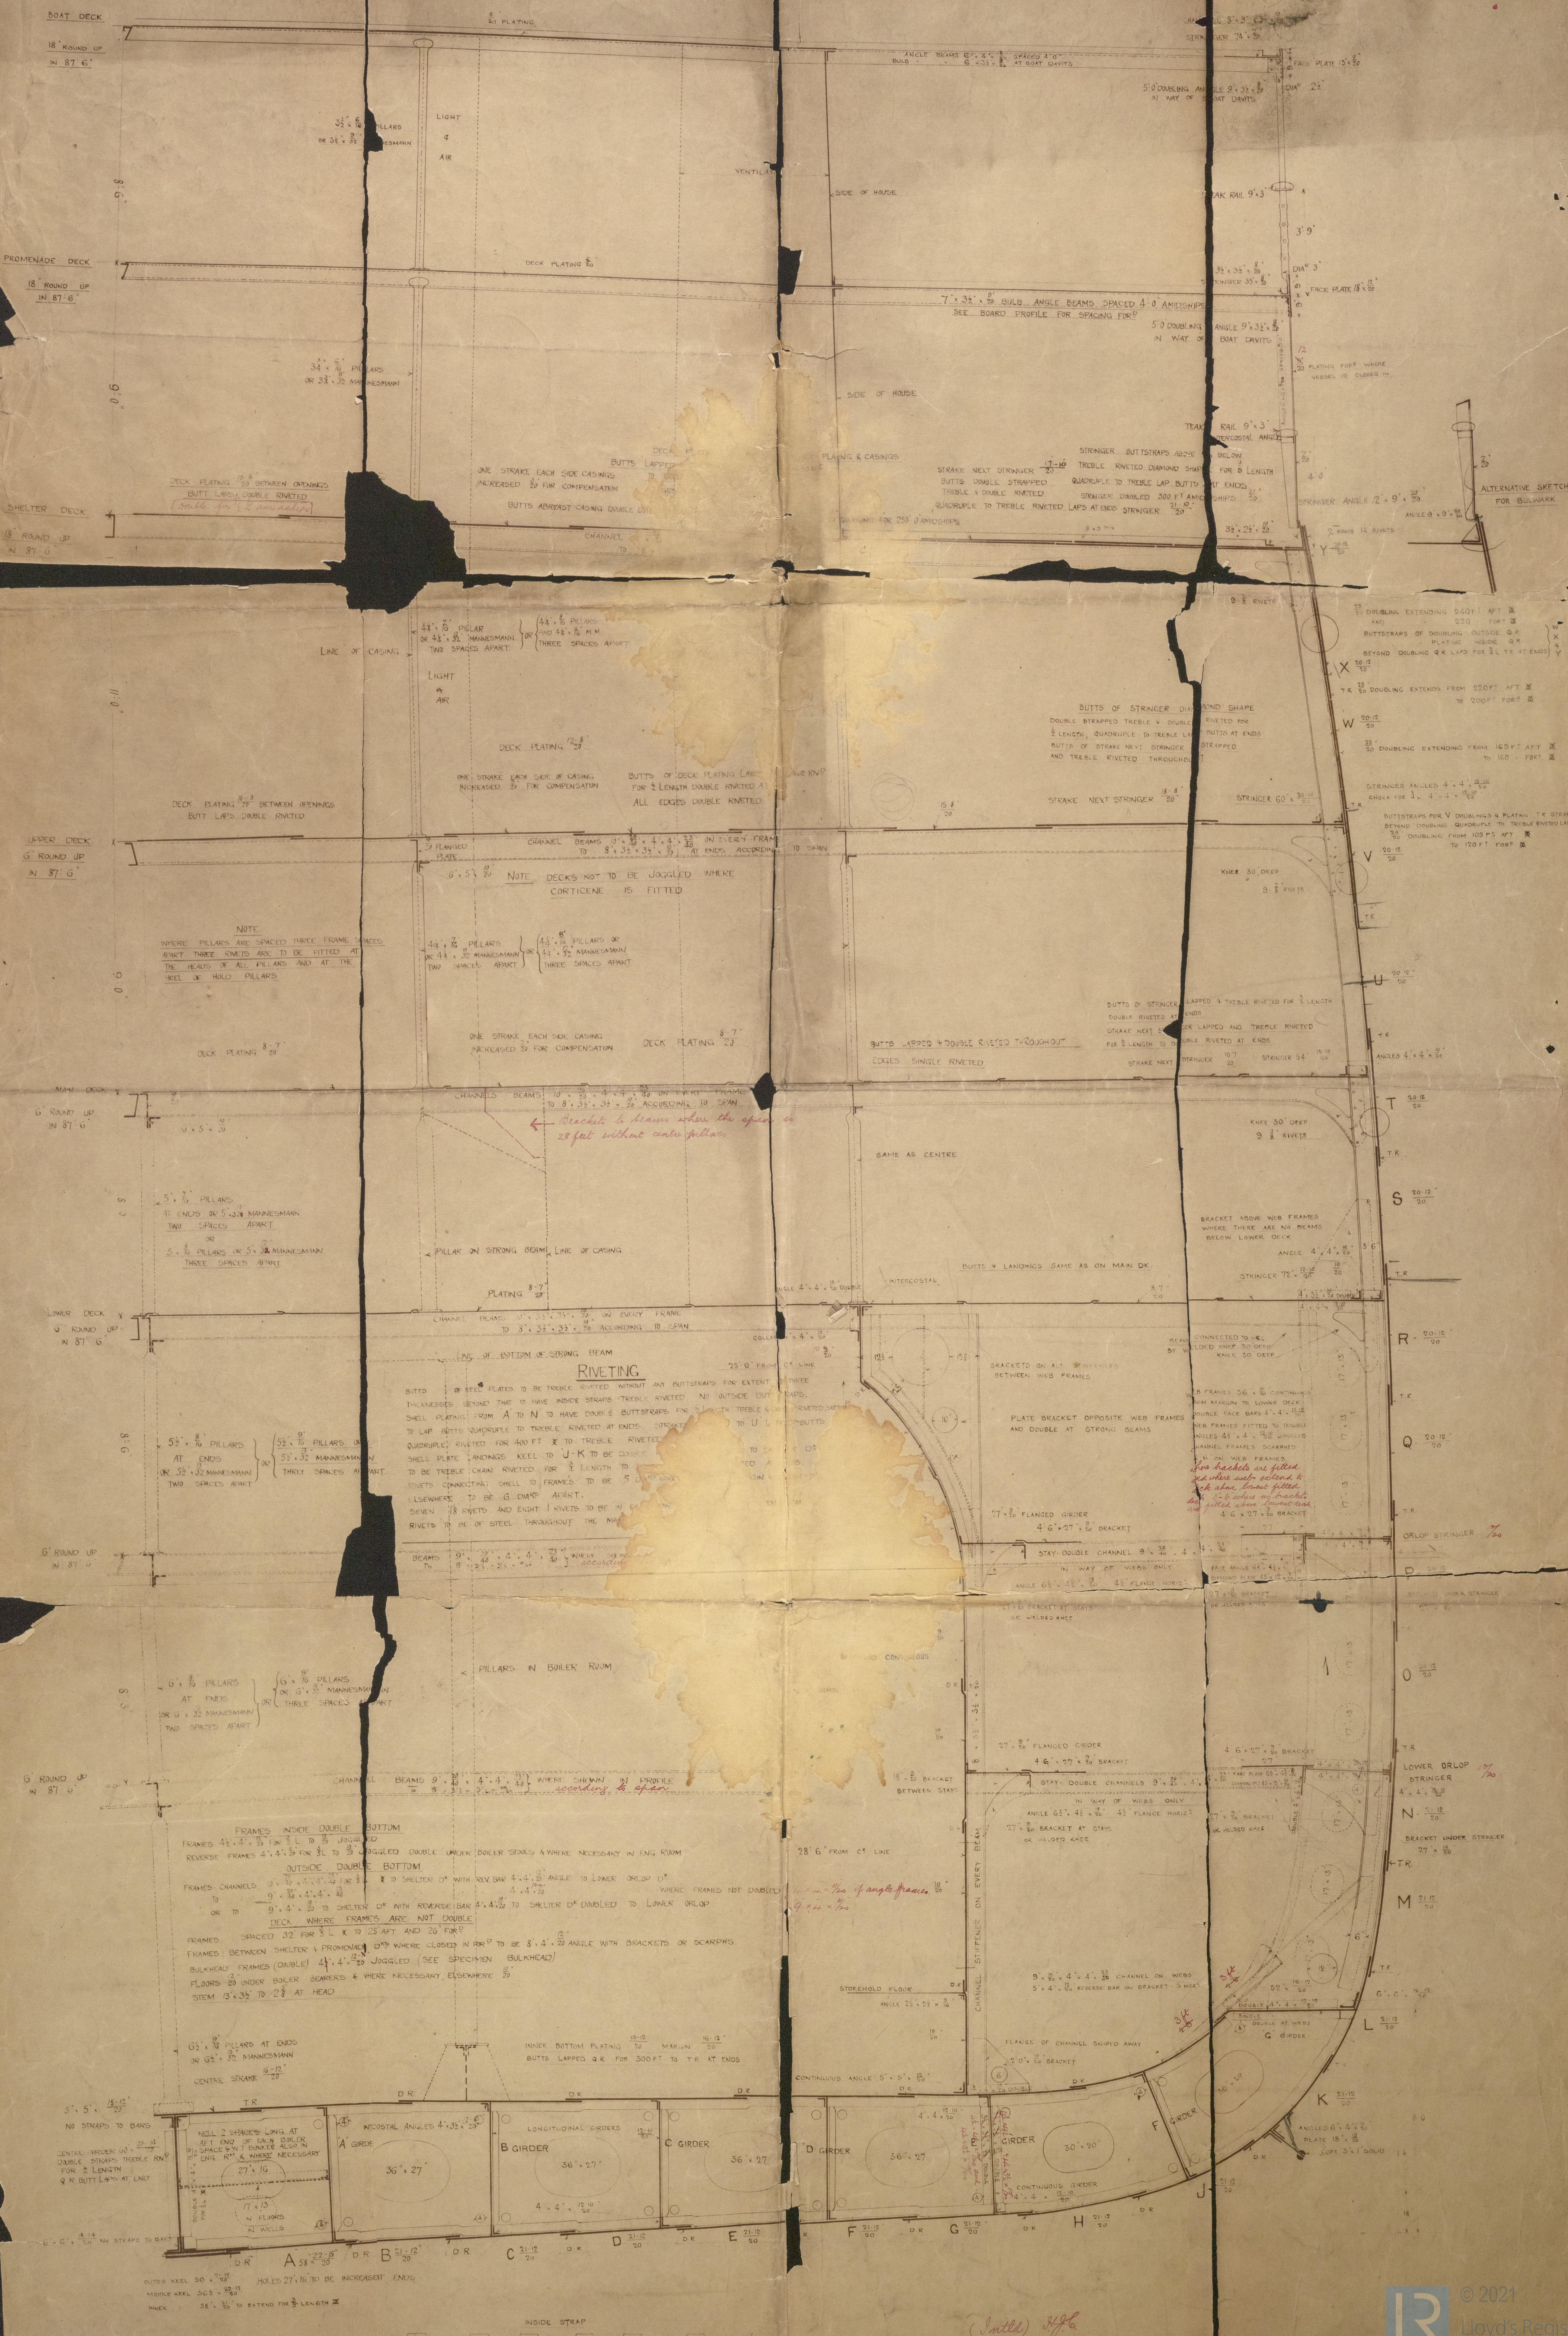



W844-0006

DIMENSIONS 760'-0" x 87'-6" x 60'-0"

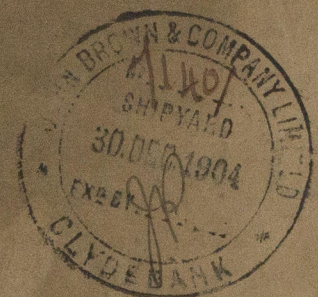

MIDSHIP SECTION

SCALE 1/2" = 1 FOOT

BOAT DECK

18' ROUND UP

6' ROUND UP  
IN 87'-6"

