




Lloyd's Register of British & Foreign Shipping,

342, Argyle Street, Glasgow.

10th Sept 1907

The Secretary.
Glasgow.
Sir.

In reply to London letter of the 6th inst. re length of the Promenade and Boat-decks of the "Lusitania". I beg to state that they are as per the following sketch

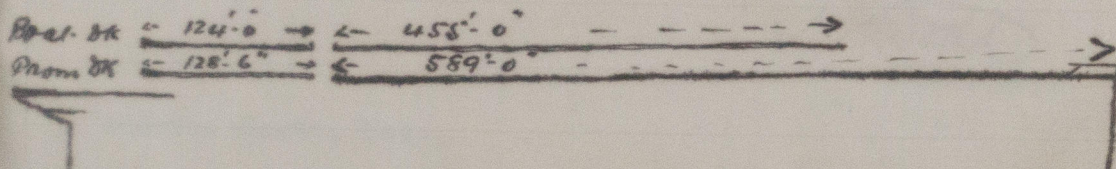

I am Sir.

Yours obedient servant.

M. I. I. I.

455	128.6
124	589
579	717.6



© 2021

Lloyd's Register
Foundation

W844-0014