
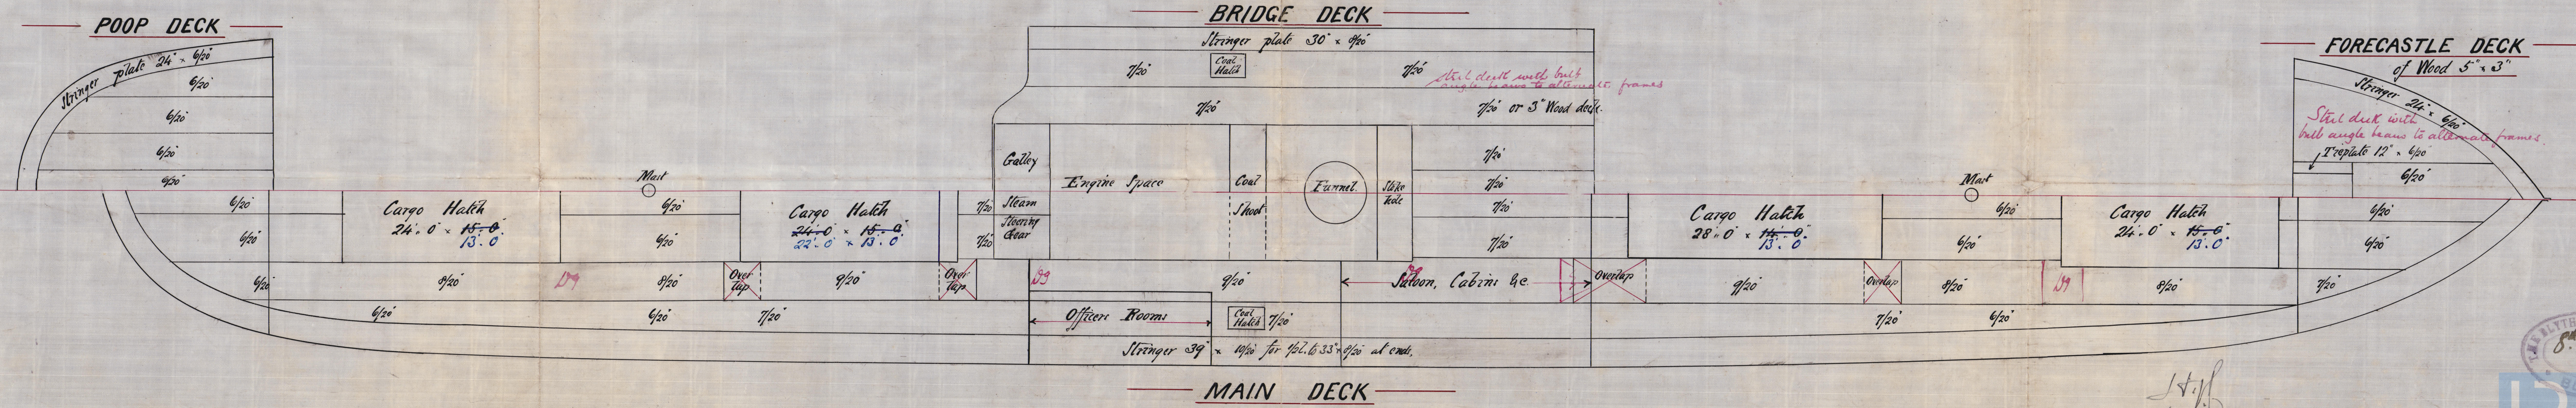


# LONGITUDINAL SECTION S.S. N<sup>os</sup> 109 & 112

Scale 1/8 in. = 1 ft.

14.8.01  
L. 9.01  
8.11.01  
24.2.02

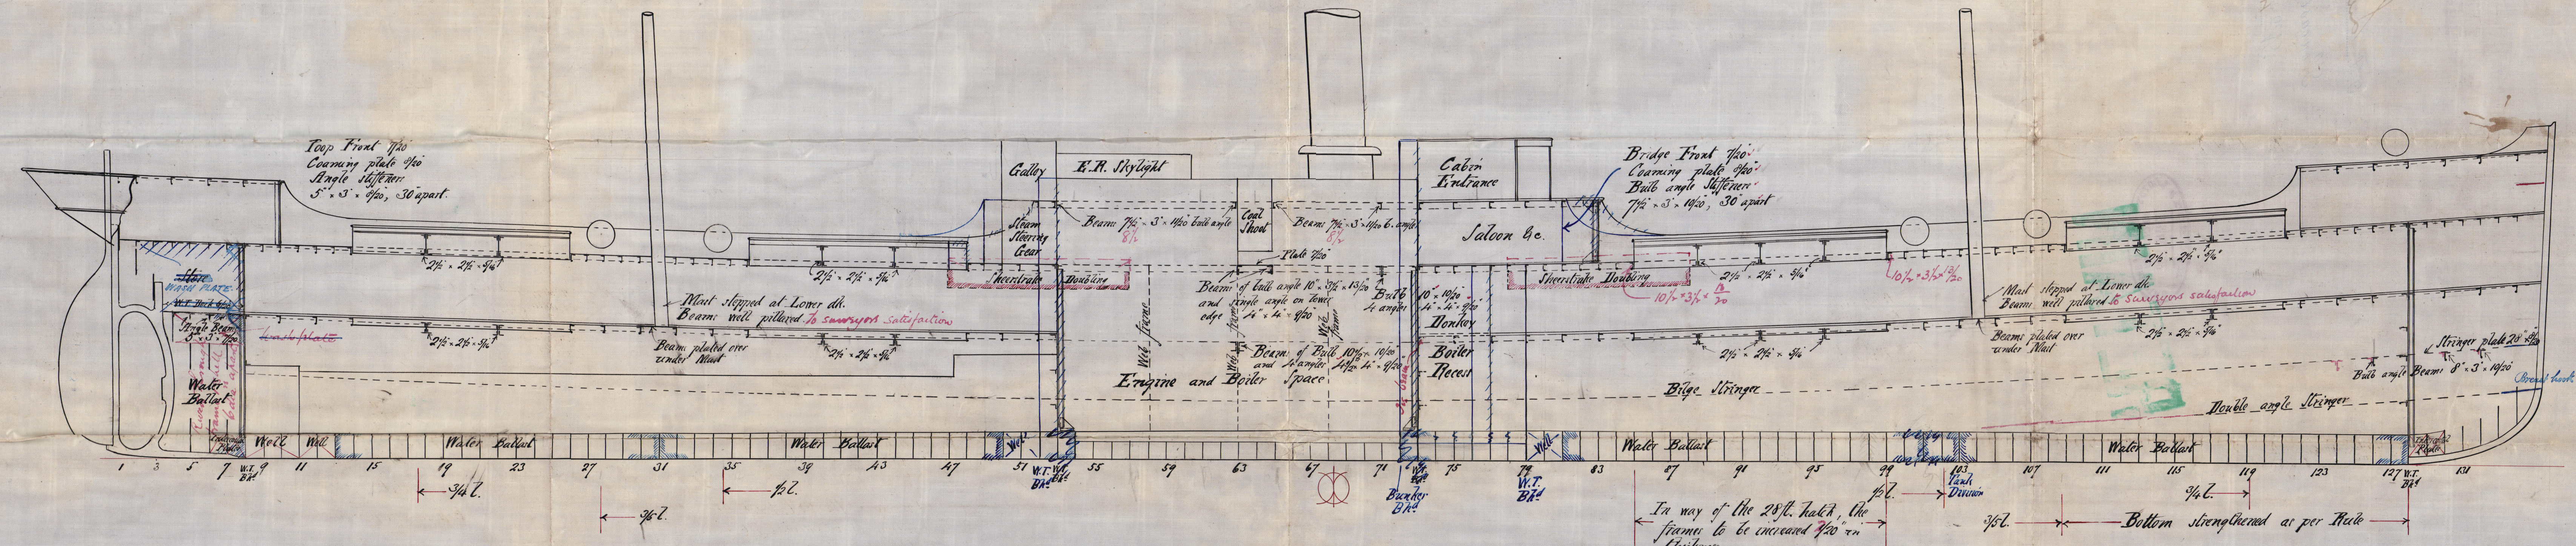

8th Aug. 1901  
Hobbs






W845-0147



Blyth S. B. C?

S. S. N<sup>o</sup> 109-112


Profile

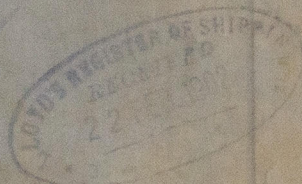 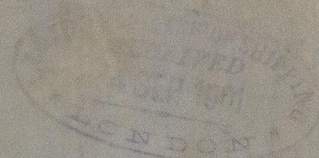

S.S. *Lusitania*

Newcastle Report

N<sup>o</sup> *HH680*

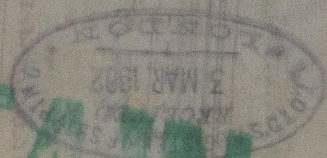

RETAIN



© 2020

Lloyd's Register  
Foundation

W045-0147