



5900-7-8-11

PROFILE & DECK PLAN

S.S. No 213

LENGTH B.P. 331'-0" BREADTH EXT 47'-9" DEPTH MLD 24'-6"

SCALE 1" = 1 FOOT.

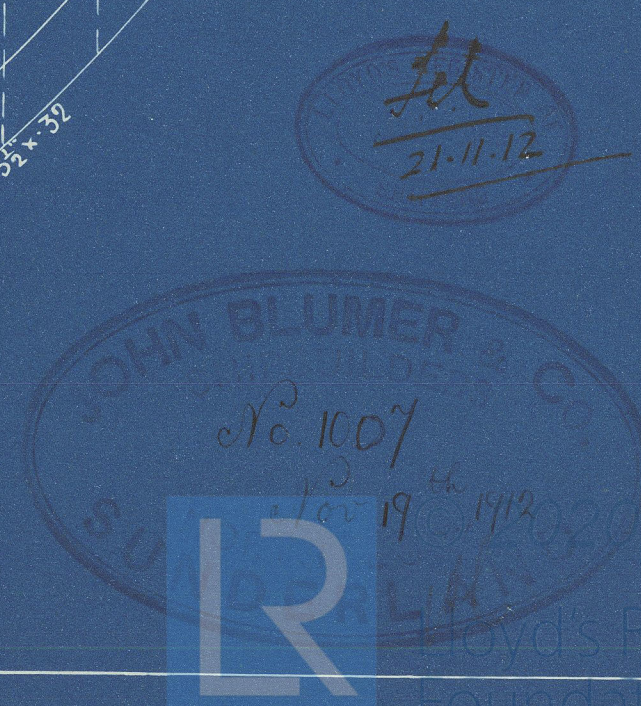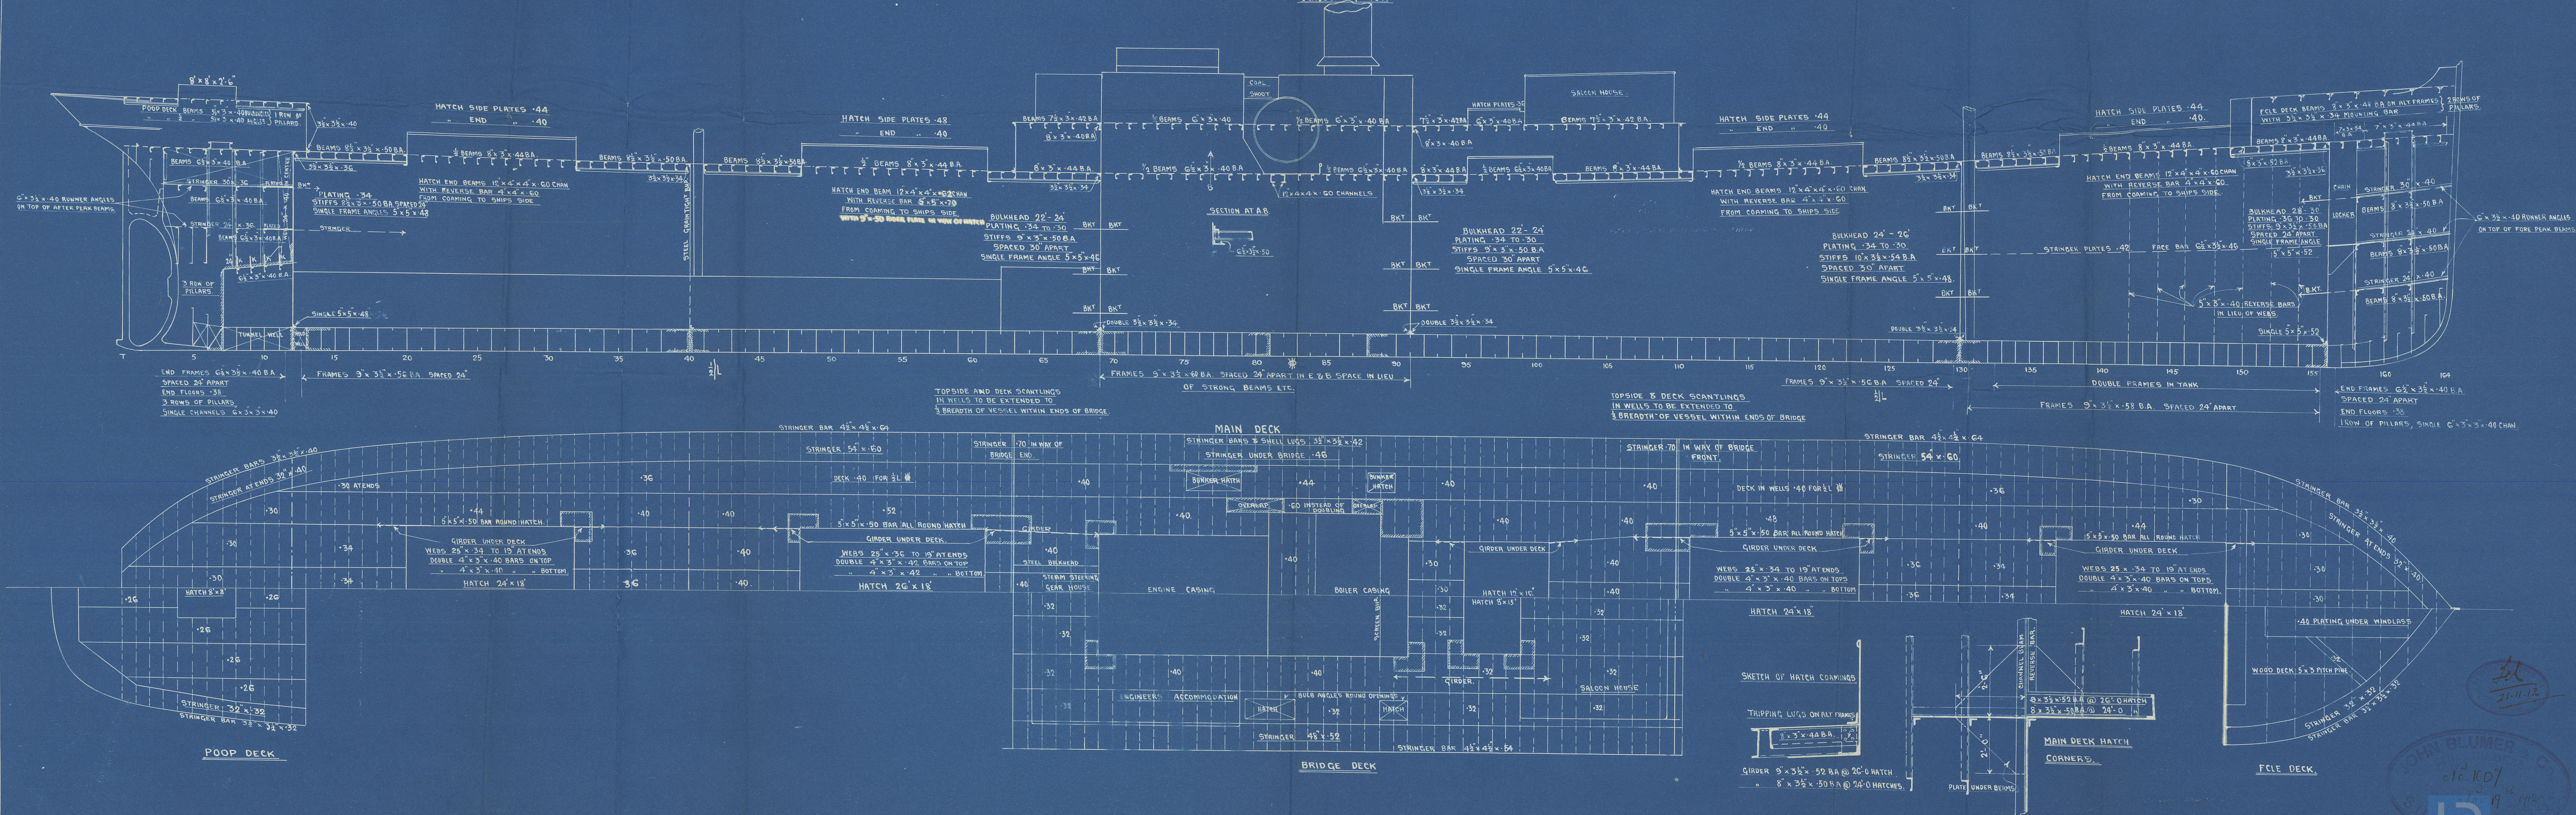

SUNDERLAND

Mess^{rs} JOHN BLUMER & Co.

PROFILE & DECK PLANS (AS BUILT)

No 213

S.S. "SALAMANCA"

Lo. Report No. 25501

RETAIN



© 2020

Lloyd's Register
Foundation

W8047-0055