

# STEEL BOILER 314.

FOR GRANGEMOUTH DOCKYARD COY S.S. "M 279"  
TO PASS LLOYDS

180. LBS. WORKING PRESSURE.

SCALE 1" = 1 FOOT

10-5-05.




SHELL RIVETING

RIVET HOLES  $1\frac{1}{8}$ " DIAMETER  $\times$   $8\frac{3}{4}$ " PITCH  
PLATES STEEL 28 TONS MINIMUM TENSILE STRENGTH  $1\frac{1}{32}$ " THICK  
OUTER BUTT STRAP  $1\frac{1}{16}$ " THICK - INNER BUTT STRAP  $1\frac{1}{8}$ " THICK  
9-54

not less than  $1\frac{1}{8}$ "

15-5-05

PLATES	THICK	LLOYD'S RULES	PRESSURE	SURFACES	SQ FT
Shell	$1\frac{1}{32}$ "	$21.77 \times (0.85 \times 1) \times 95 =$	184 lb	231 Tubes	1350

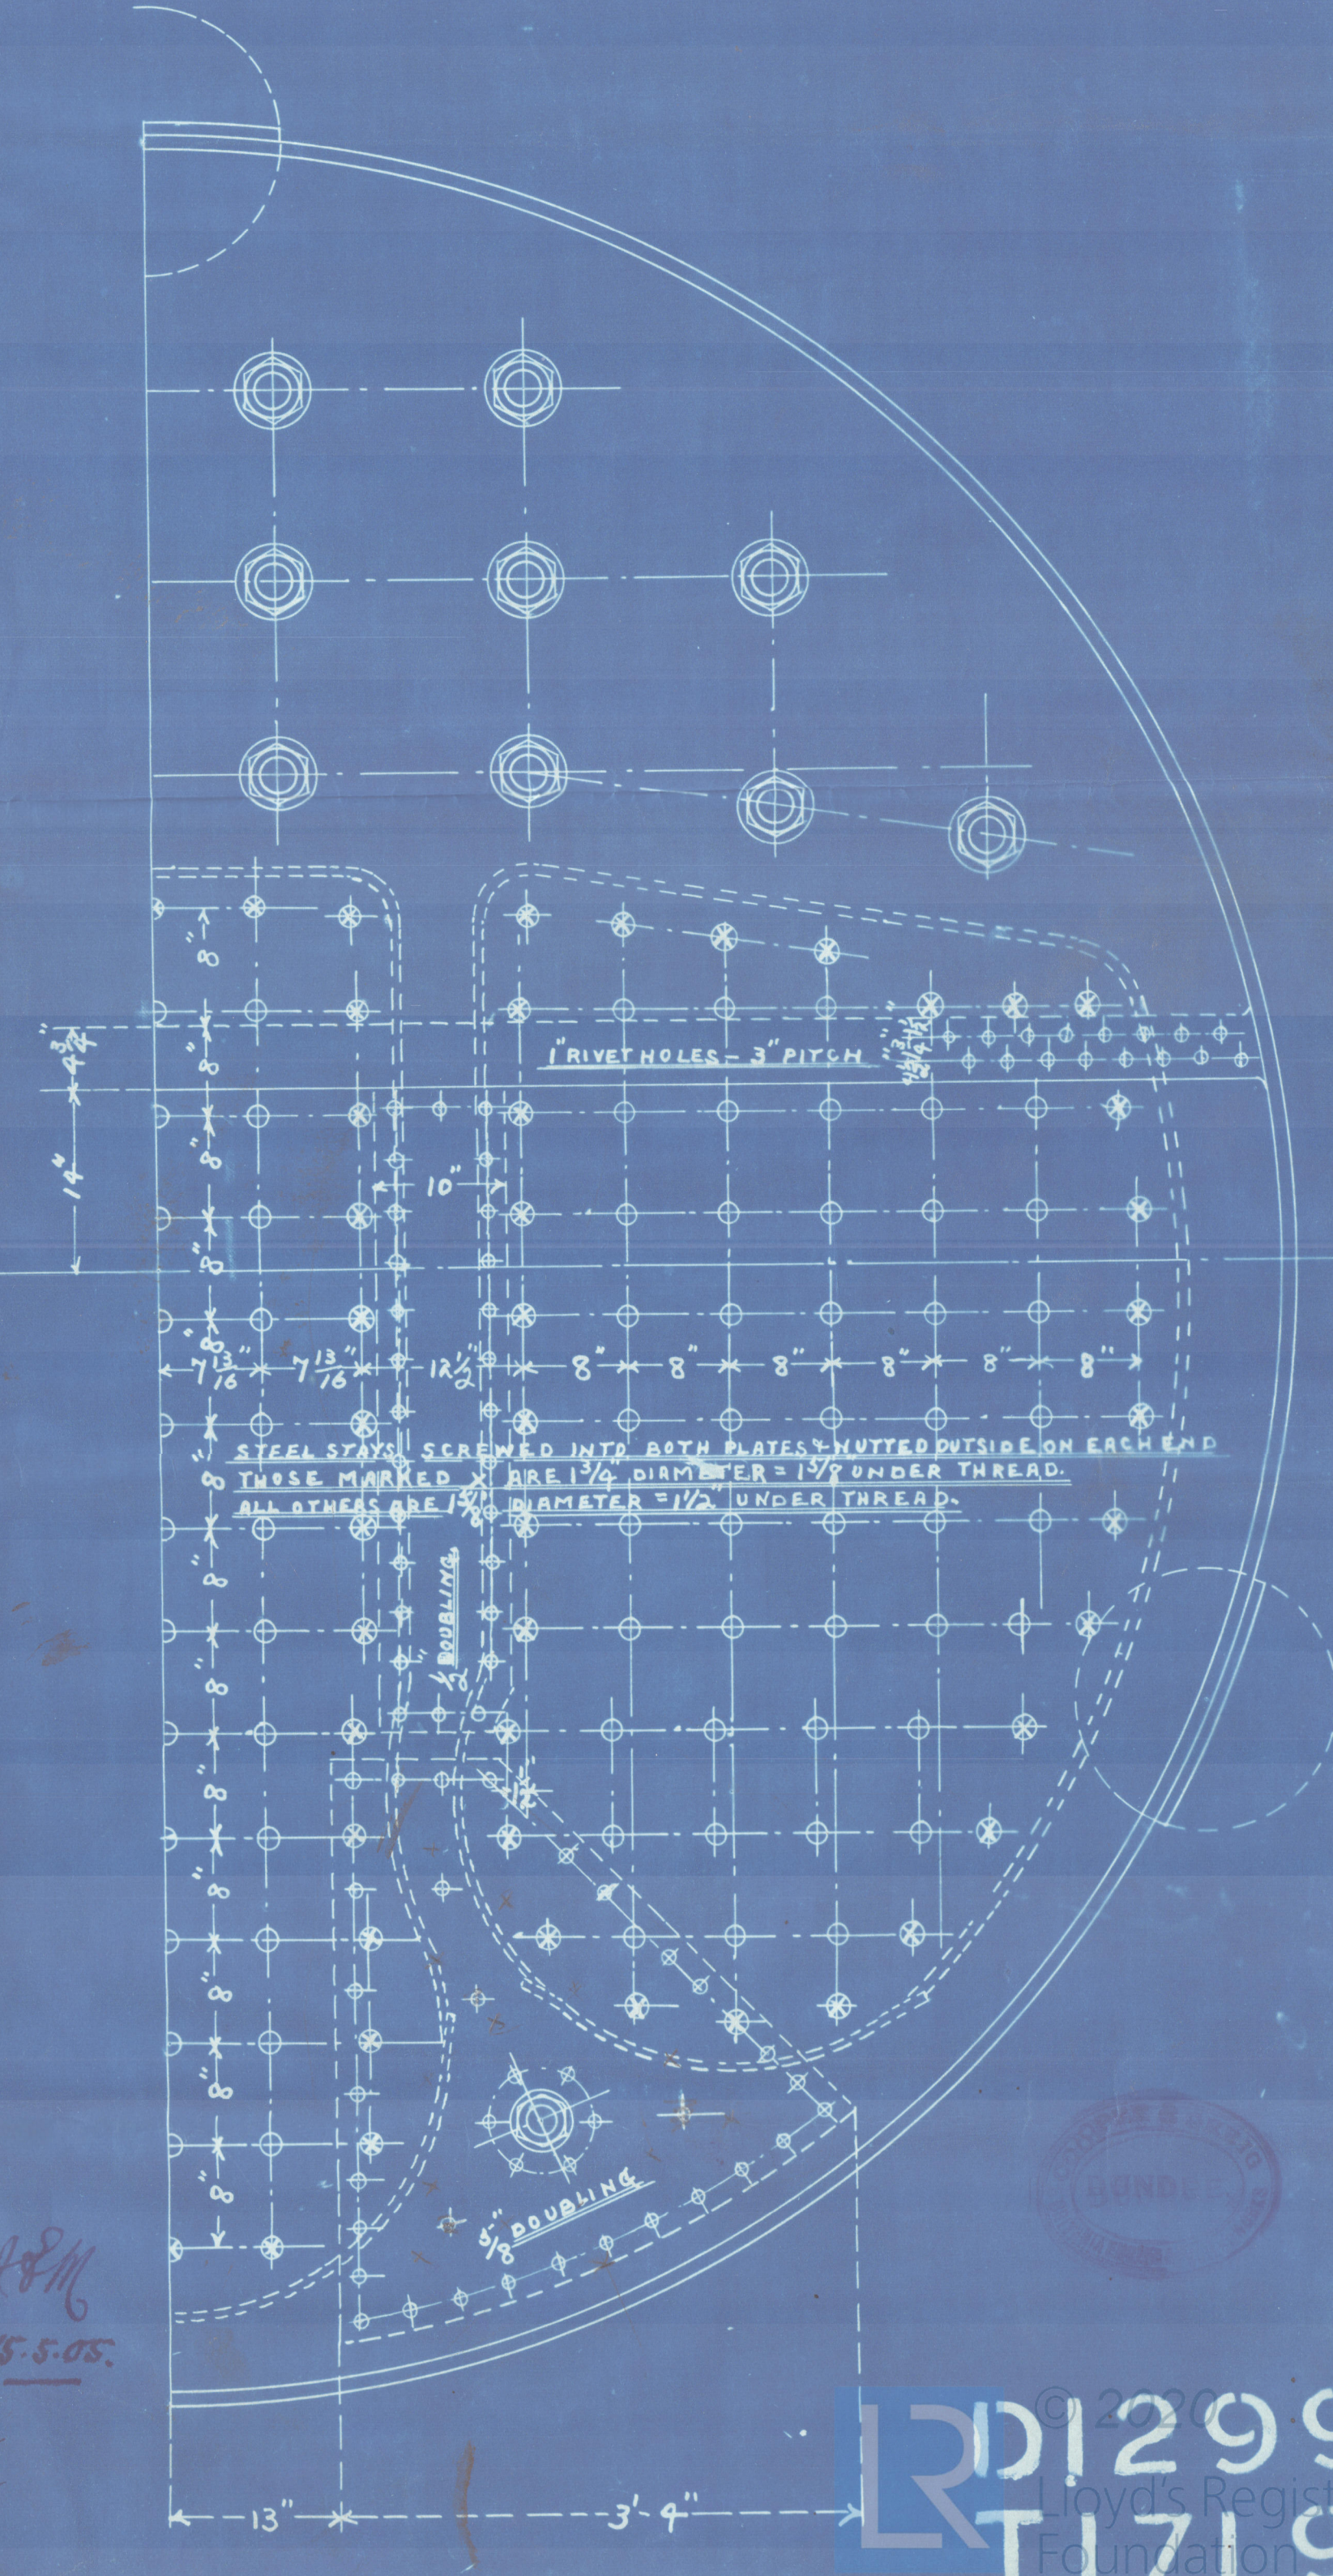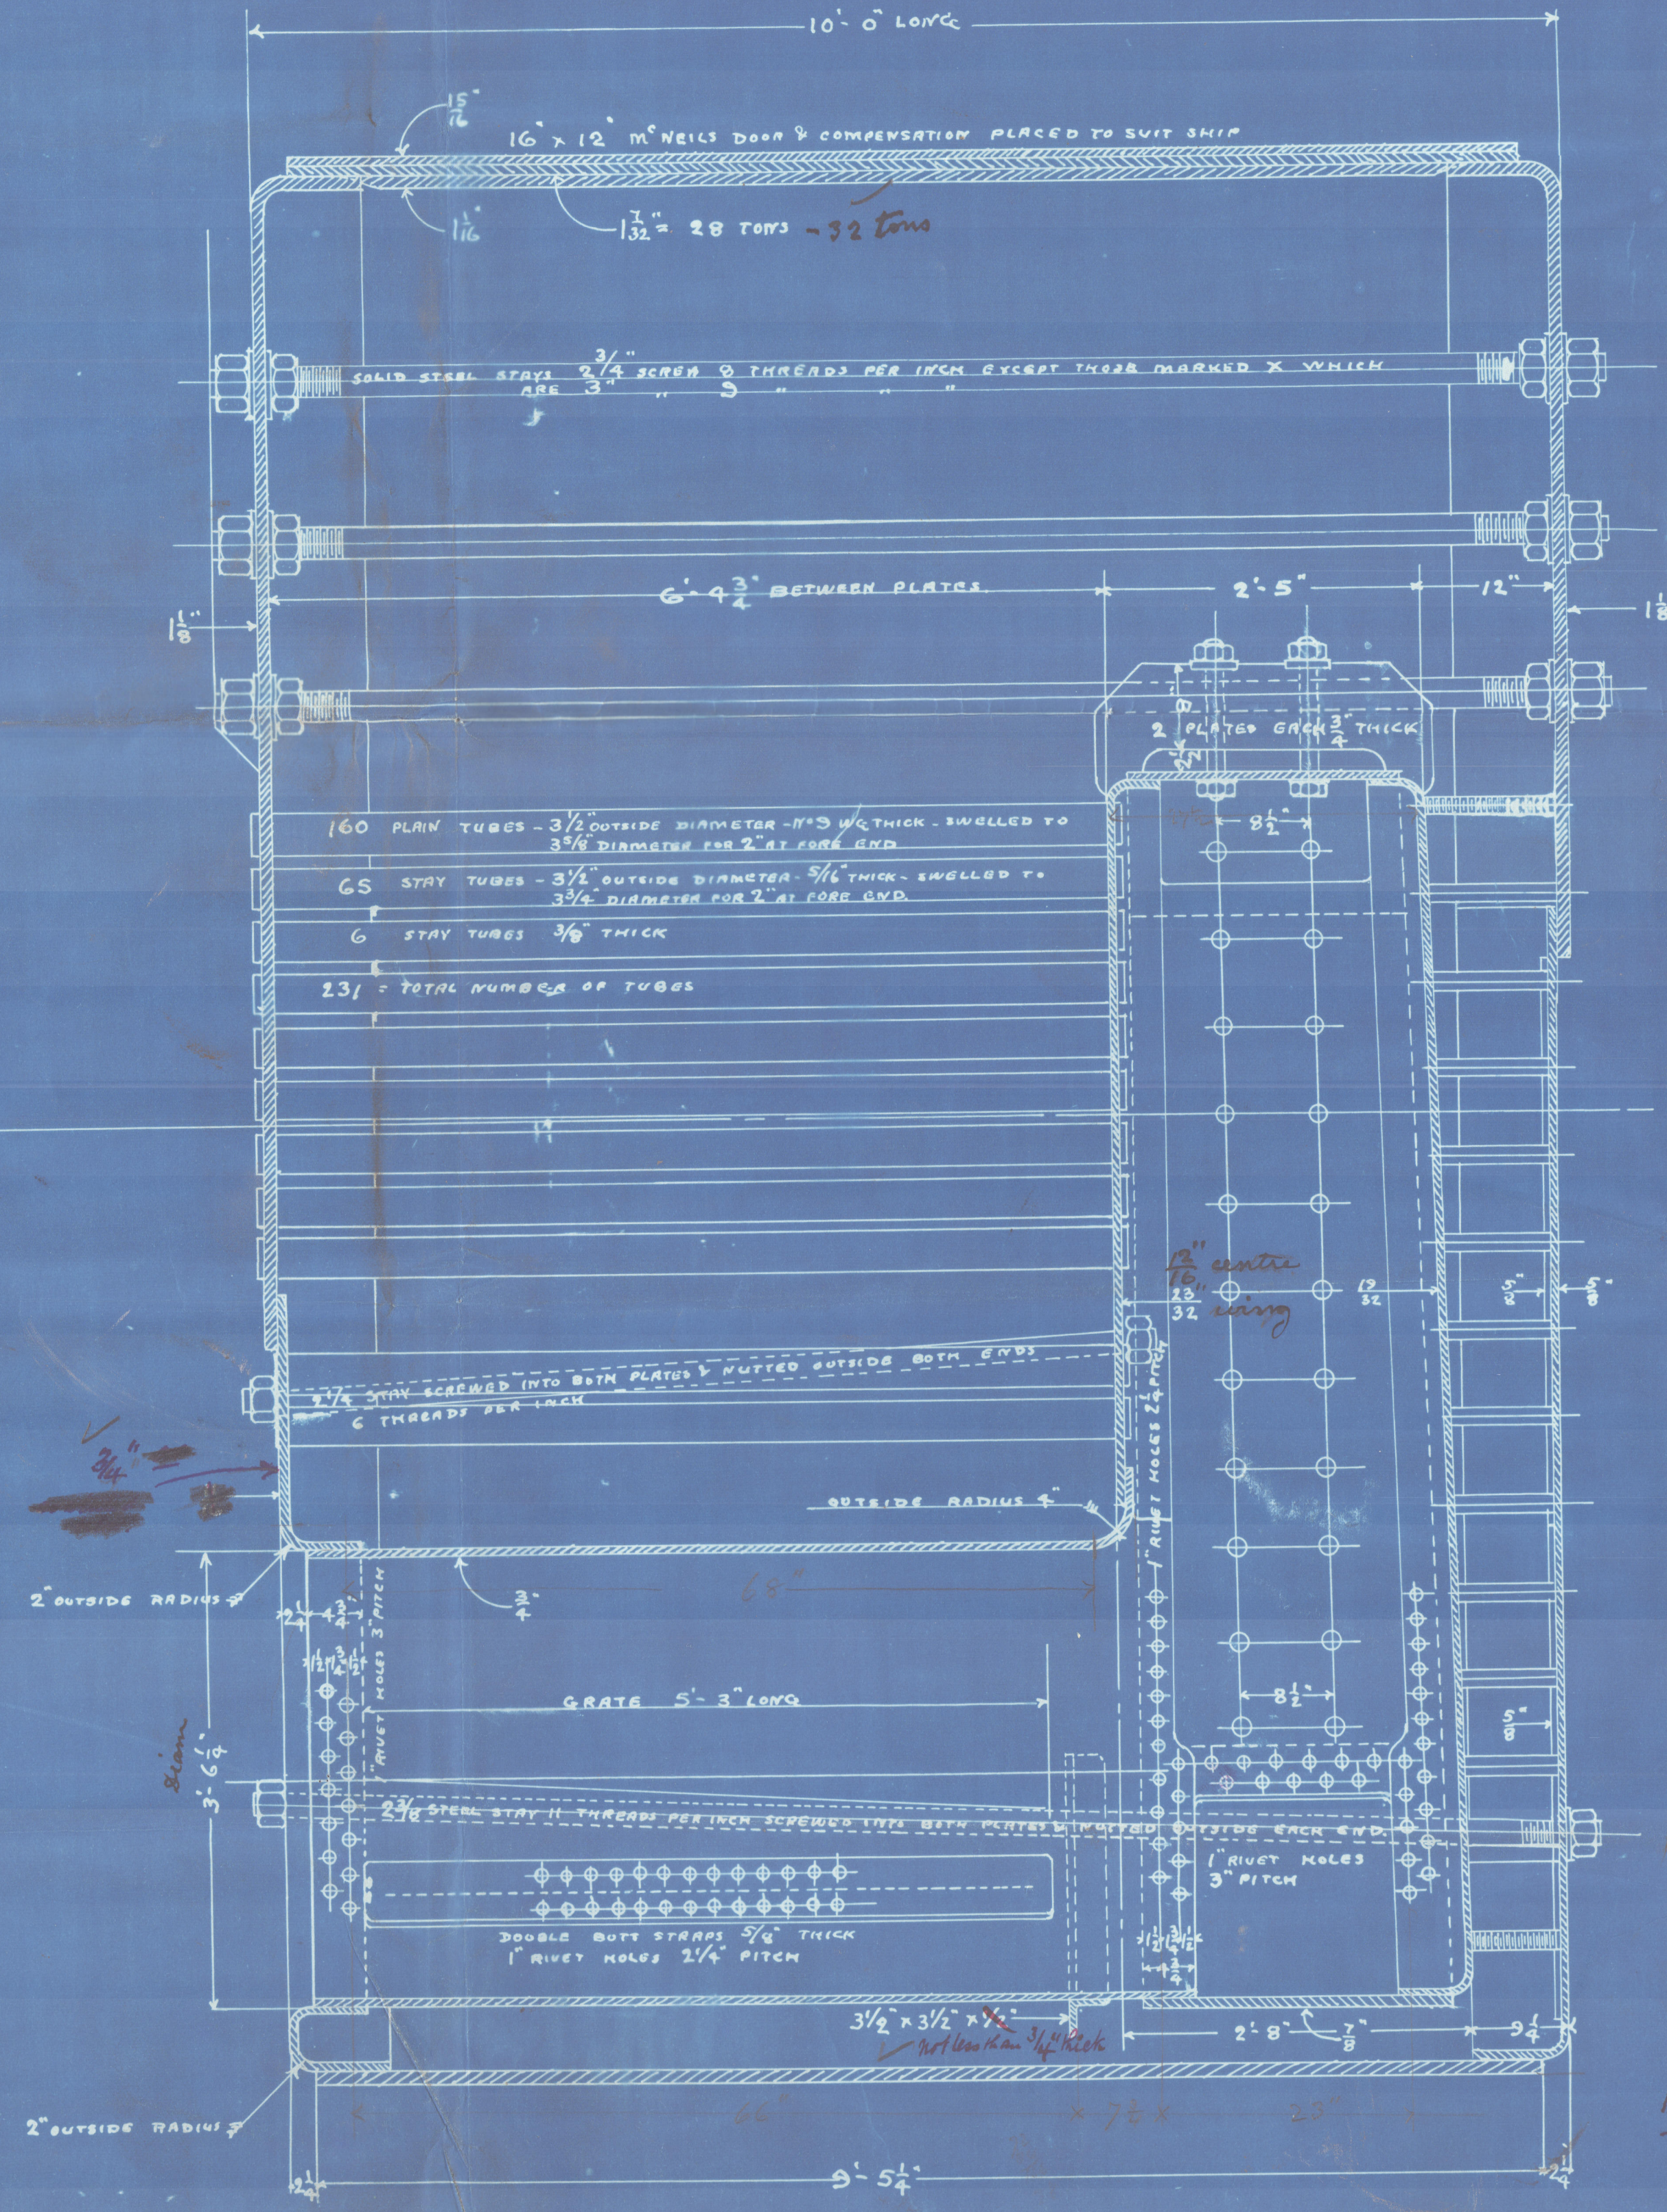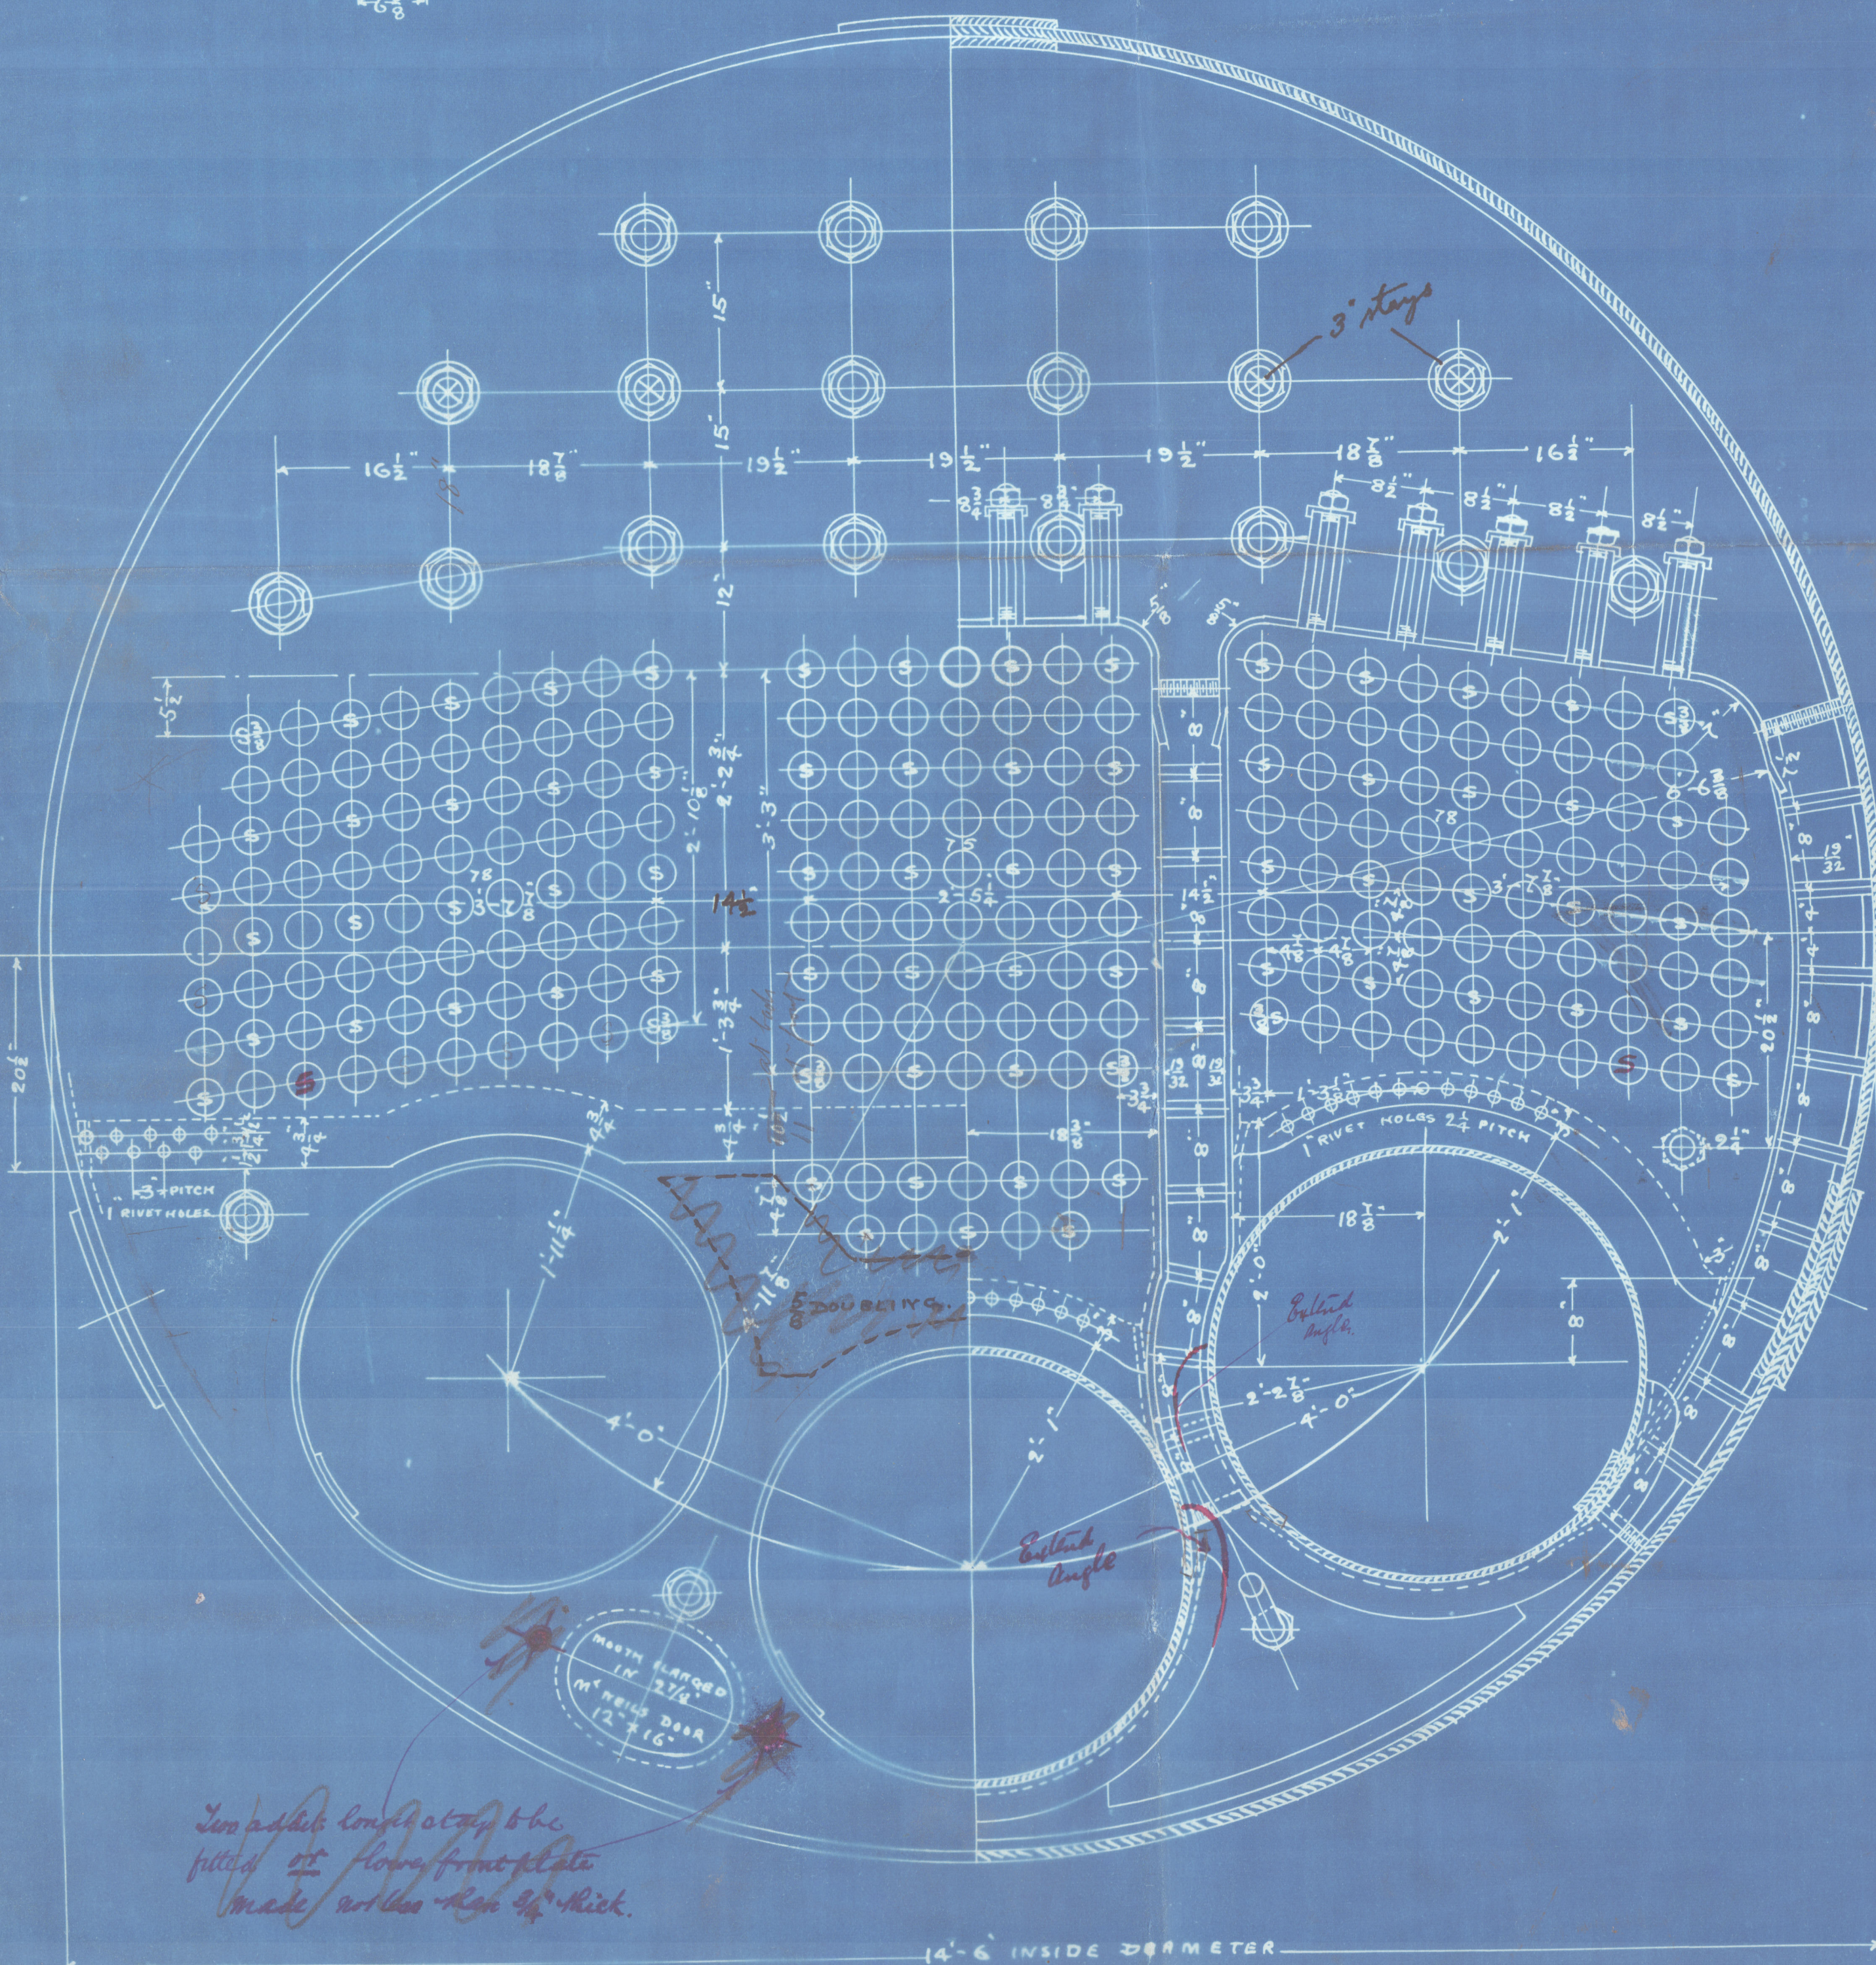



Main Boiler,

Cooper & Greig. N° 314

Grangemouth & Greenock  
Greenock & Grangemouth SS N° 249


S. S.

" MARTHA "

Dundee

4090

Rt J. J. O'Neil

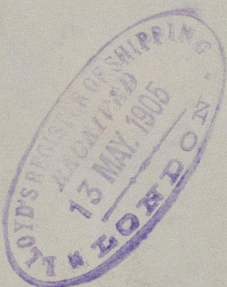

N° 844  
Lloyd's Test  
360 lbs  
WM-29.8.05  
N° 844

Lloyd's Test  
360 lbs.

RETAIN



© 2020

Lloyd's Register  
Foundation

W848-0056