

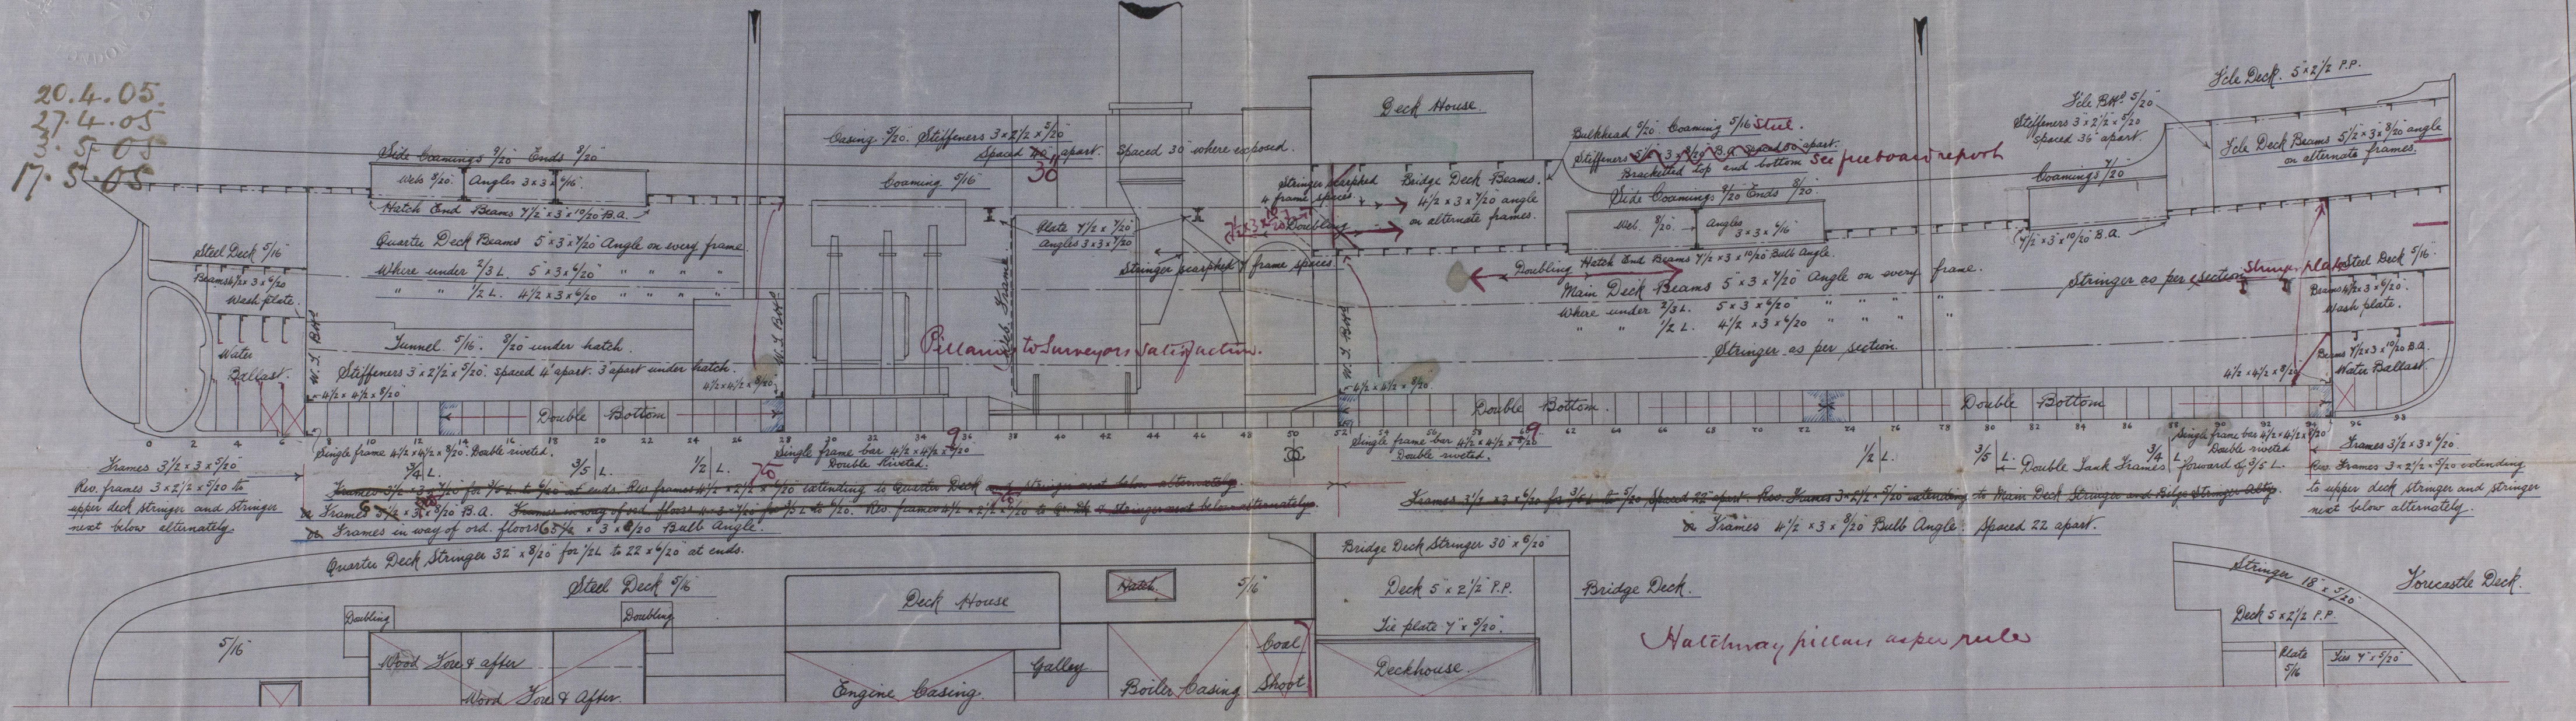


20.4.05.  
27.4.05.  
3.5.05.  
17.5.05.

Alford  
875 = N. 2.2  
"ANTHAM" 2.2  
21211 = N. 4.2 2.2

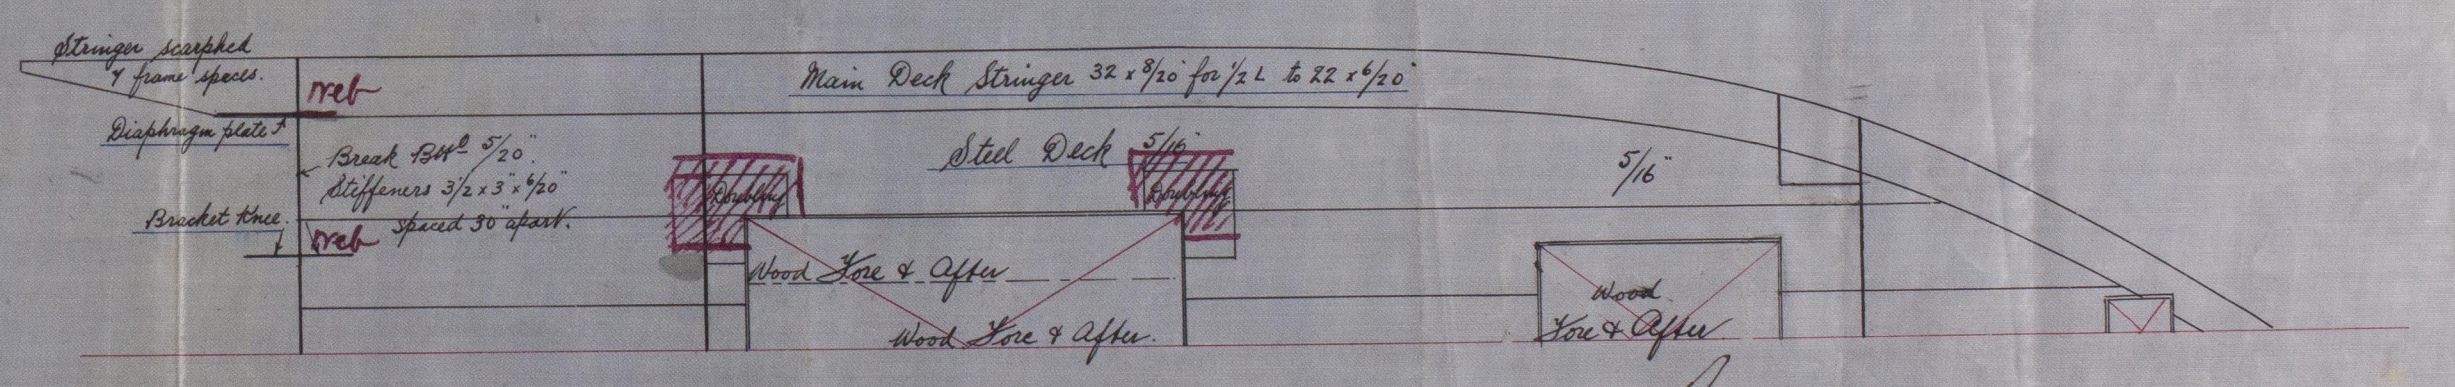

279  
S. S. No. 278  
Profile and Deck Plans.  
Dimensions: - 185'0" B.P.  $\times$  24'0"  $\times$  13'10 1/2" Moulded.  
Scale 1/8" = 1 Foot.

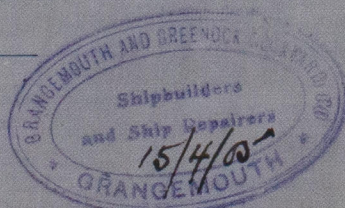

C.B.  
20.4.05.



Profile  
S. S. N<sup>o</sup> 278

Dockyard Co.

Leich

S. S. "MARTHA"  
Lush Rept. N<sup>o</sup> 11213

Leich Rept. N<sup>o</sup> 11213

W848-0059

© 2020

Lloyd's Register  
Foundation