

17/7/24

693. MIDSHIP SECTION.

NUMERALS

bro. 85
 $L(B+D) = 394(\text{APPROX}) \times (51.75 \times 31.75) = 32893$
 $L \times D = 394(\text{APPROX}) \times 31.75 = 12509$
 $D = 394(\text{APPROX}) \div 31.75 = 12.41$
 SHEER FWD 9.0 AFT 5.0'

DIMENSIONS.

$395'0"BP \times 51'9"ML \times 31'9"ML$




CLASS 100 A.I. LLOYDS

EQUIPMENT AS PER RULES

SCALE 1/2"=1'00"

CARRYING PETROLEUM IN BULK

POOP DK LONG 9.0 SPAN CLEAR OF OIL FUEL 2'6" SPACING 5'x3'x30 BA
 IN OIL FUEL SPACE " " " 7'x3'x30 BA

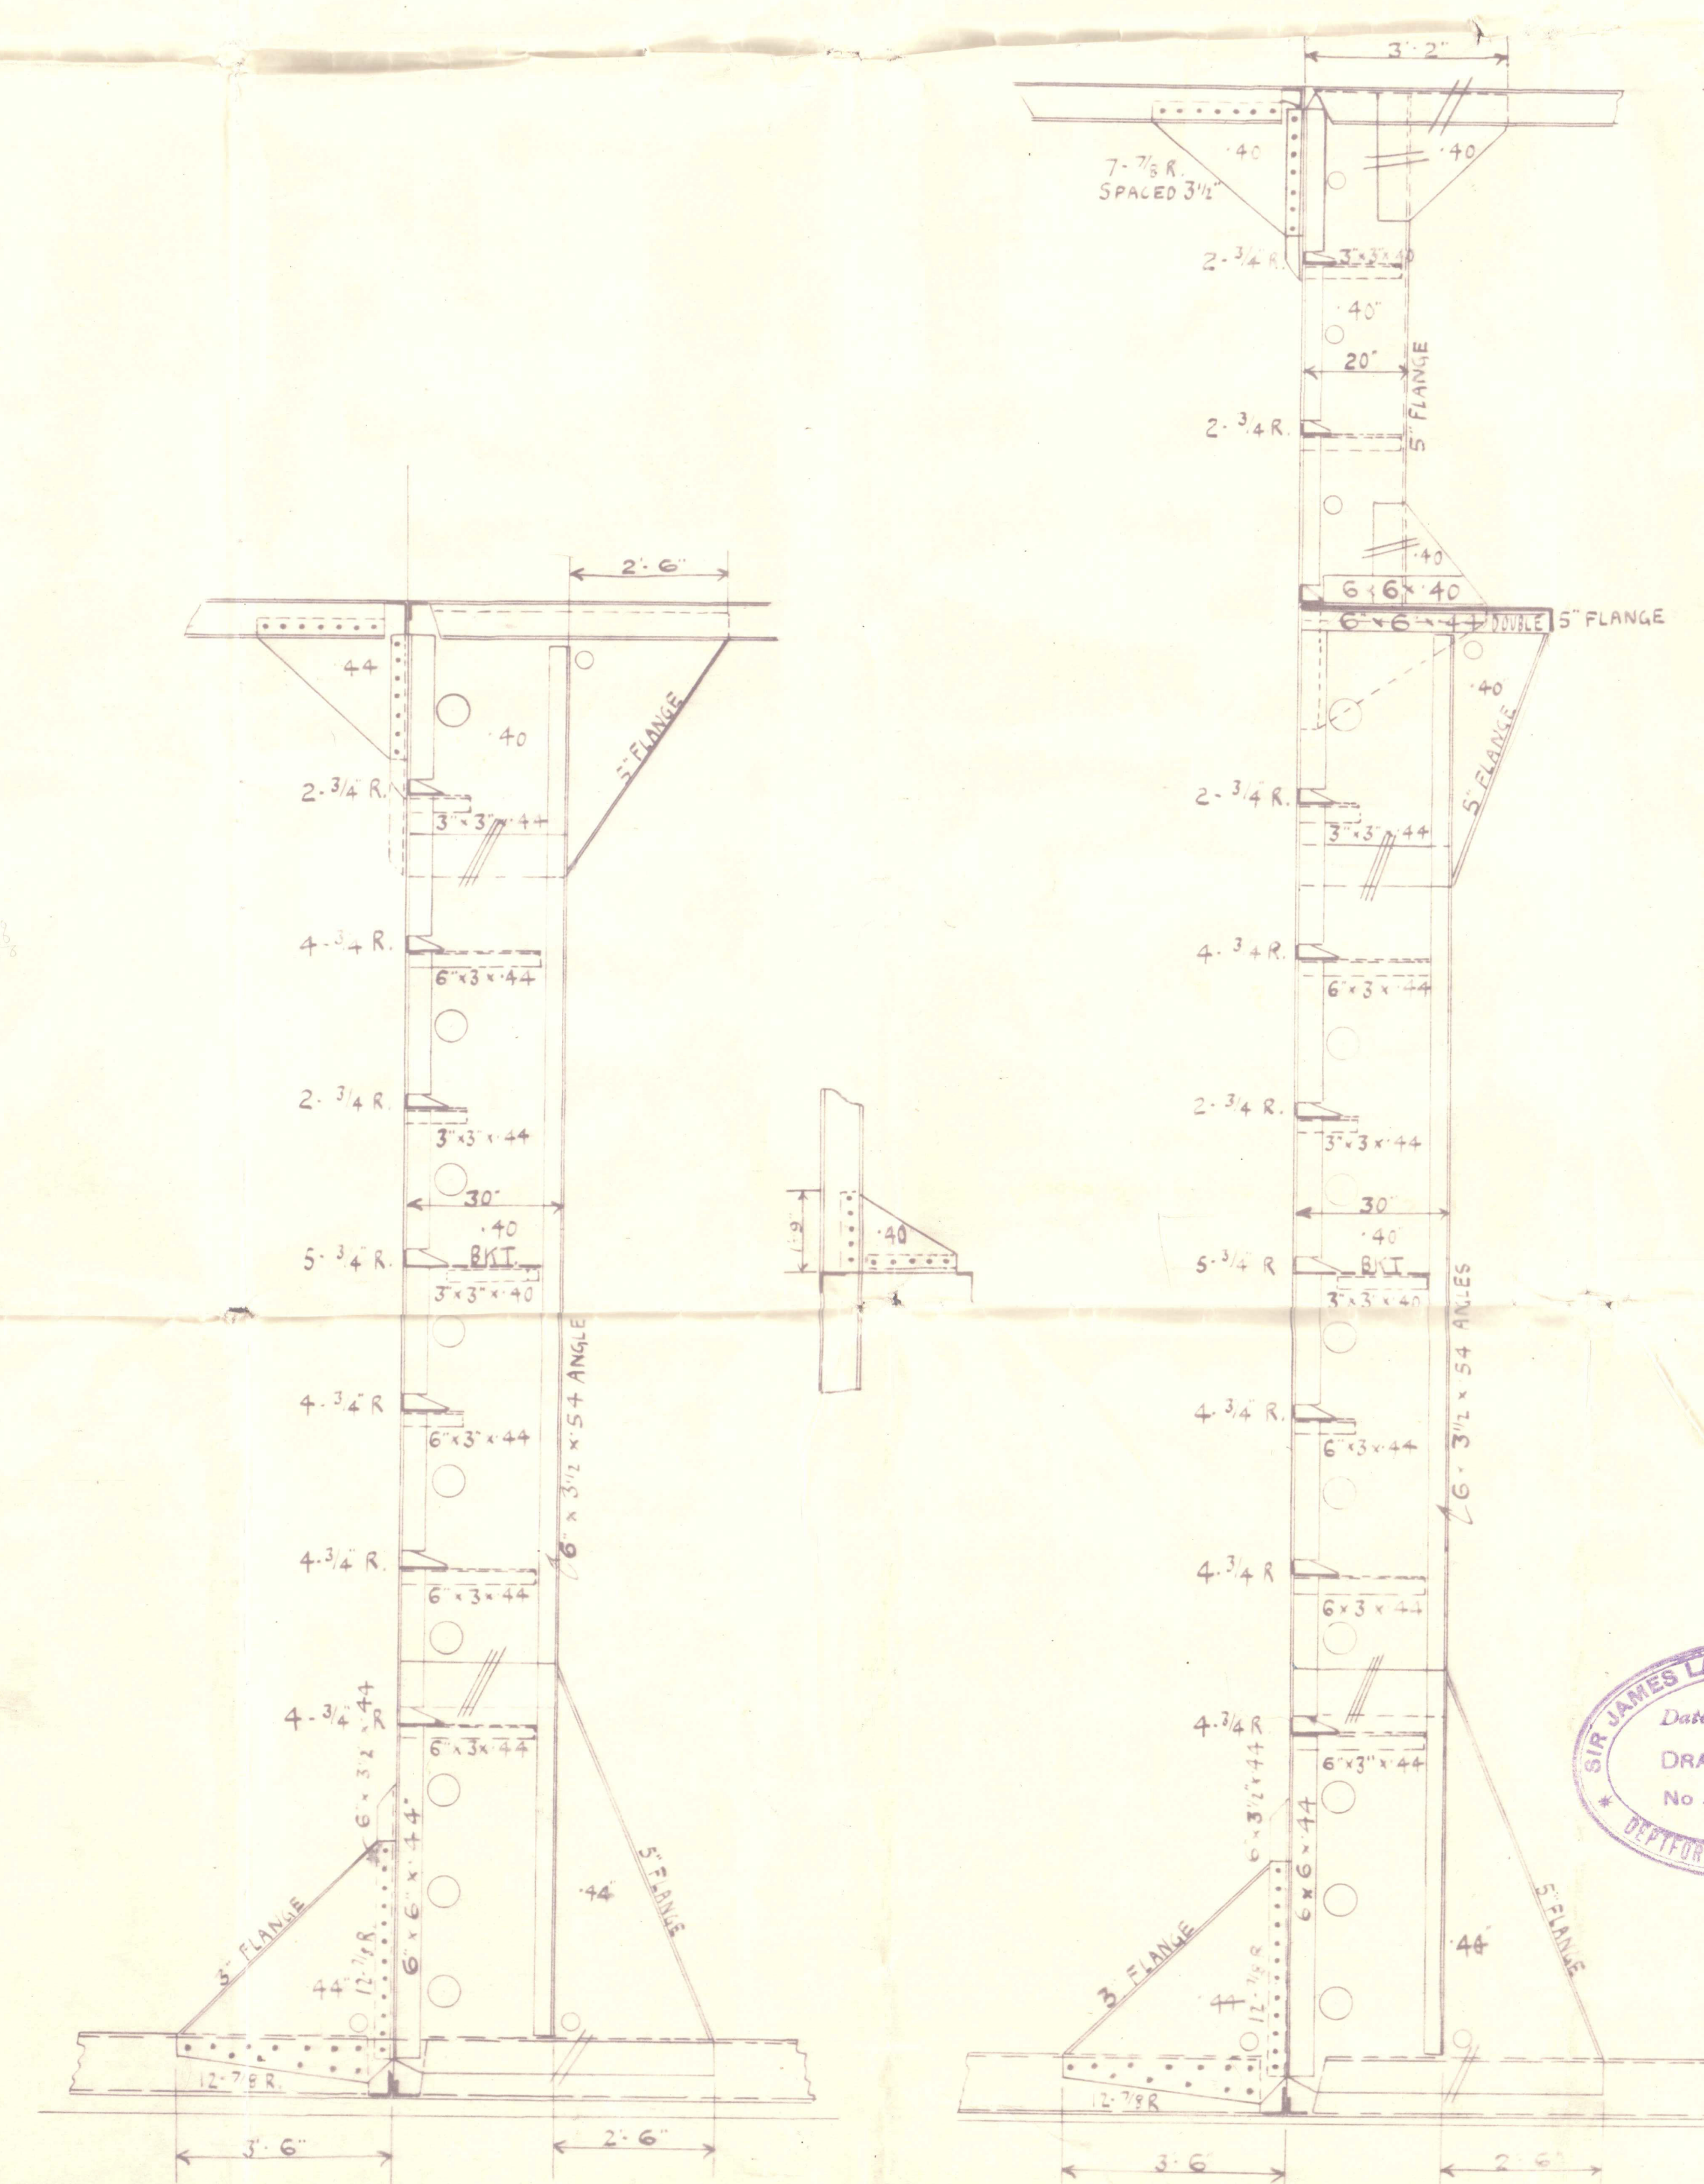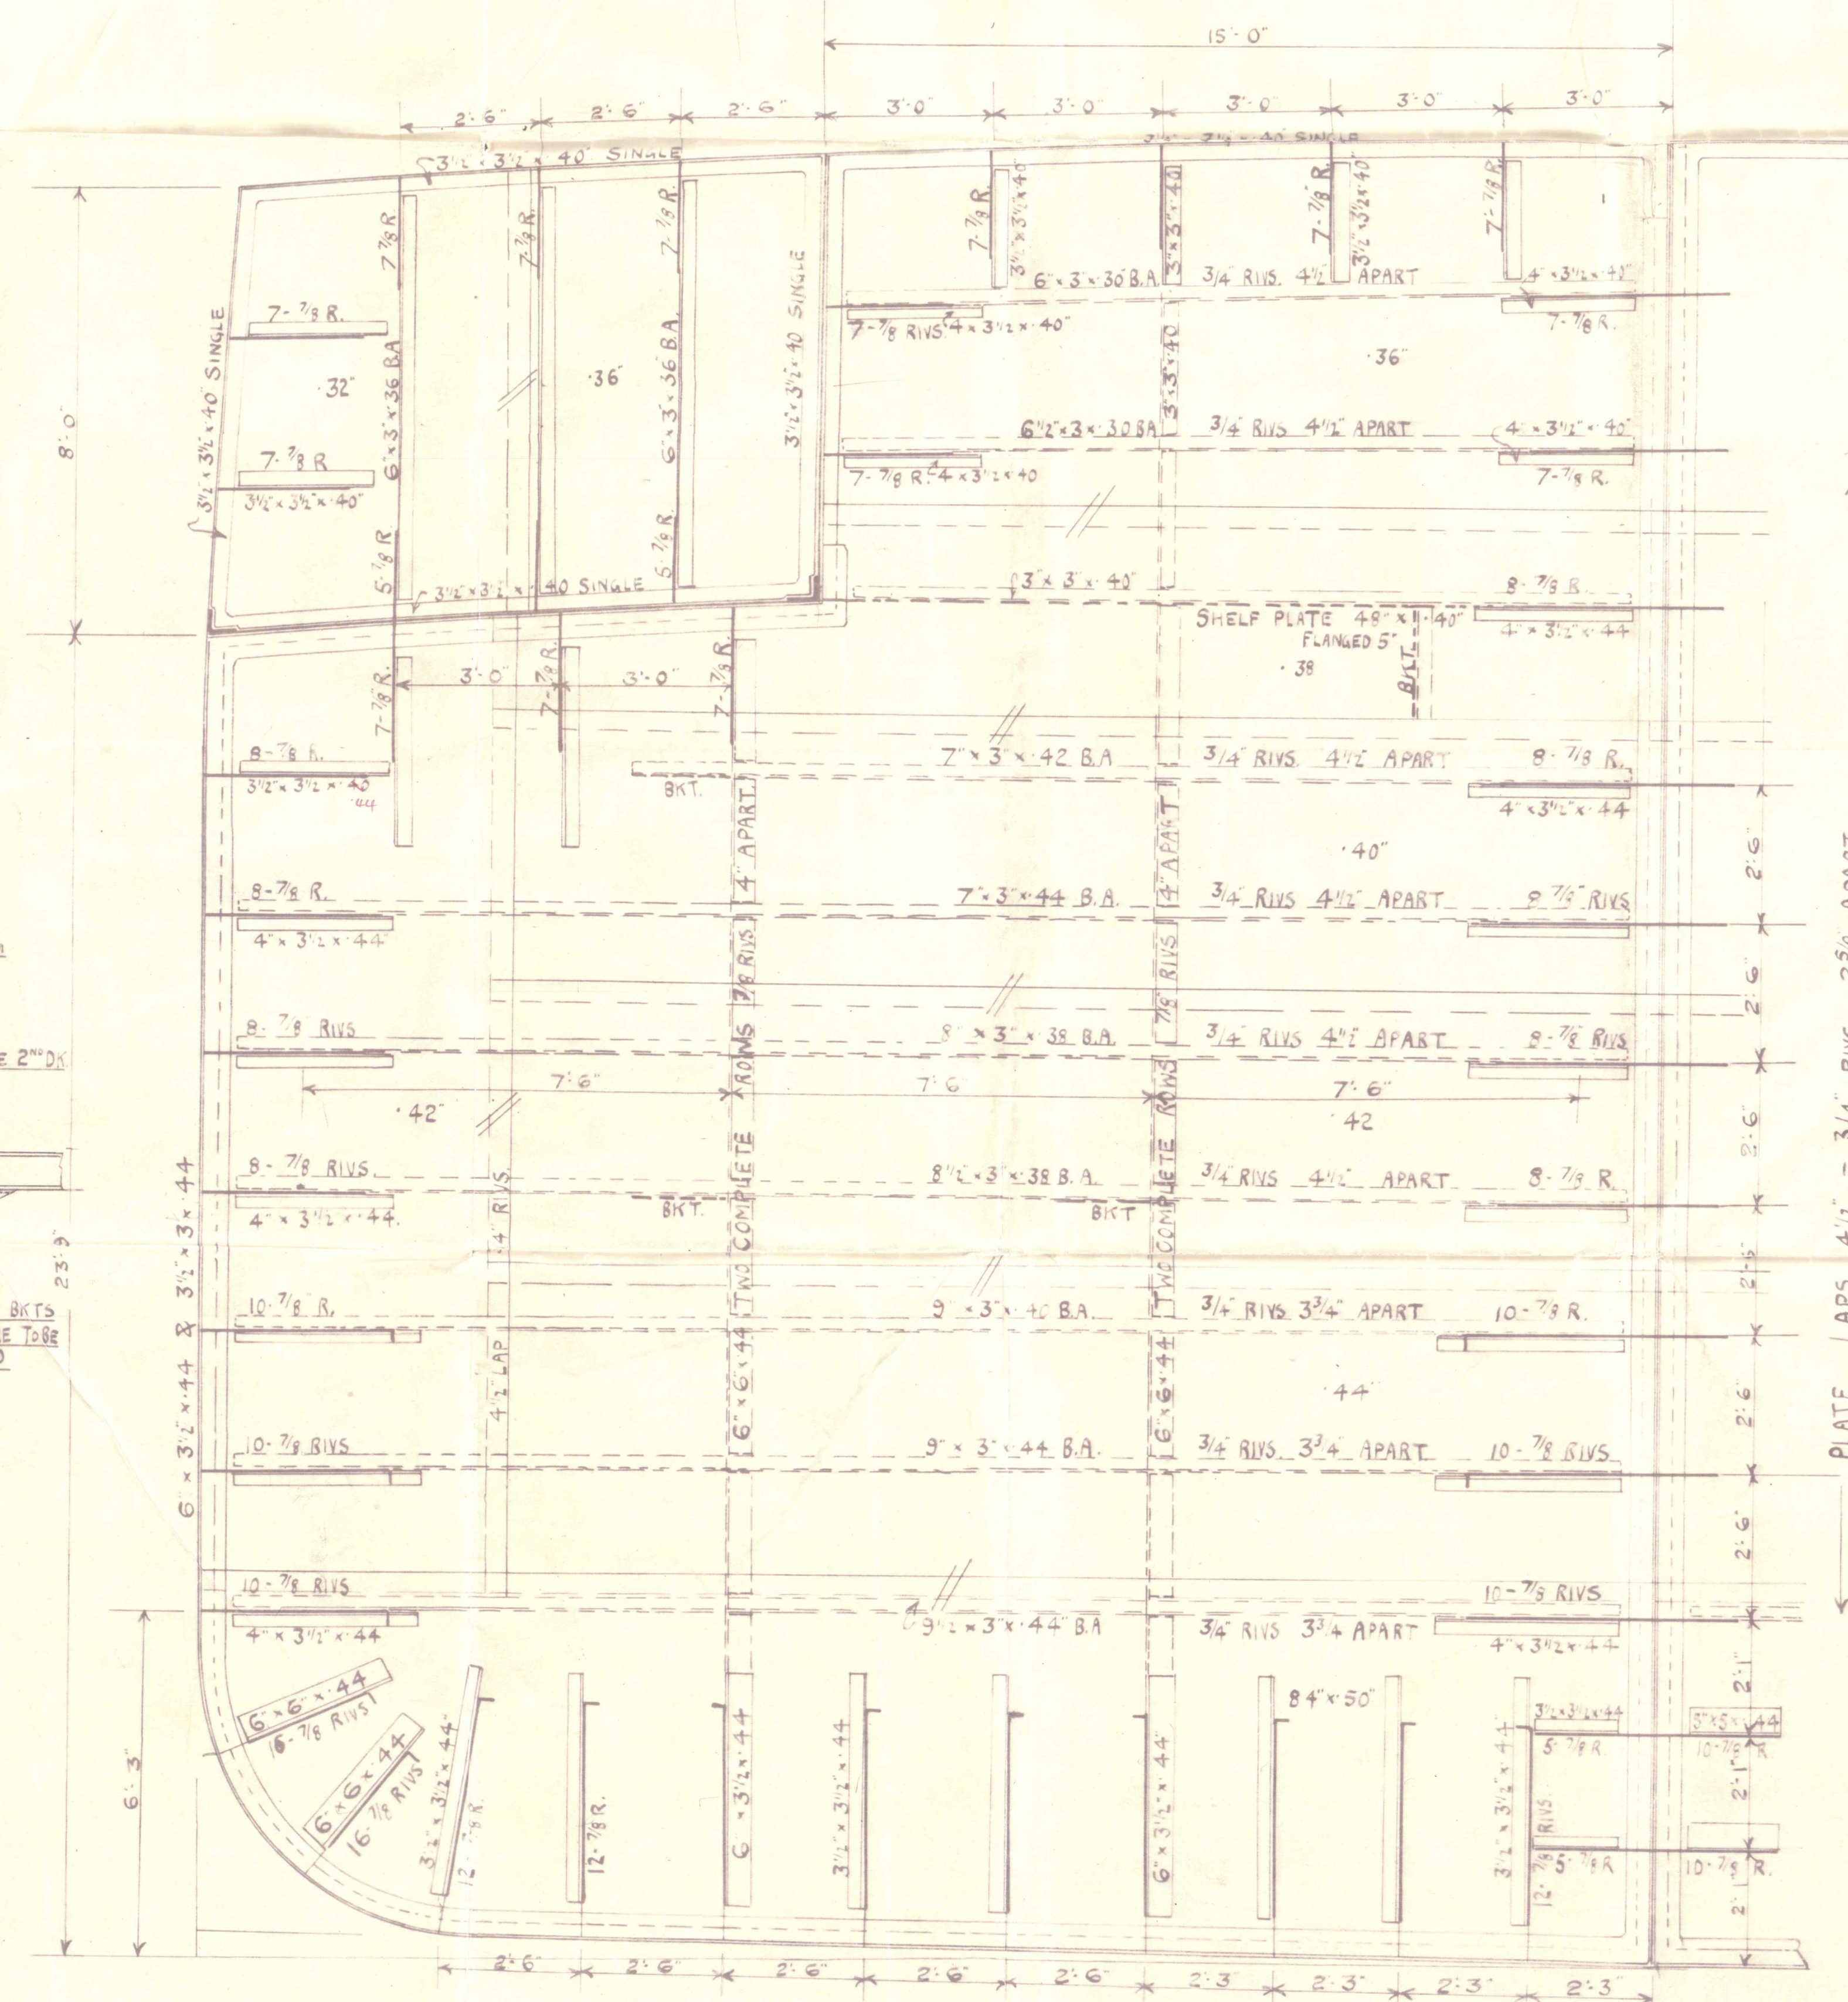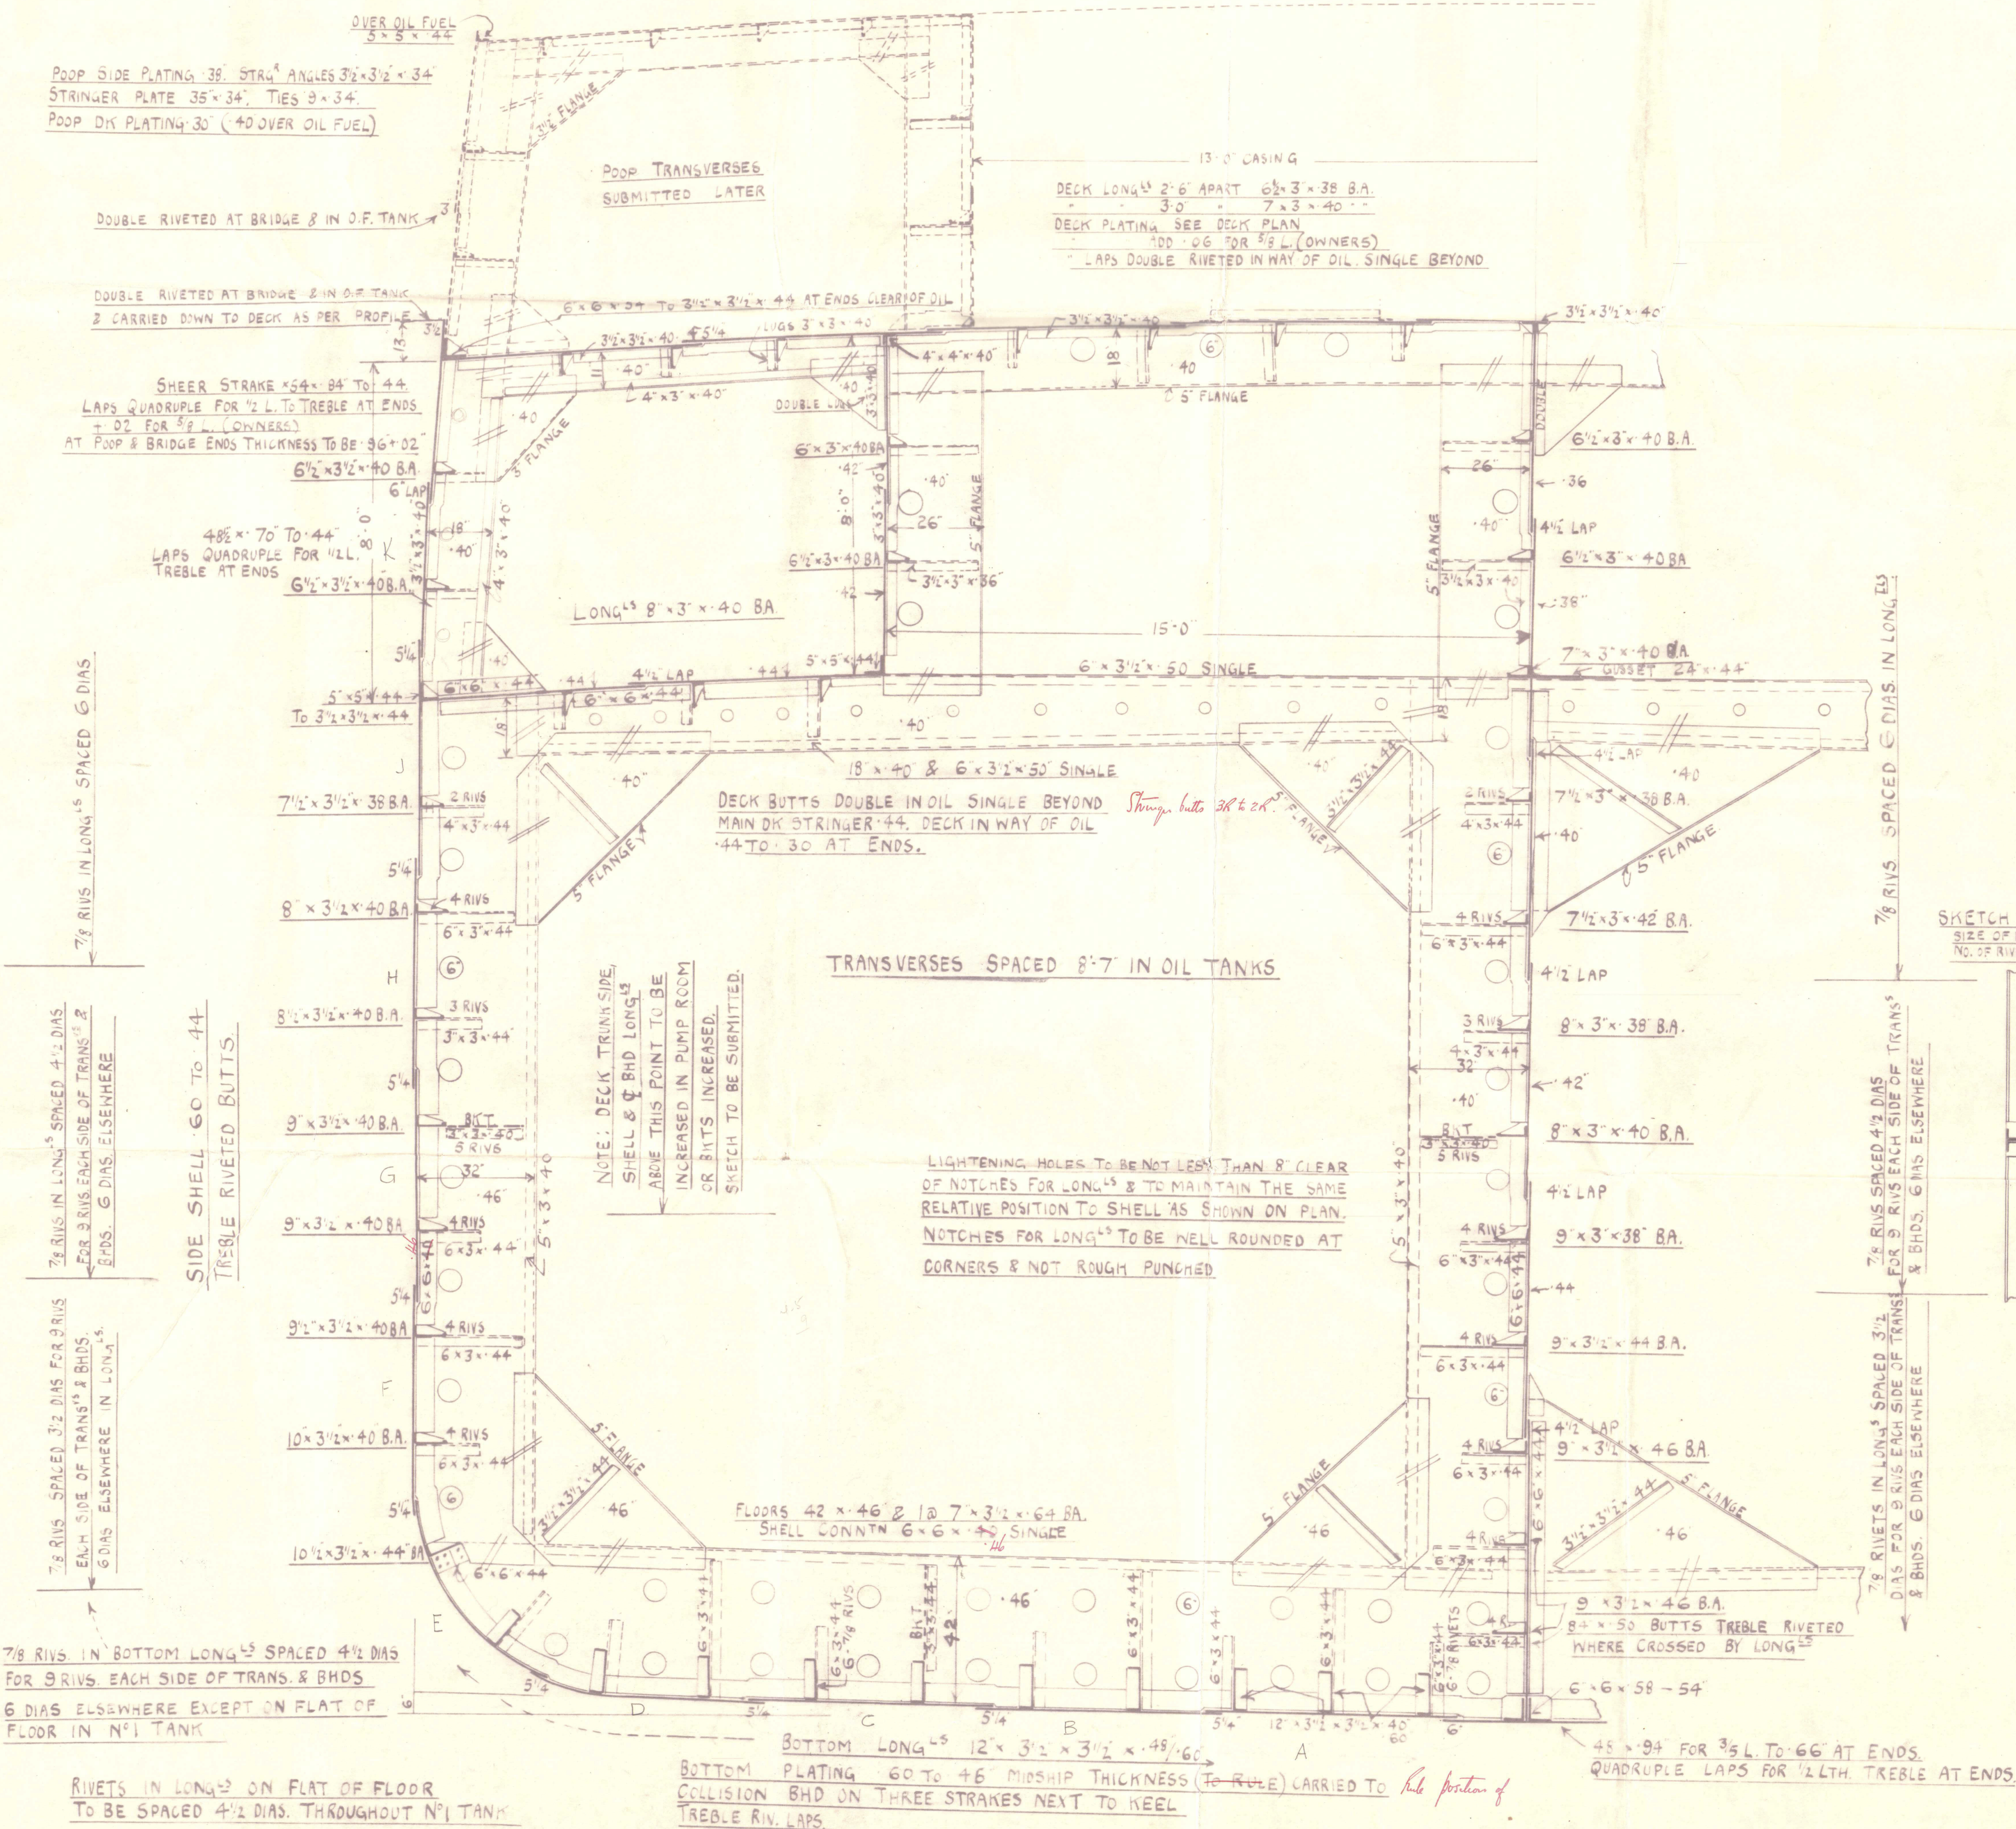


Messrs Sir James Laing & Sons Ltd

No 693

Motor Oil Tanker

Midship Section



SUNDERLAND RPT. NO. 29118.

V/85-0057



© 2020

Lloyd's Register
Foundation