

STEEL BOILER 10-6 EXT DIA 11-6 LONG 120 LBS W.P. LLOYDS

26/3/25




5569/70

SPECIFICATION OF MATERIALS.

SHELL STRAPS CURDERS & MAINSTAYS	28 TO 32 TONS.
BALANCE OF PLATES RIVETS & SCREW STAYS	26 - 30

BOILERS TO BE RIGHT & LEFT HAND.

RIGHT HAND BOILER SHOWN.

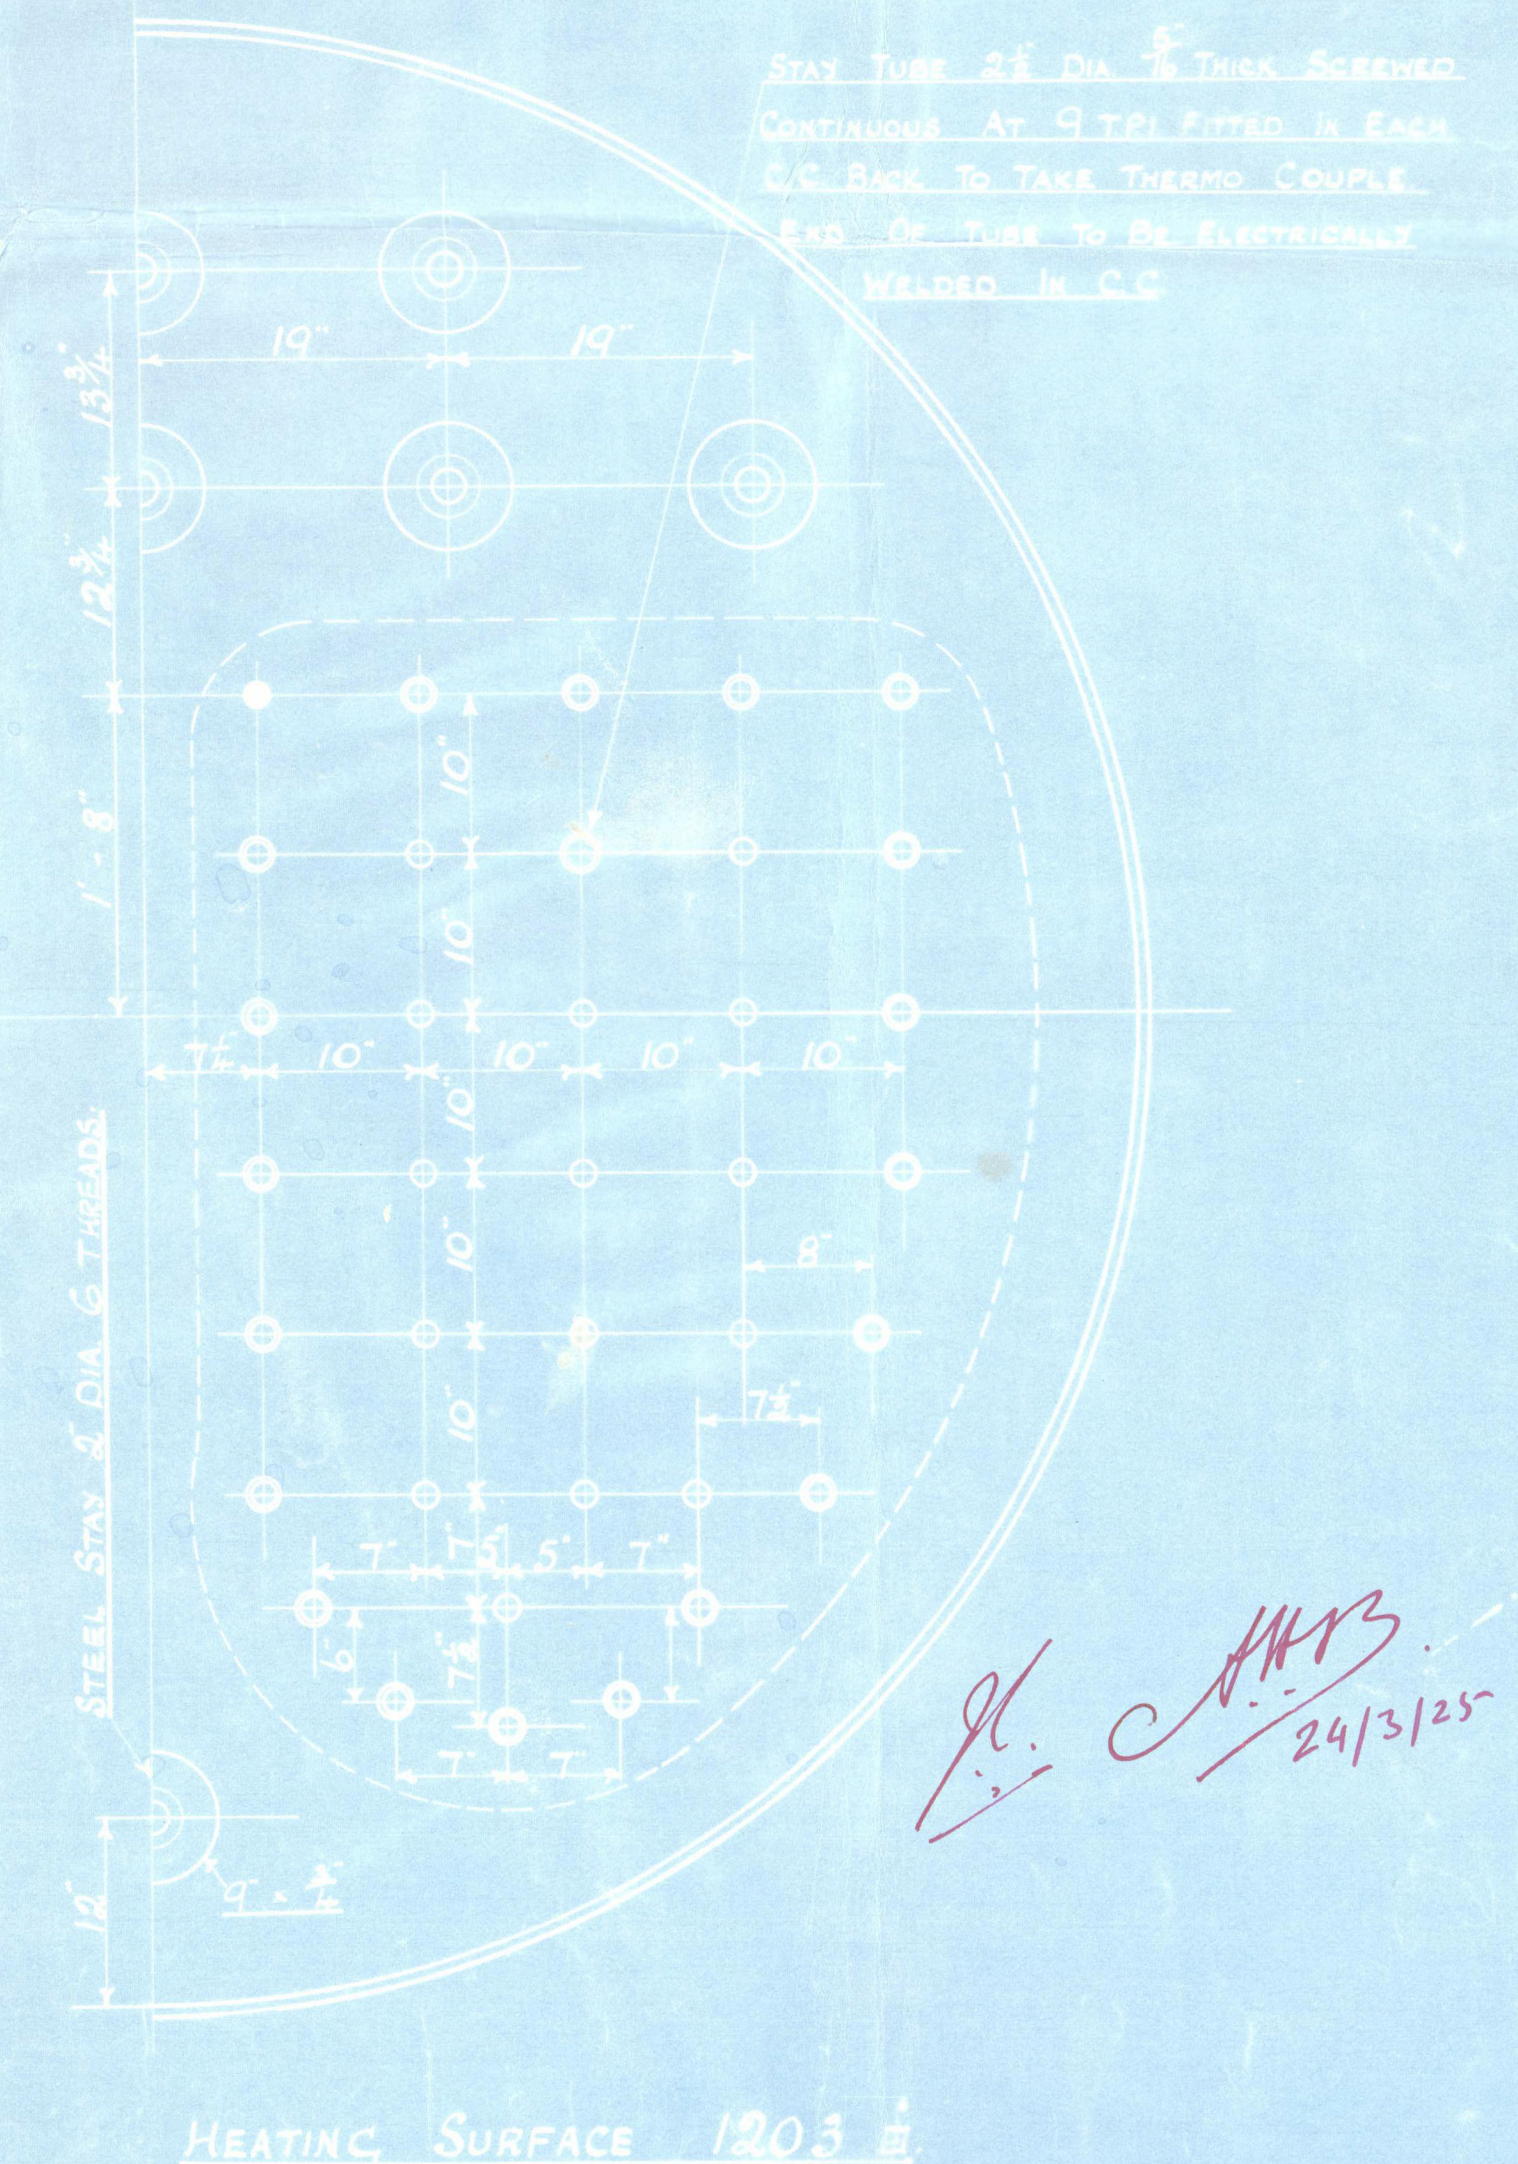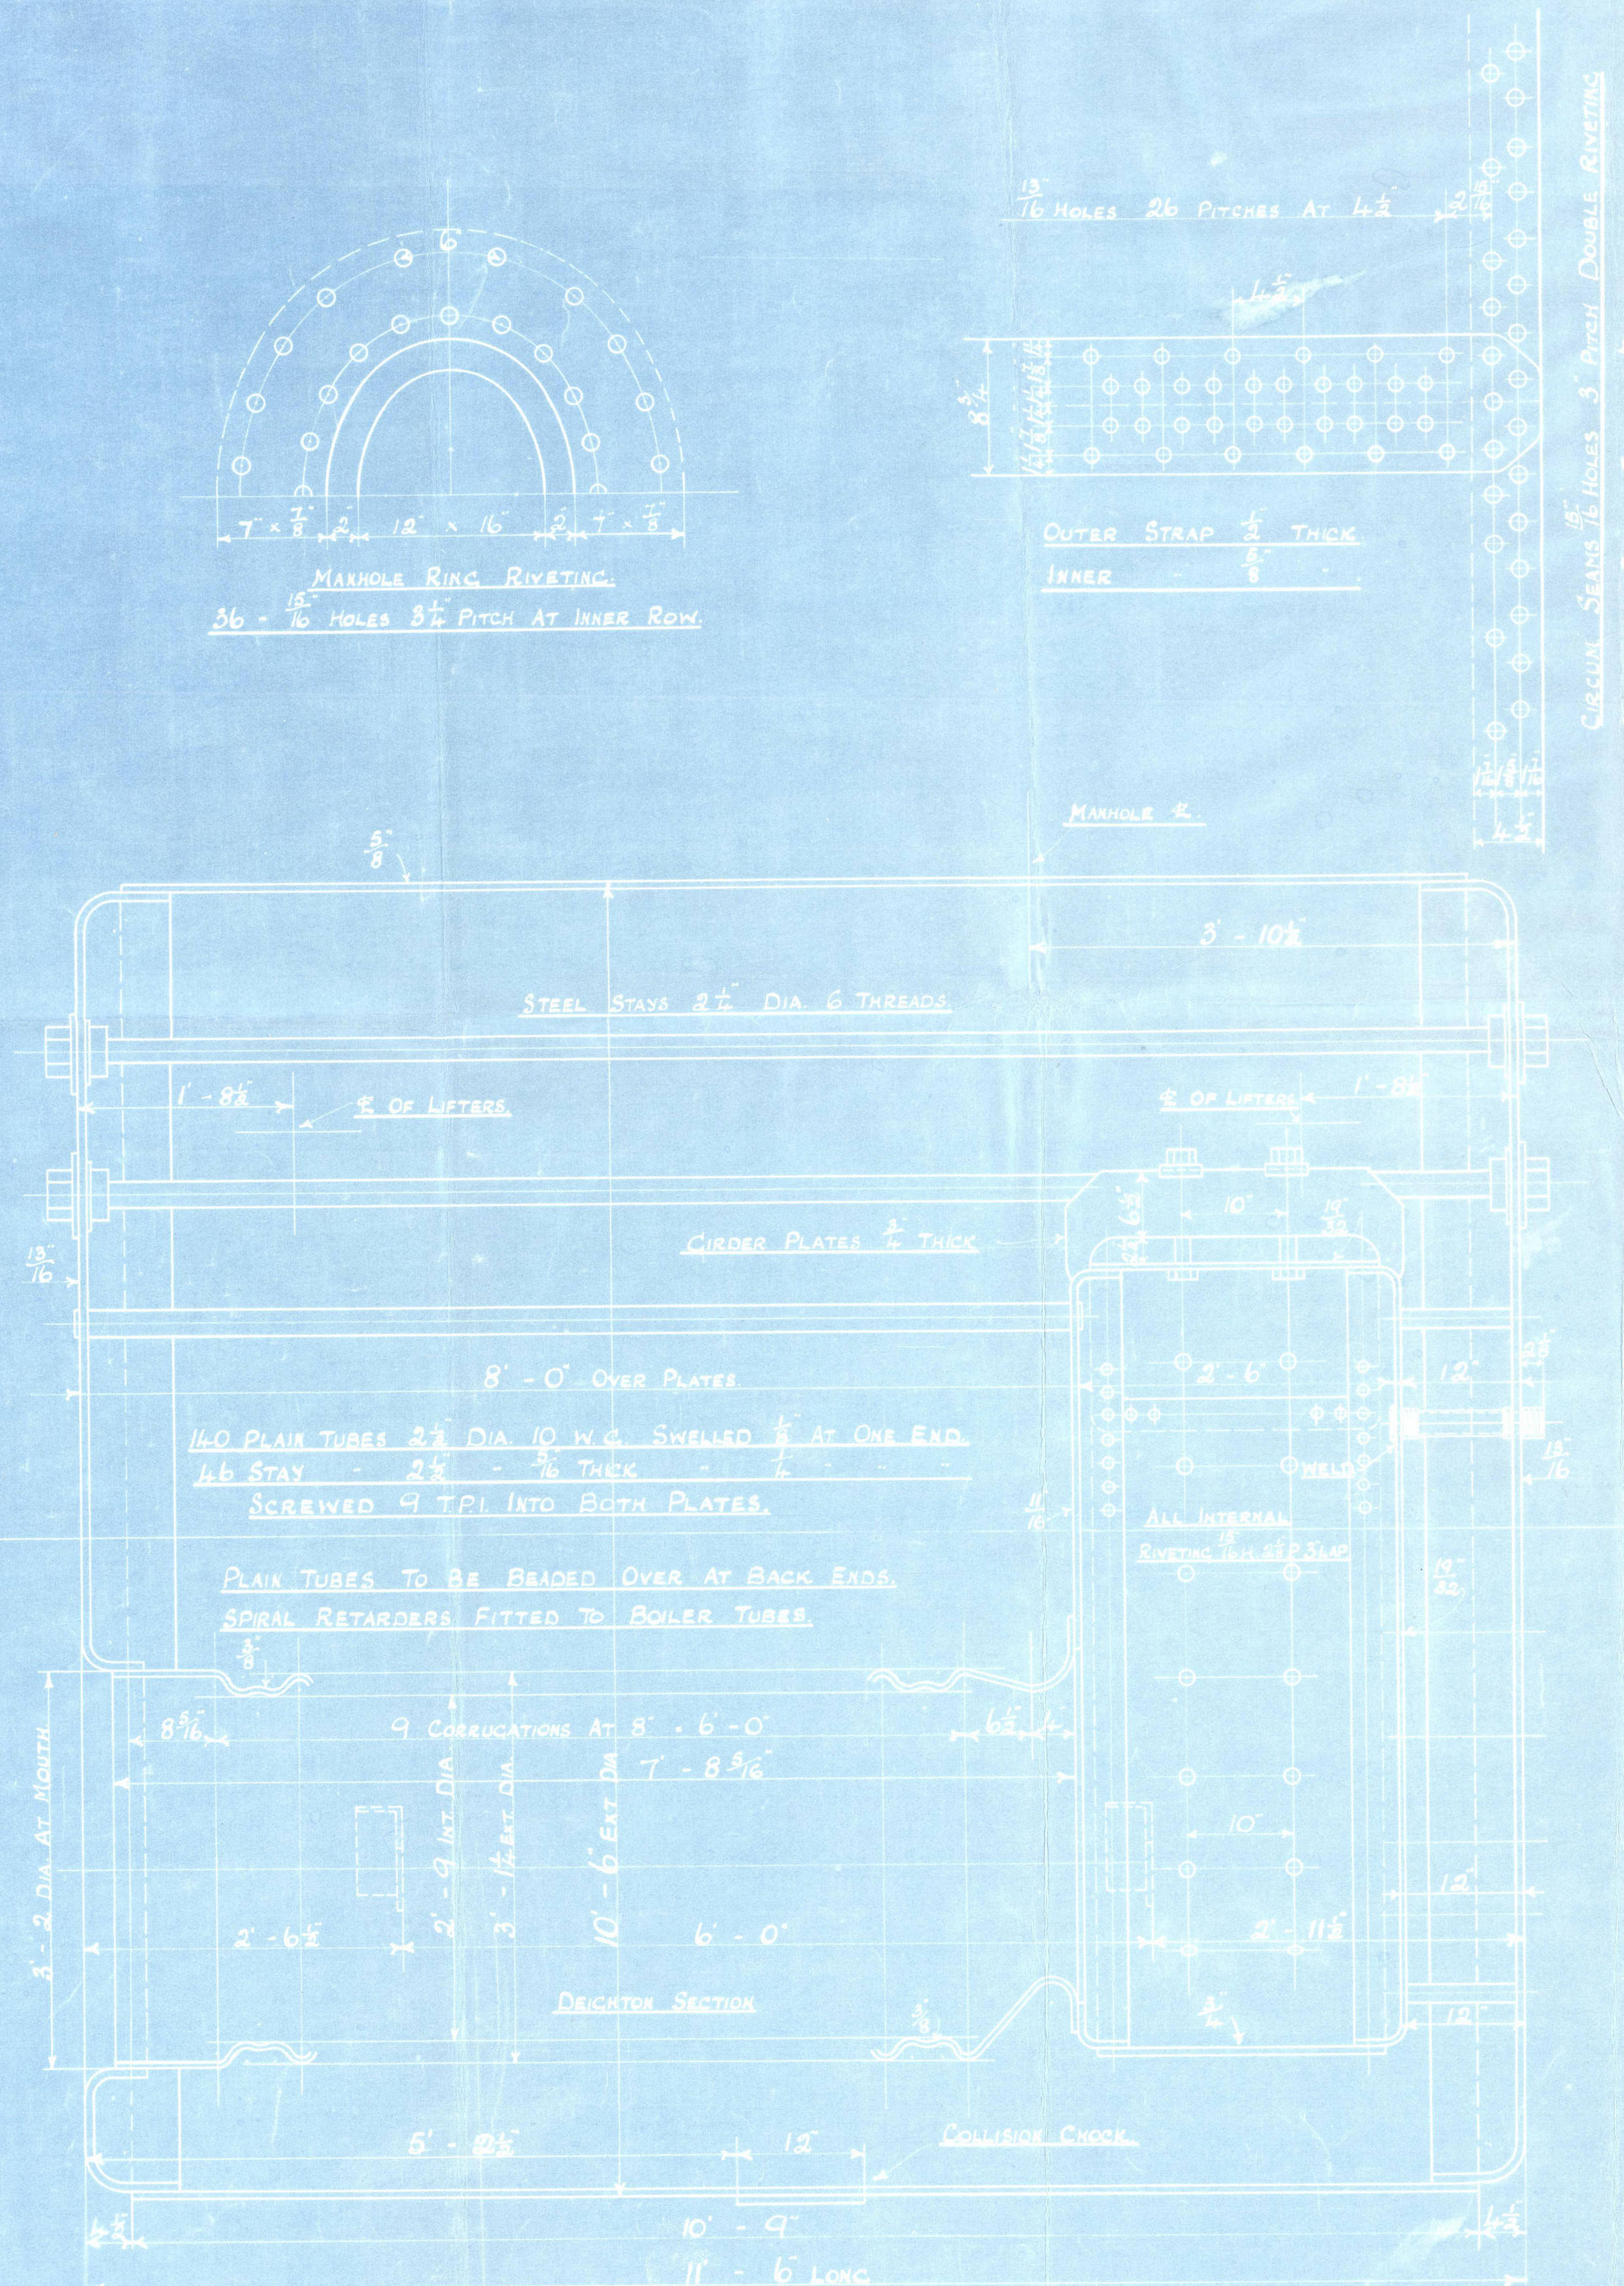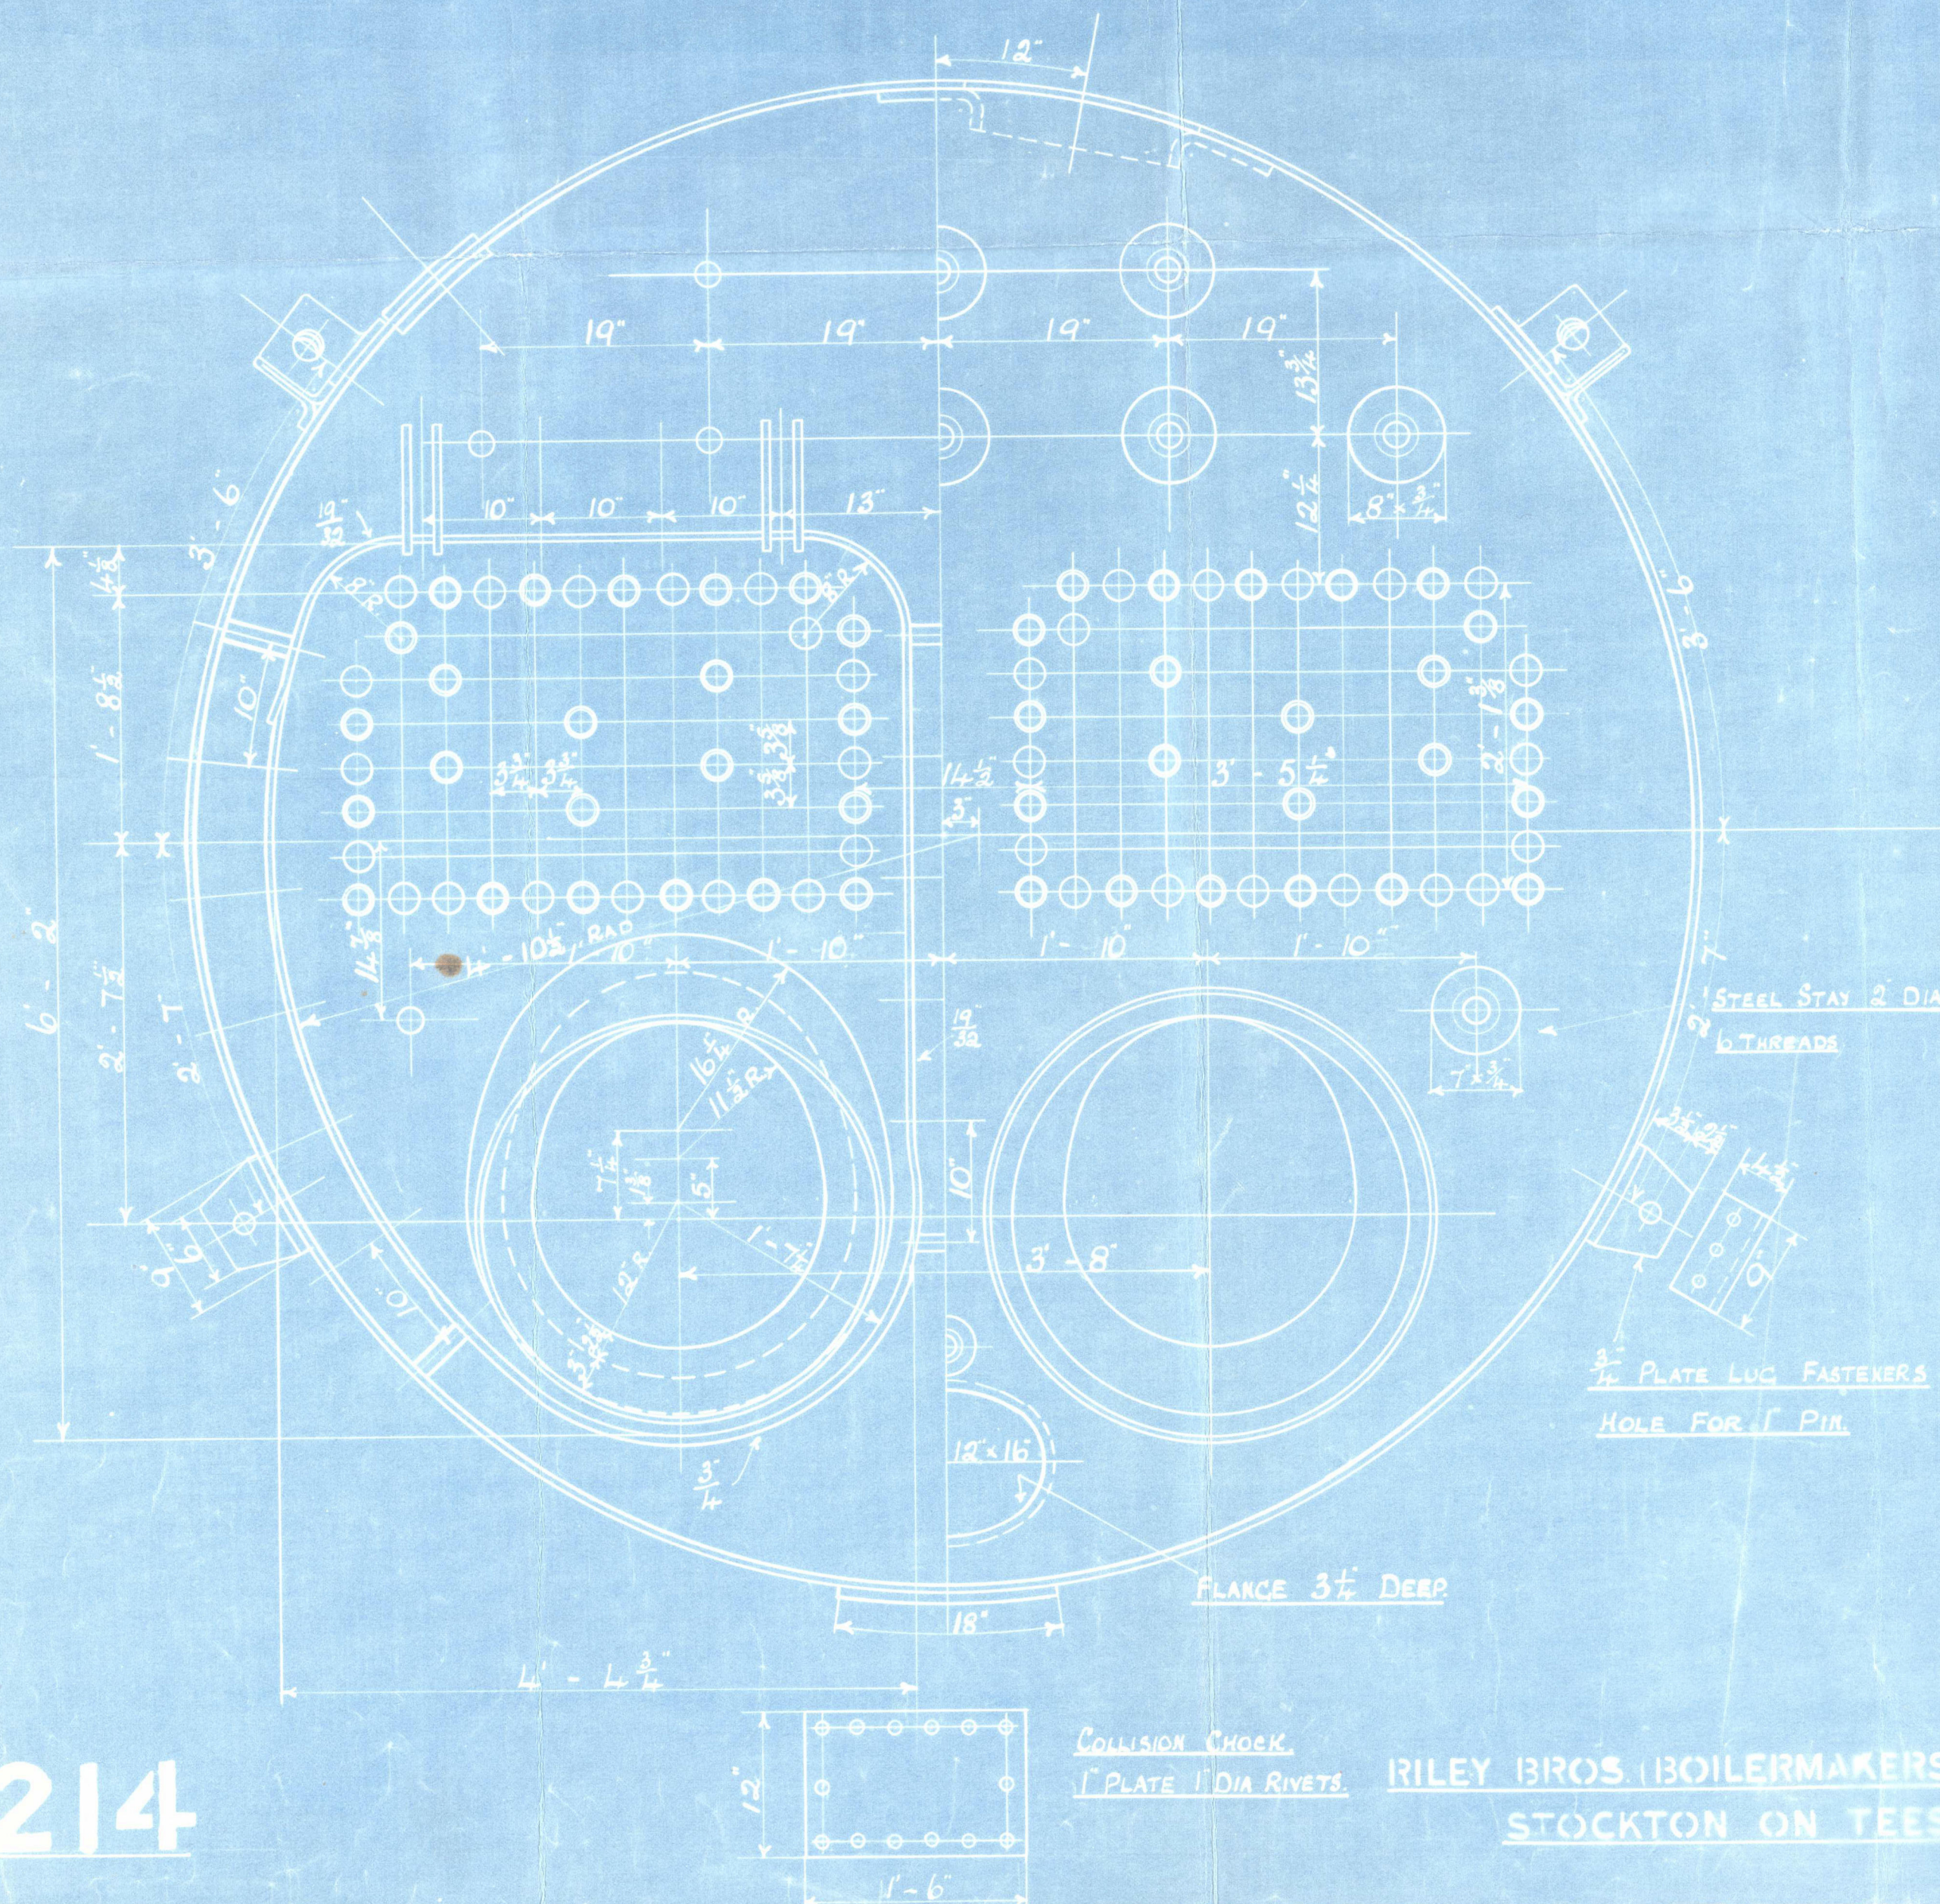

24/3/25

Piley Bros Bailers

5569-70

Copy of Plan

Approved 18/12/24

Showing proposal
to fit Thermo Couples
in lieu of a screw
stay in Combustion
chambers.


Udd. Report. 12344.

M/ Pyrafield -

BUNDERLAND RPT. NO. 29118.



W85-0059

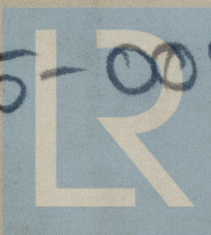

© 2020

Lloyd's Register
Foundation