



356.5 B.P. 49.96 MLD 23.99 MLD.

— EQUIPMENT —

3 BOWERS. COLL. WEIGHT 149½ CWTs. STOCKLESS
1 STREAM ANCHOR 14 CWTs EX STOCK.
1 KEDGE -Do- -Do- -Do- ✓
270 FATHOMS 2½ SAUD CHAIN CABLE ✓
90 " 4½ STEEL WIRE. ✓
120 " 4½ -Do- ✓
FOUR 90 FATHOMS 2½ -Do- ✓
OWNERS CONSENT
TO STEEL WIRE

OWNERS CONSENT
TO STEEL WIRE

SCALE $\frac{1}{2} = 1 \text{ FOOT}$

C.7.
21/4/10

19.4.10









Mess^{rs} Wm. Doreford & Sons L^d.

No. 418

Amended Midship Section

S.S. "MOORLANDS"

Sl^d. Report No 24592.

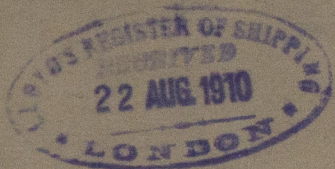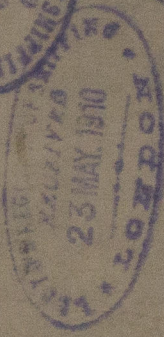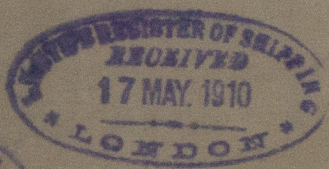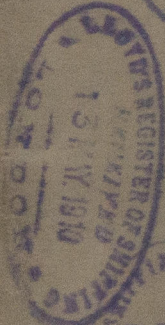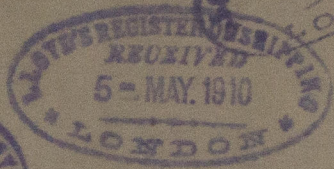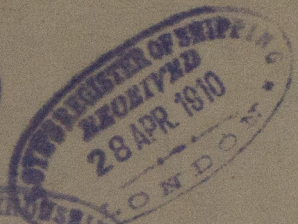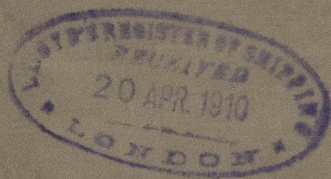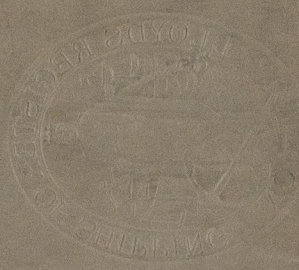

© 2020

Lloyd's Register
Foundation
W850-0024