
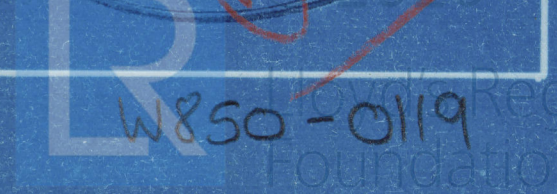
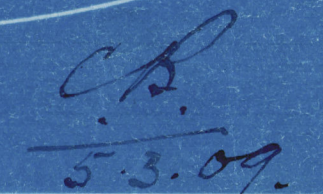


LENGTH BP. 249-0. BROTH MLD 39-10
EXT. 41-9 DEPTH MLD 20-4 1/2
CLASS BS* BRITISH CORPORATION. 100.A1. LLOYDS


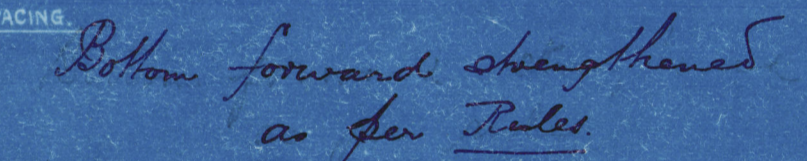


Messrs. Watson & Graham & Co

Amended Profile

No 146 ship

S.S. "MONITORIA"

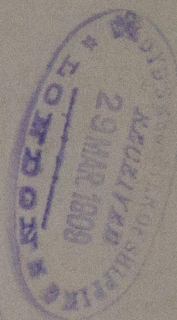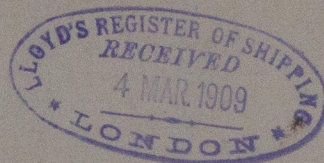

S.L.O. REPORT No. 24189

RETAIN



© 2020

Lloyd's Register
Foundation
W850-0119