

PATENTED DESIGN.

LENGTH B.P. 279'-0" BREADTH MLD 39'-10" DEPTH MLD 20'-7 1/2"


CLASS	BS*	BRITISH CORPORATION
"	100.A.I.	LLOYDS.

From Captain Graham & Co


Amended Shipping Section

No 146 ship

S.S. "MONITORIA"

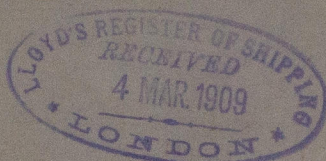

See Report No. 24189

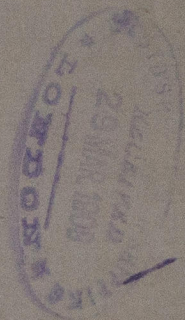

OSBOURNE, GRAHAM & CO.
SHIPBUILDERS,
HYLTON,
SUNDERLAND.

RETAIN



© 2020

Lloyd's Register
Foundation

W850-0122