

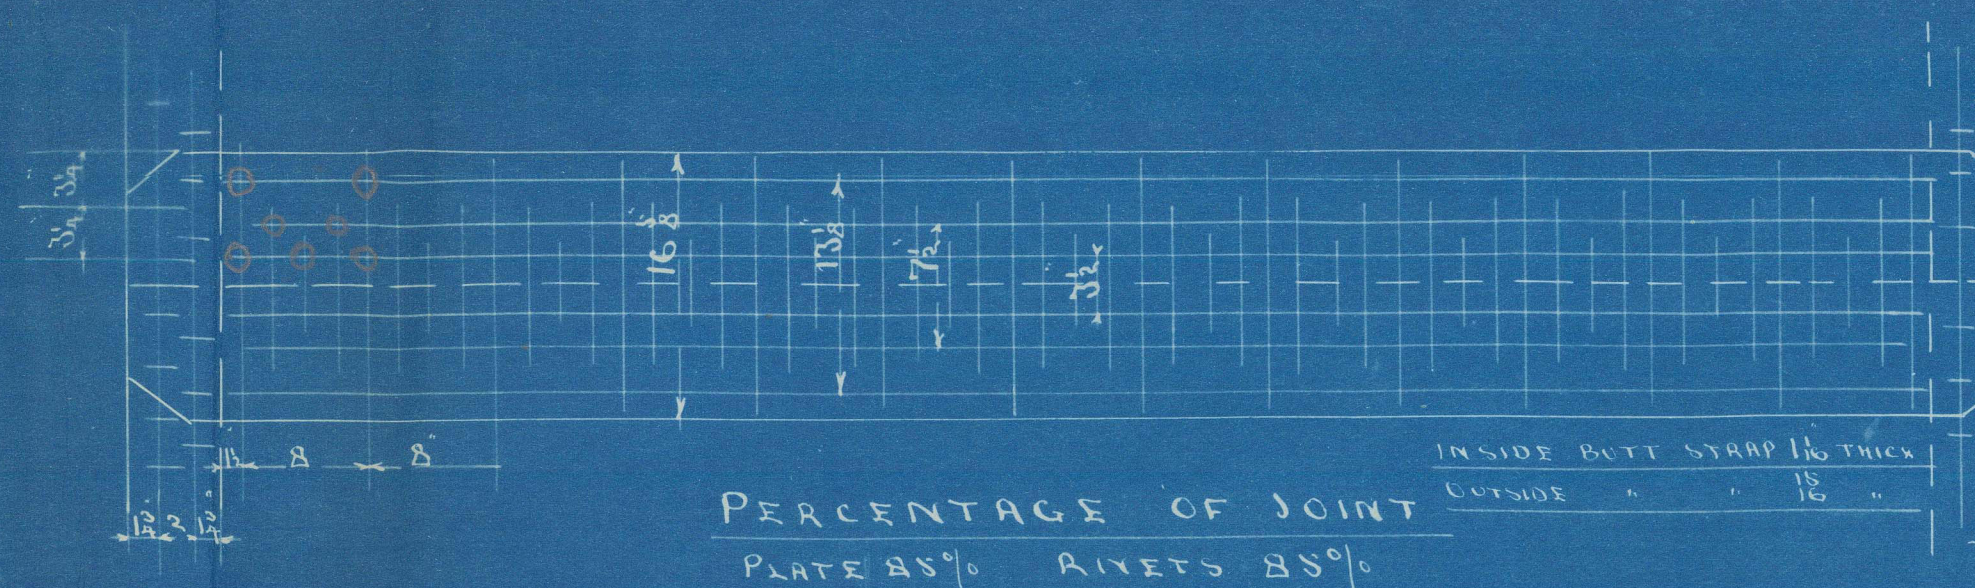
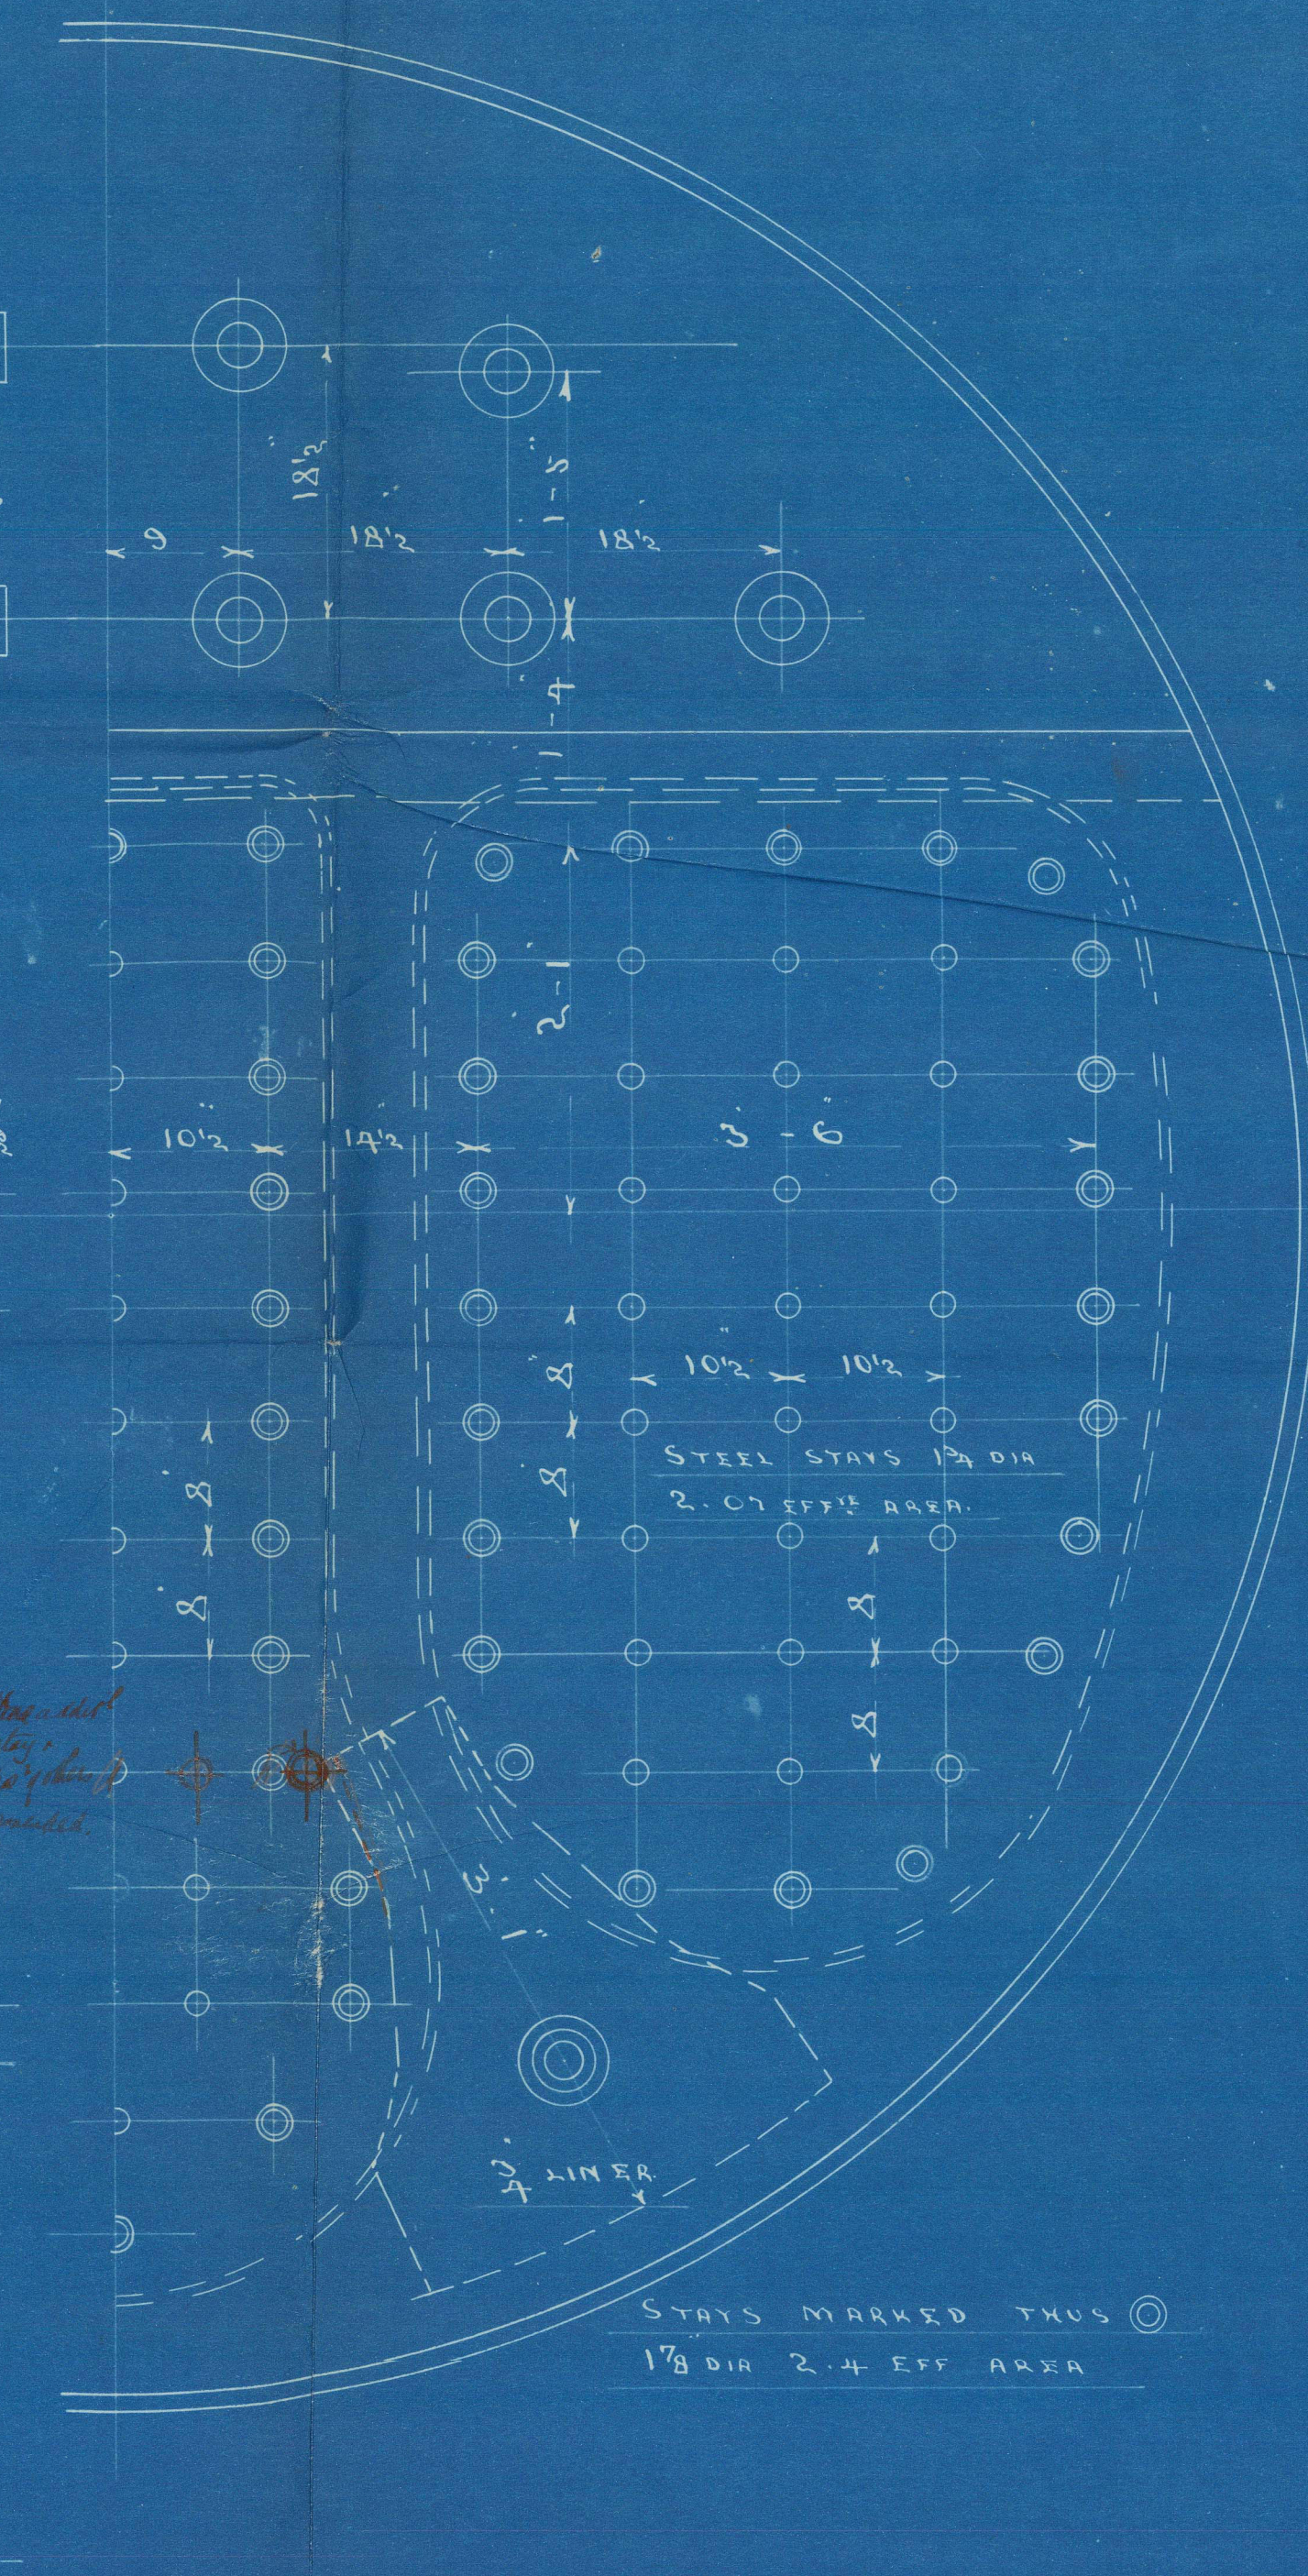


DIMENSIONS	
LENGTH OF FIRE BARS	5-0
AREA OF FIRE GRATE	78.4
DIAM OF TUBES OUTSIDE	3.2
LENGTH OF TUBES OVER PLATES	6-7
Nº OF TUBES	170
SURFACE OF TUBES	1008
TOTAL HEATING SURFACE	1333.4
WORKING PRESSURE	2.00
DIAM OF SAFETY VALVE	2.12

PARTICULARS OF RIVETTING  
 SHELL: LONGITUDINAL JOINT TO BE TREBLE RIVETTED DOUBLE BUTT  
 JOINT HOLES DRILLED 1 1/8" DIAM 8" PITCH  
 CIRCUMFERENTIAL JOINT TO BE DOUBLE RIVETTED LAP JOINT  
 HOLES DRILLED 1 1/8" DIAM 3 1/4" PITCH  
 FURNACES: SINGLE RIVETTED  
 COMB CHAMBER: SINGLE RIVETTED EXCEPT BOTTOM DOUBLE  
 RIVETTED TO TUBE PLATE  
 END PLATES: CROSS SEAMS DOUBLE RIVETTED LAP JOINTS

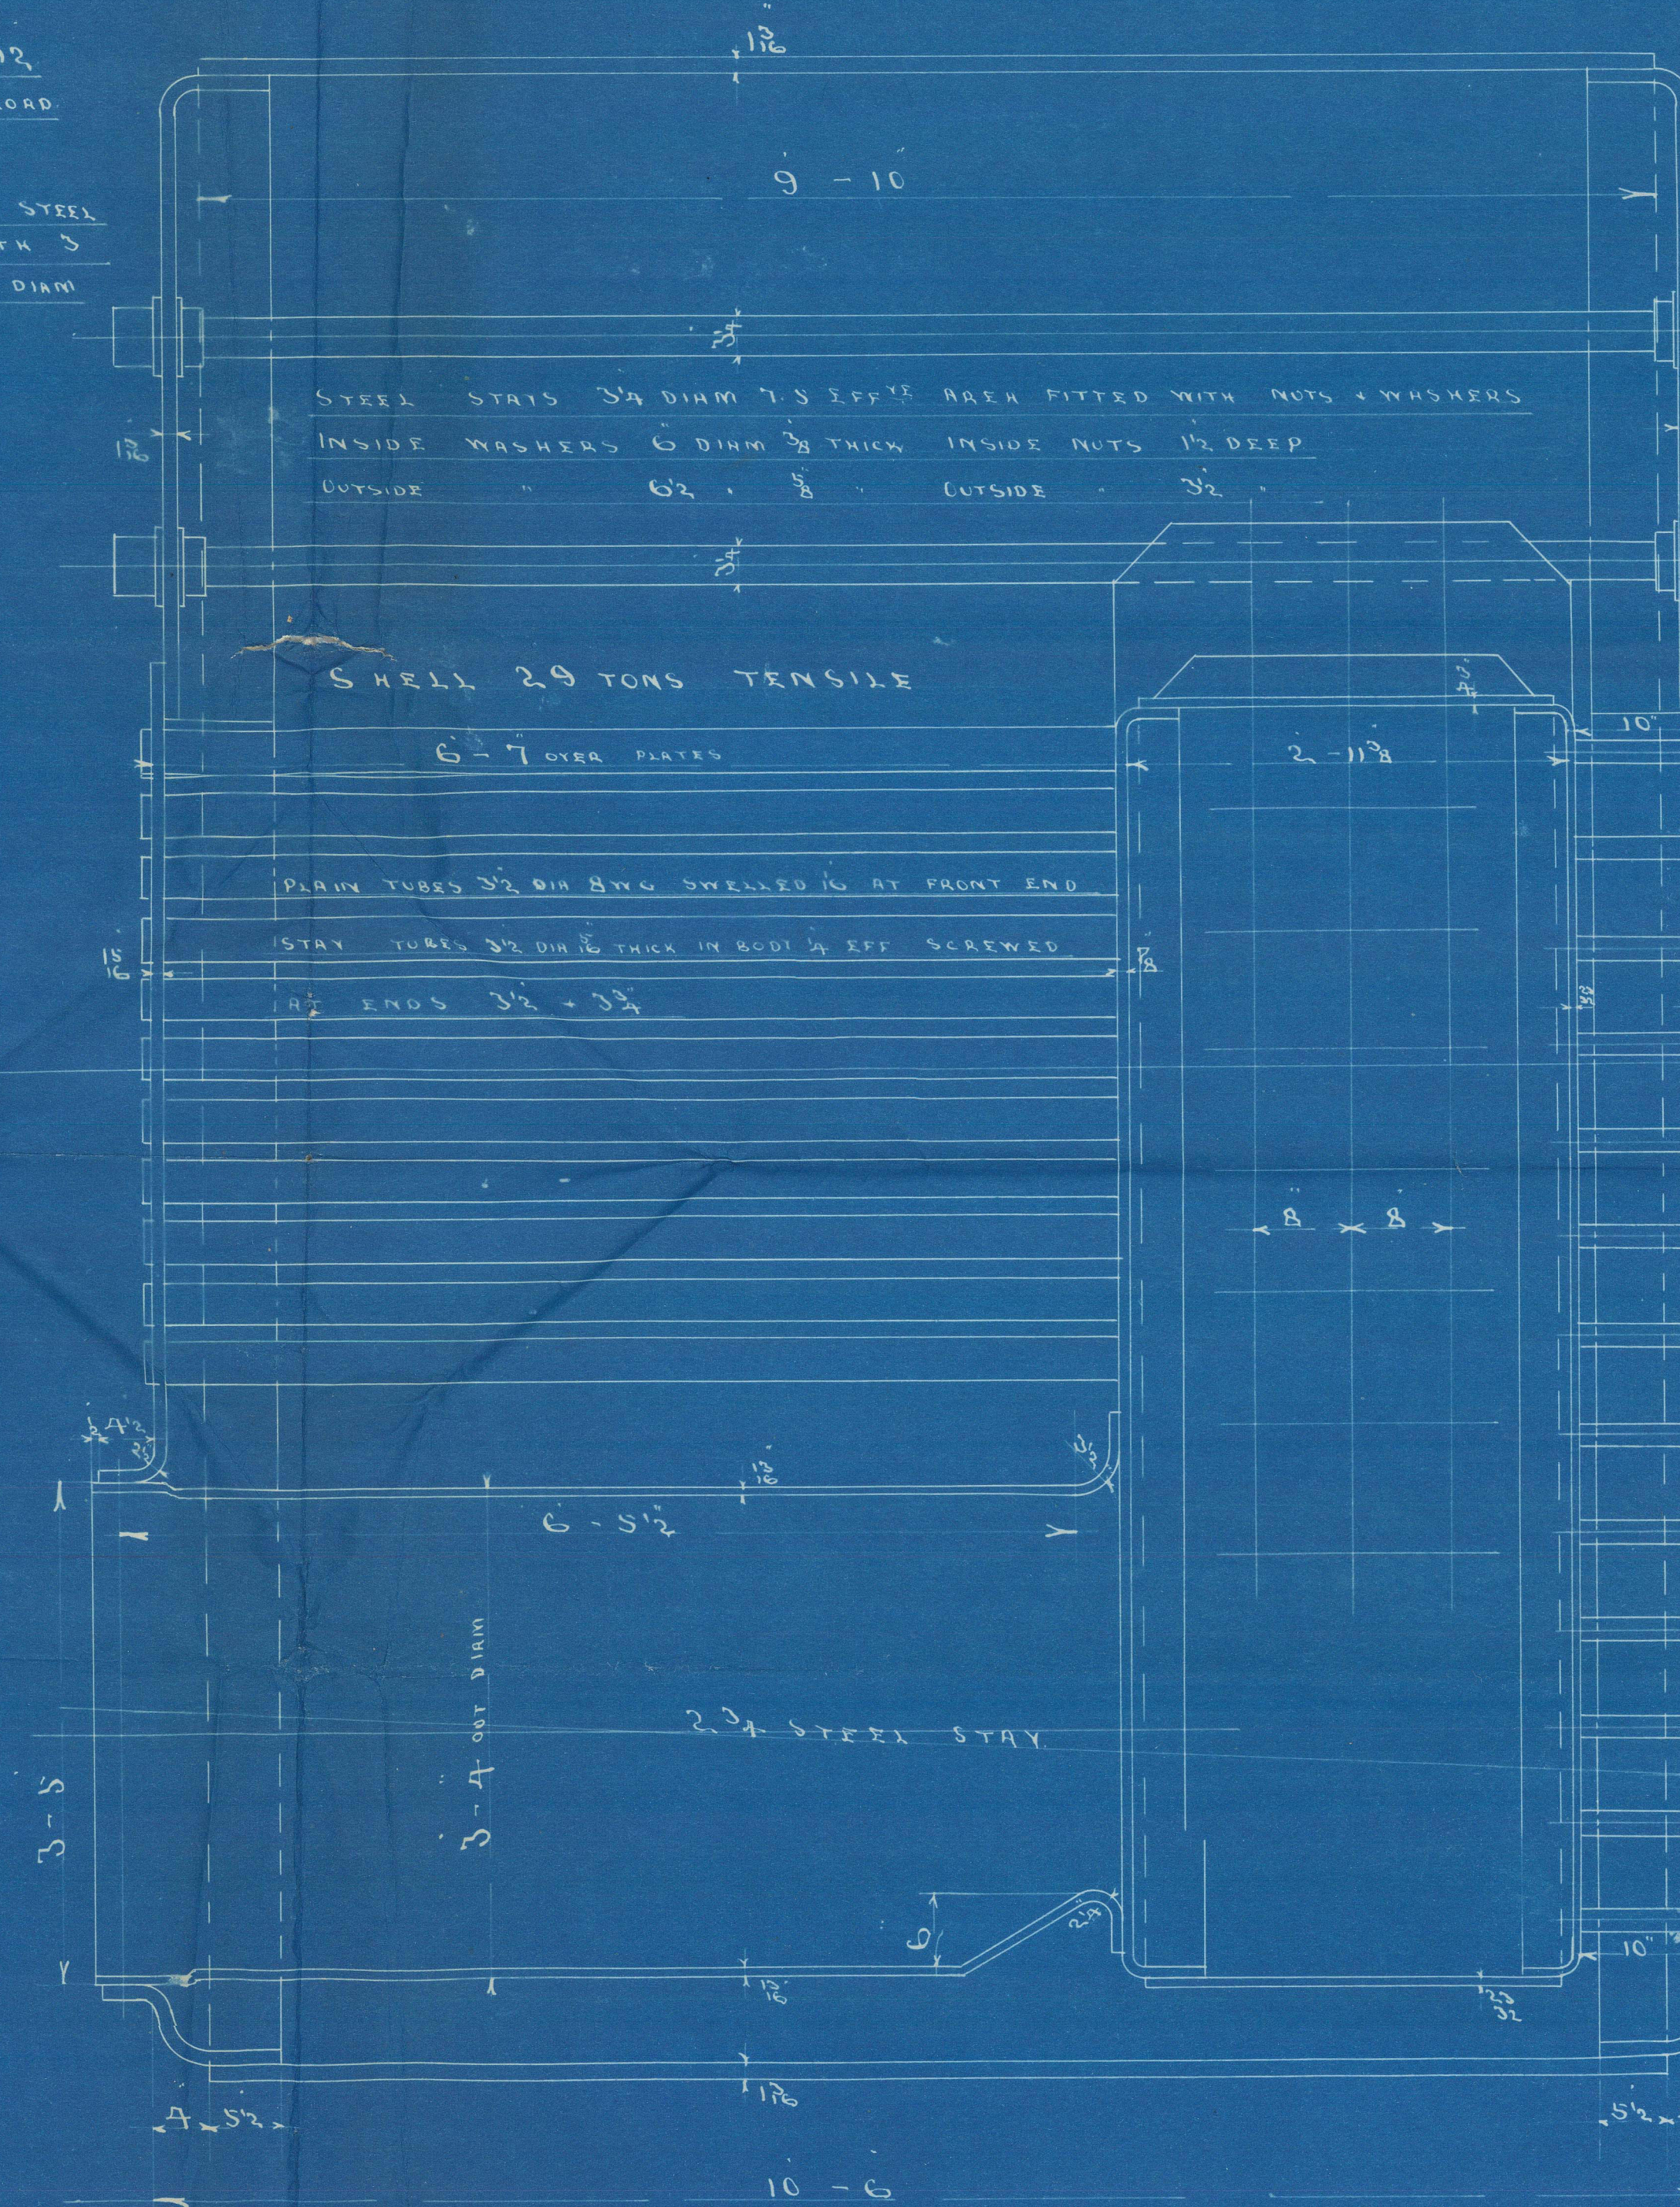

19/8/12

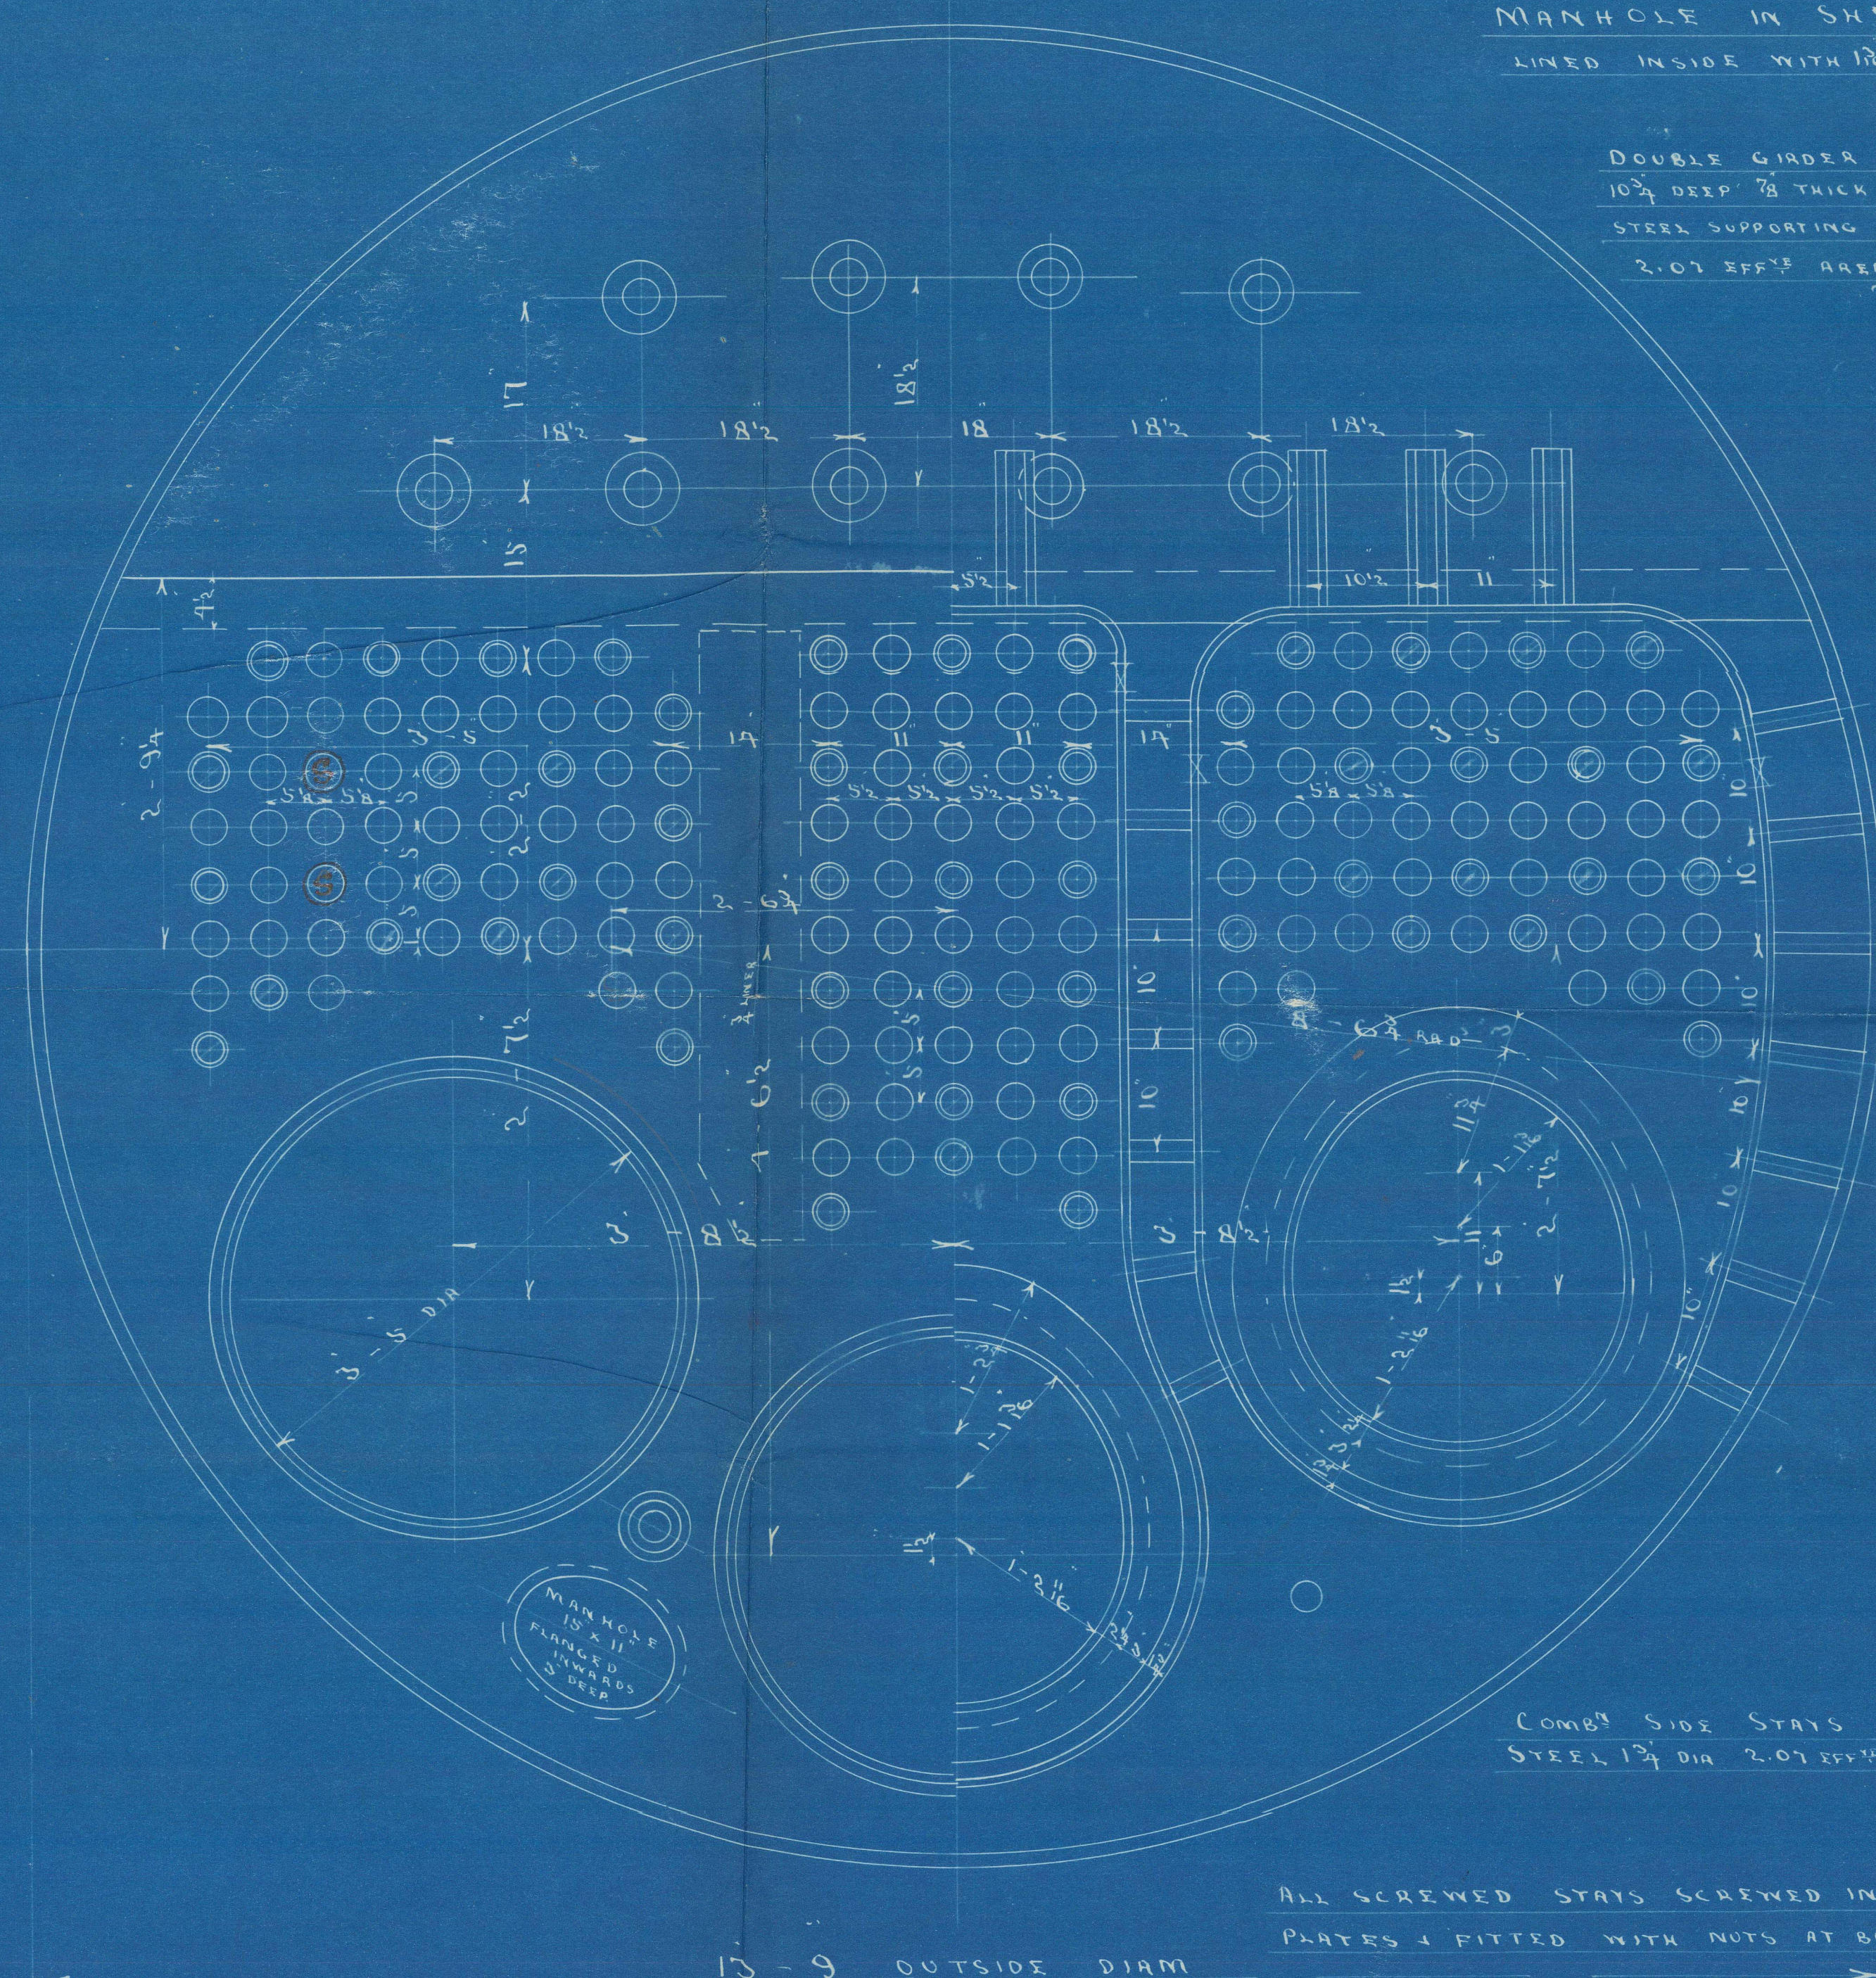

CHARLES D HOLMES & CO LTD  
 ENGINEERS & BOILER MAKERS  
 HULL.

18/11/12

19/8/12

PLAN Nº2426

STEEL BOILER Nº971




CHARLES D. HOLMES & CO.

app<sup>d</sup>

BOILER N<sup>o</sup> 971

Working Pressure 200 LBS.

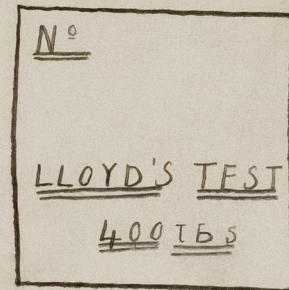

Hela Hull Report No. 25591



© 2021

Lloyd's Register  
Foundation

W852-0132