


14.5.15
31.8.15
9.9.15

Prop Deck Beams = 6" x 3" x 40' Bull Angle. Truss = 16" x 40'

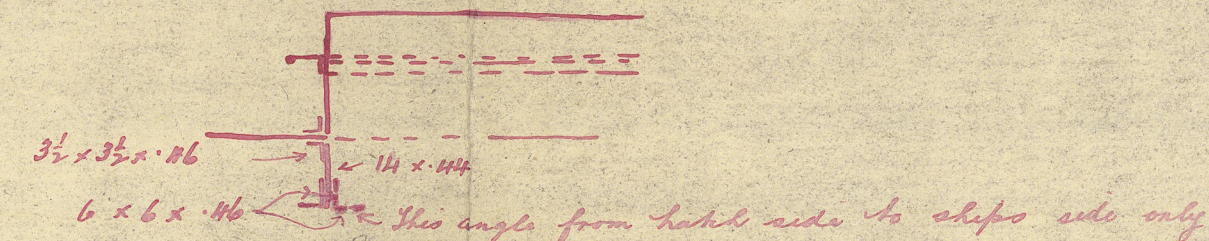

Beams marked A = 14" x 14" x 16' Bull Angle. Truss = 4" x 58' 10" x 54' 1/2"
B = 9" x 9" x 2' 35" x 34" = 24" x 50" x 8" x 58" Bull Angle.

Note: The hatchway end pillars must be of the built type but may be of equivalent H angles instead of channels.

PROFILE.

SCALE 1" = ONE FT.

S.S. 320'0" x 46'6" x 24'8" M.P.

Bridge Deck Beams = 8" x 3" x 42' Bull Angle. Truss = 19" x 40'.
= 62" x 3" x 40'


Upper Deck Beams
Beams under Prop. Bridge Deck = 8" x 3" x 42' Bull Angle. Truss = 19" x 40'.
Bridge = 62" x 3" x 40'.
Two Beams outside of Bridge = 8" x 3" x 50' = 25" x 50'.
Beams in Deck = 52" x 3" x 34' = 19" x 40'.

Lower Deck Beams = 10" x 50' Bull Angle. Truss = 24" x 50'.
End Beams 35' = 9" x 40'. 2. 35' x 34' = 24" x 50'.

Intermittent girders & gussets at corners of the hatchway on upper & bridge deck. Sketch to be submitted.

Note: No Hatch for afters fitted. Wood covers fitted for left.





Deck Plating doubled at corners of Hatchways & large Deck openings.

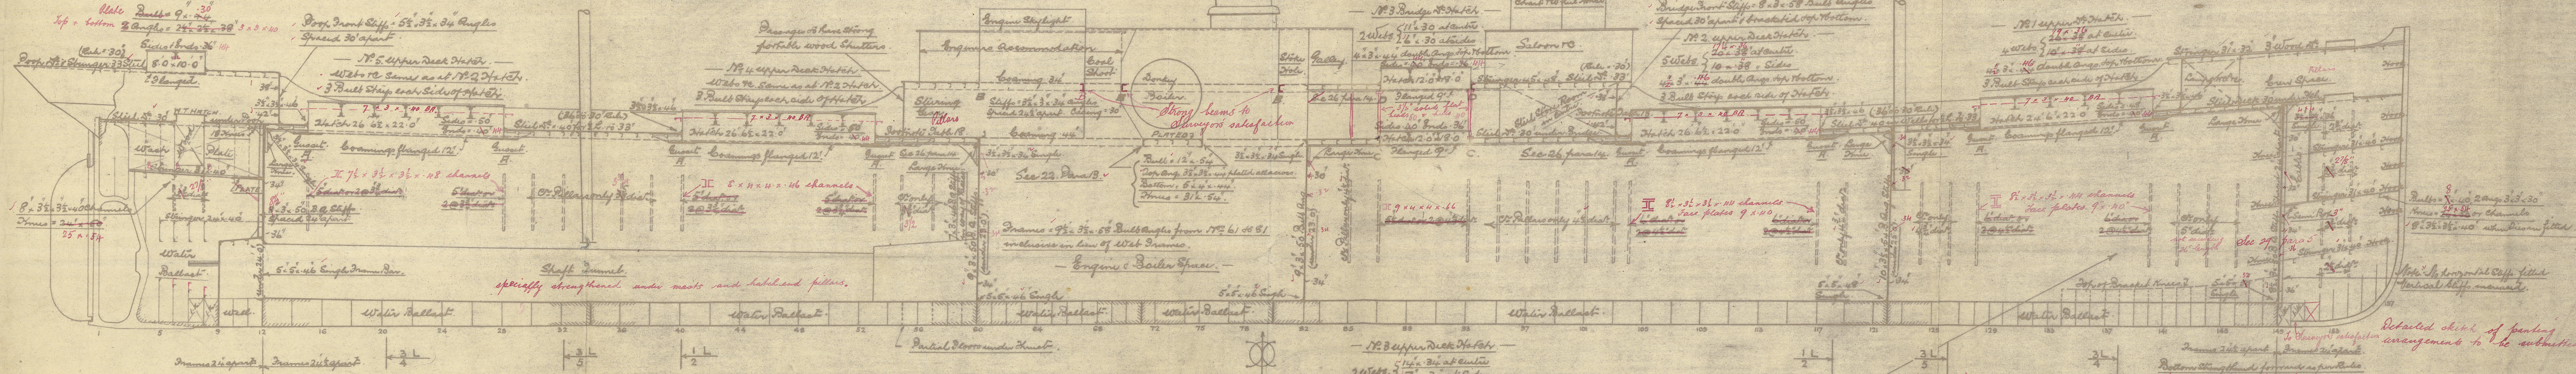

875.

C.F.
14.5.15

Frames 17' 13' 15' 16' 17' 20

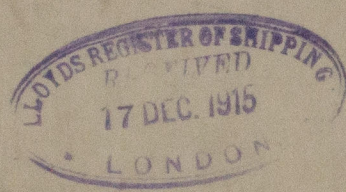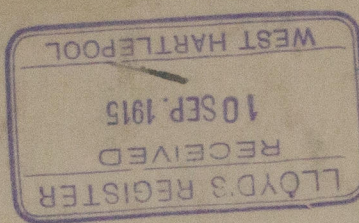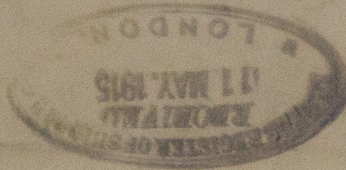
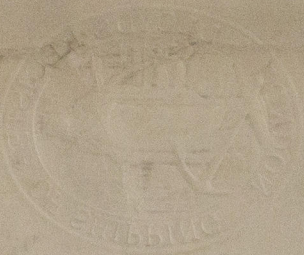


Messrs. Gray & Co.
S.S. N° 875.

PROFILE.

S.S. Merioneth

WEST HARTLEPOOL Report N° 15251

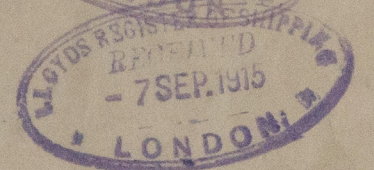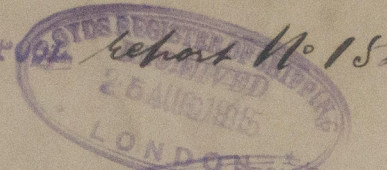

RETAIN



© 2021

Lloyd's Register
Foundation

W853-0193