


Span Deck Plan of
Messrs J Priestman & Co.
No 97

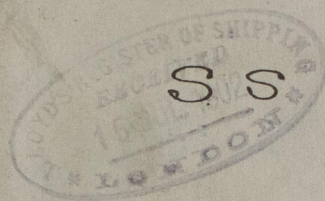

S.S. "CLAVEBURN"

Sunderland No. 21295.

RETAIN



© 2020

Lloyd's Register
Foundation

W854-0101