



14.11.07

N^o 544

MIDSHIP SECTION.

DIMENSIONS 135'0" B.P. x 23'0" EX. x 13'0" M^{LD}

STEEL TO CLASS 100 A.I. FOR FISHING PURPOSES.

SCALE $\frac{1}{2}$ " = 1 FOOT.



NUMERALS.

DEPTH = 13.5
 $\frac{1}{2}$ BREADTH = 11.43
 $\frac{1}{2}$ GIRTH = 21.25
 46.18 = 1ST N^o.
 133.80 = LENGTH.
 369440
 13854
 13854
 4618
 6178.8840 = 2ND N^o.

$\frac{L}{B}$ = 5.85

$\frac{L}{D}$ = 9.91

EQUIPMENT.


ONE ANCHOR 6 CWTs. EX. STOCK.

" " 5 $\frac{1}{2}$ " " "
 " " 3 " " "

120 FATHOMS $\frac{1}{8}$ " CABLE.

60 " 6" HAWSER.

60 " 5" WARP.

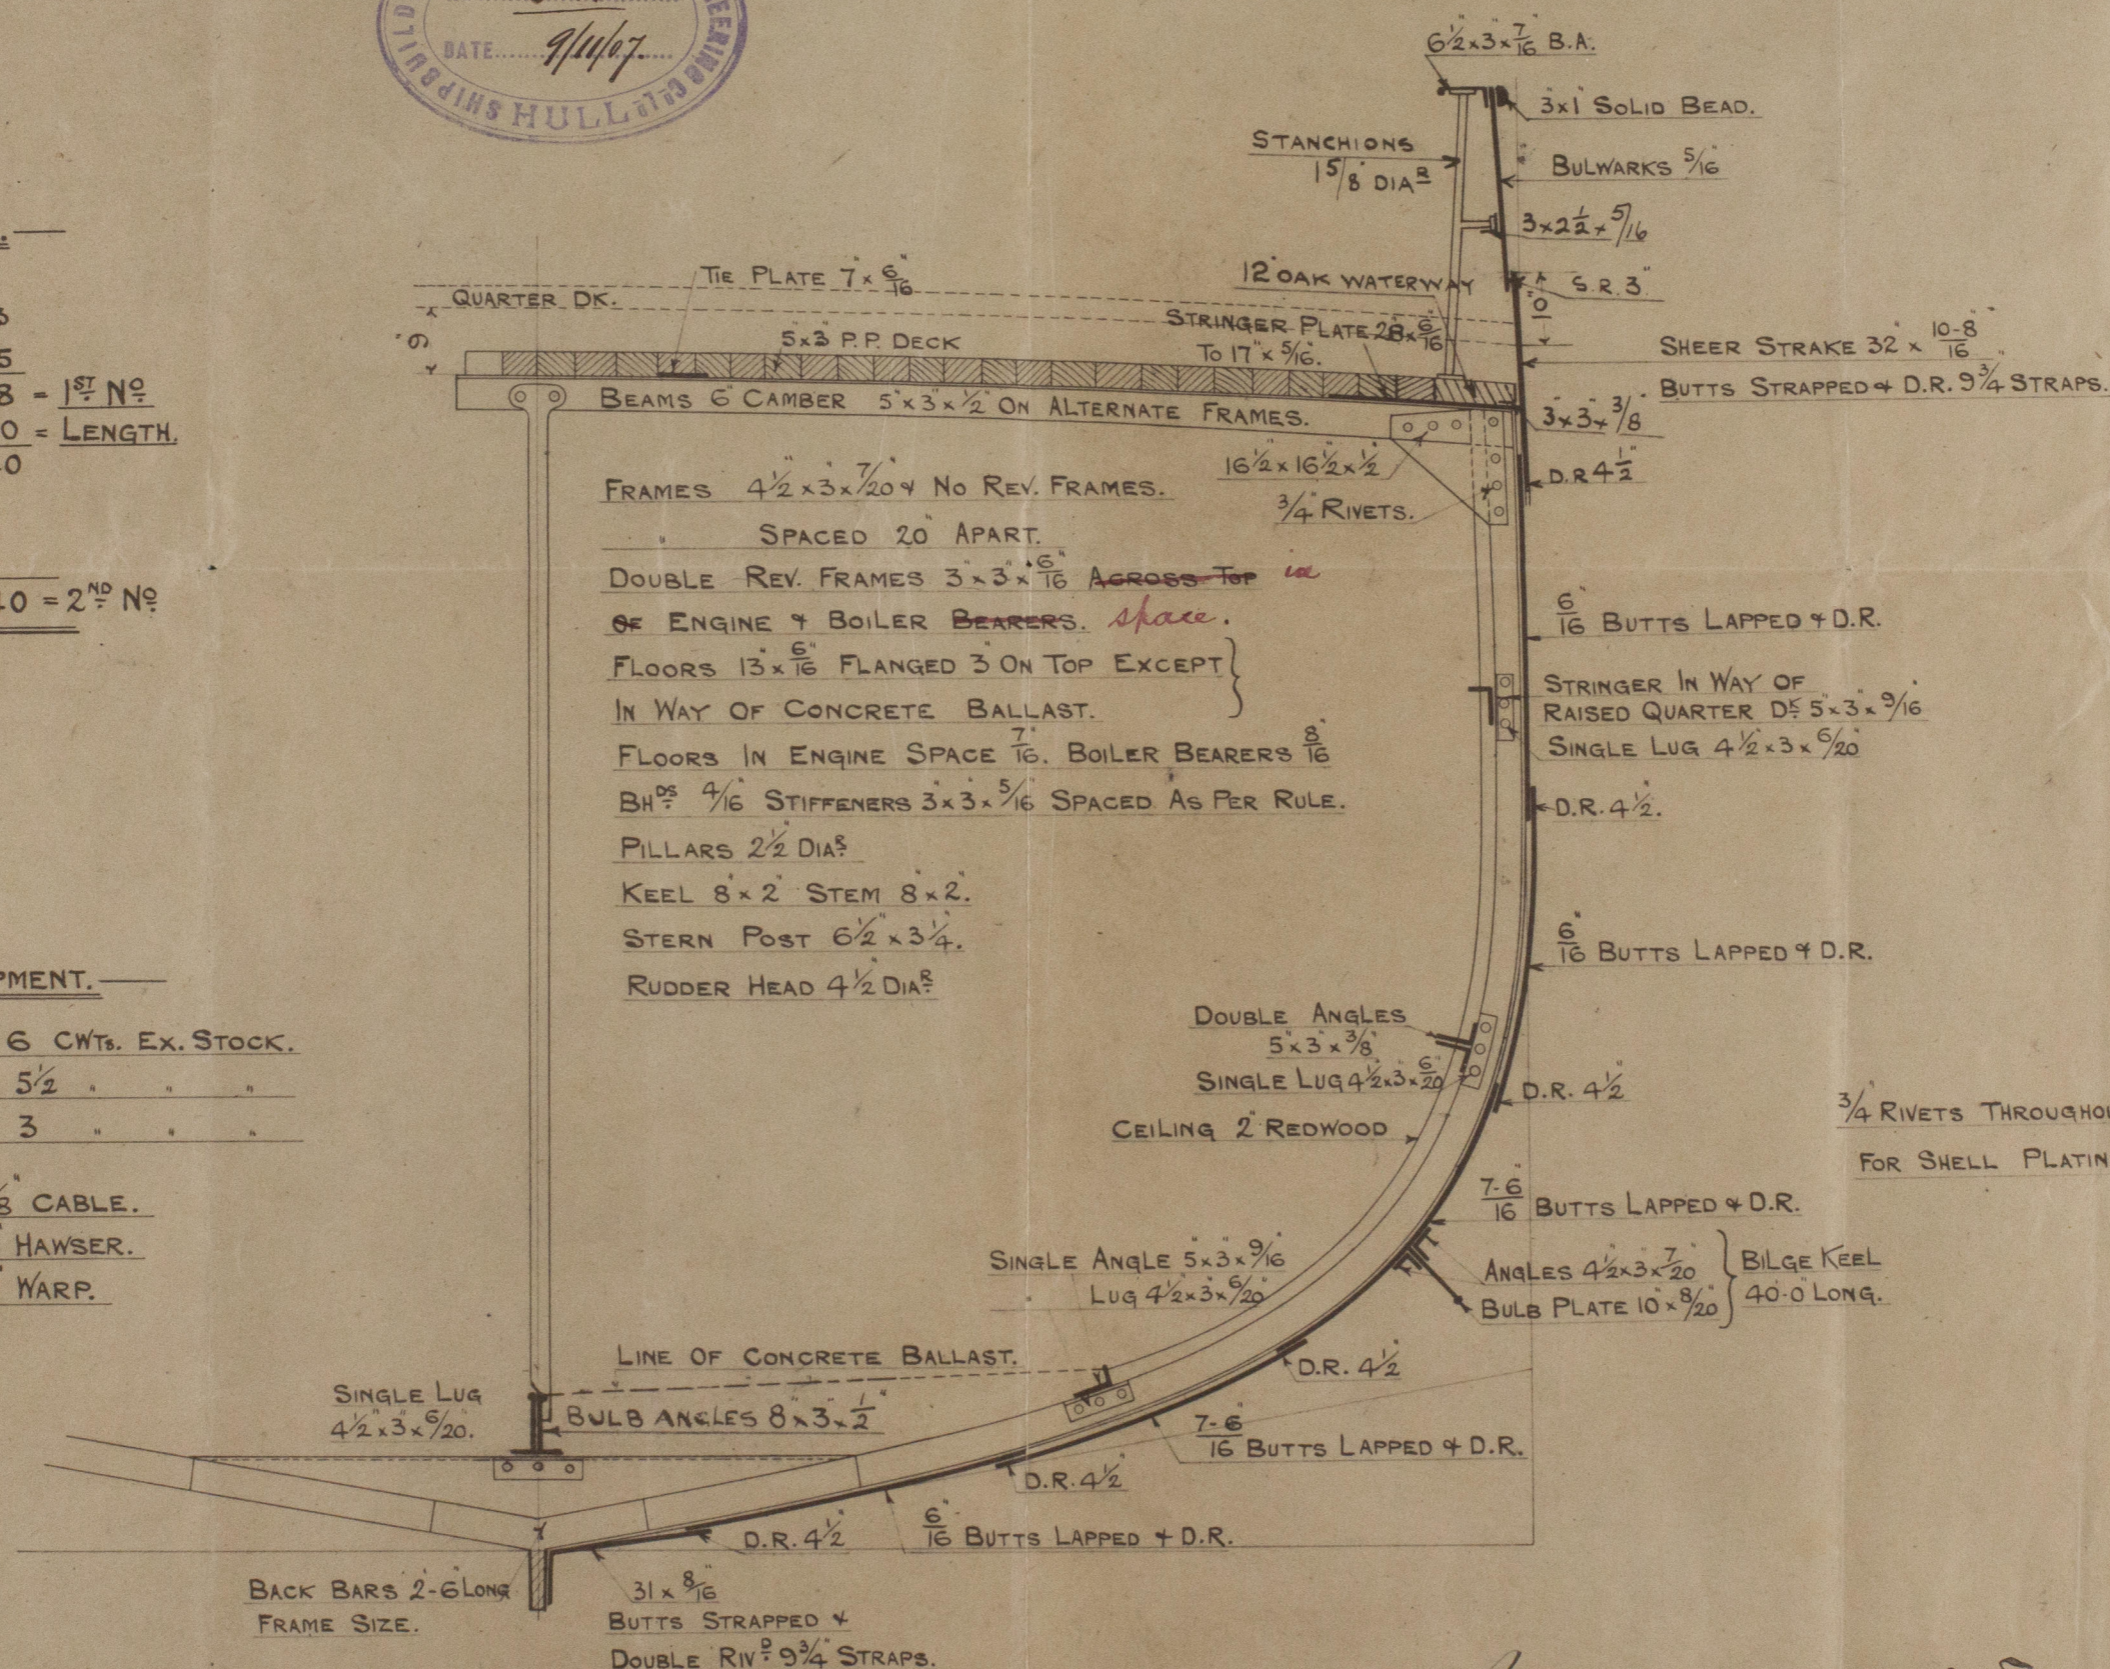

C.B.
 14.11.07.




© 2020

Lloyd's Register
 Foundation


W&S 0037

Earle's Co.
Midship Section.

Nº 544.

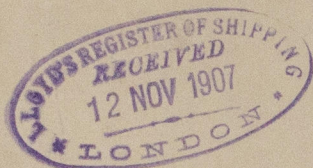

s/s New Crown
Hull Report Nº 19968

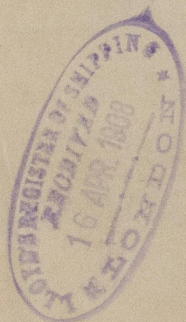

RETAIN



© 2020

Lloyd's Register
Foundation

W855-0037