

PROFILE & DECK PLAN

DIMENSIONS 135-0 B.P x 23-0" EX x 13-0 MLO

SCALE $\frac{1}{4}'' = 1 \text{ FT}$


Pillars throughout to
satisfaction of Surveyor.

BRACKETS TO CENTRE KEELSON TO BE FITTED VERTICALLY, TO HAVE DOUBLE LUG CONNECTIONS TO BH-05. BRACKETS TO BE FITTED BETWEEN THE TWO ANGLES.


6300-5881

Earle's Co.
Profile & Deck Plan.
No 544.

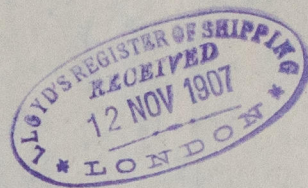

of New Brown
Hull Report No 19968

RETAIN

W&S-0039



© 2020

Lloyd's Register
Foundation