



24.8.12

and removed
No. 543
which is correct

PLAN No. 1354
FOR ENCLOSURE TO
Messrs Lloyd's Surveyors
Hull FROM
COCHRANE & SONS,
SHIPBUILDERS, SELBY
DATE 20/8/12 R.R.

minutes of
24.8.12. at 1.15 PM


PROFILE & DECK.

Nº 543


DIM. 135'-0" x 23'-6" x 13'-4"

SCALE 1/4 INCH = 1 FOOT.

DECK BEAMS 6" x 3" x 20"

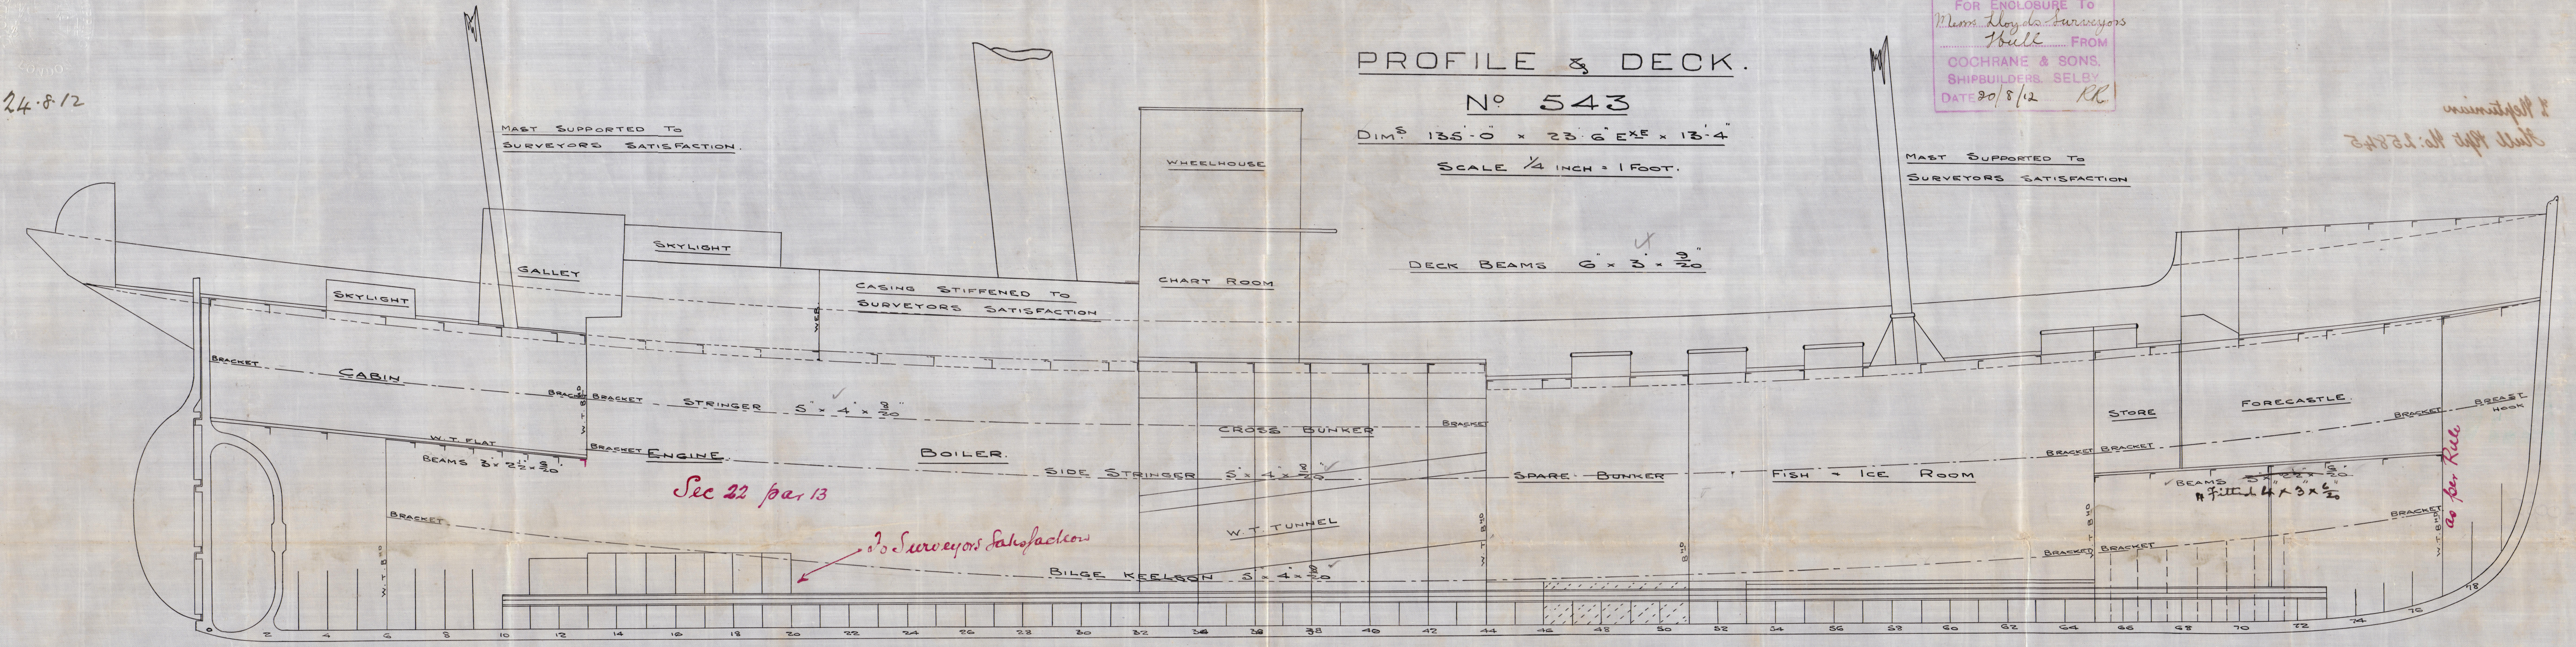

PILLARS THROUGHOUT TO SURVEYORS SATISFACTION.

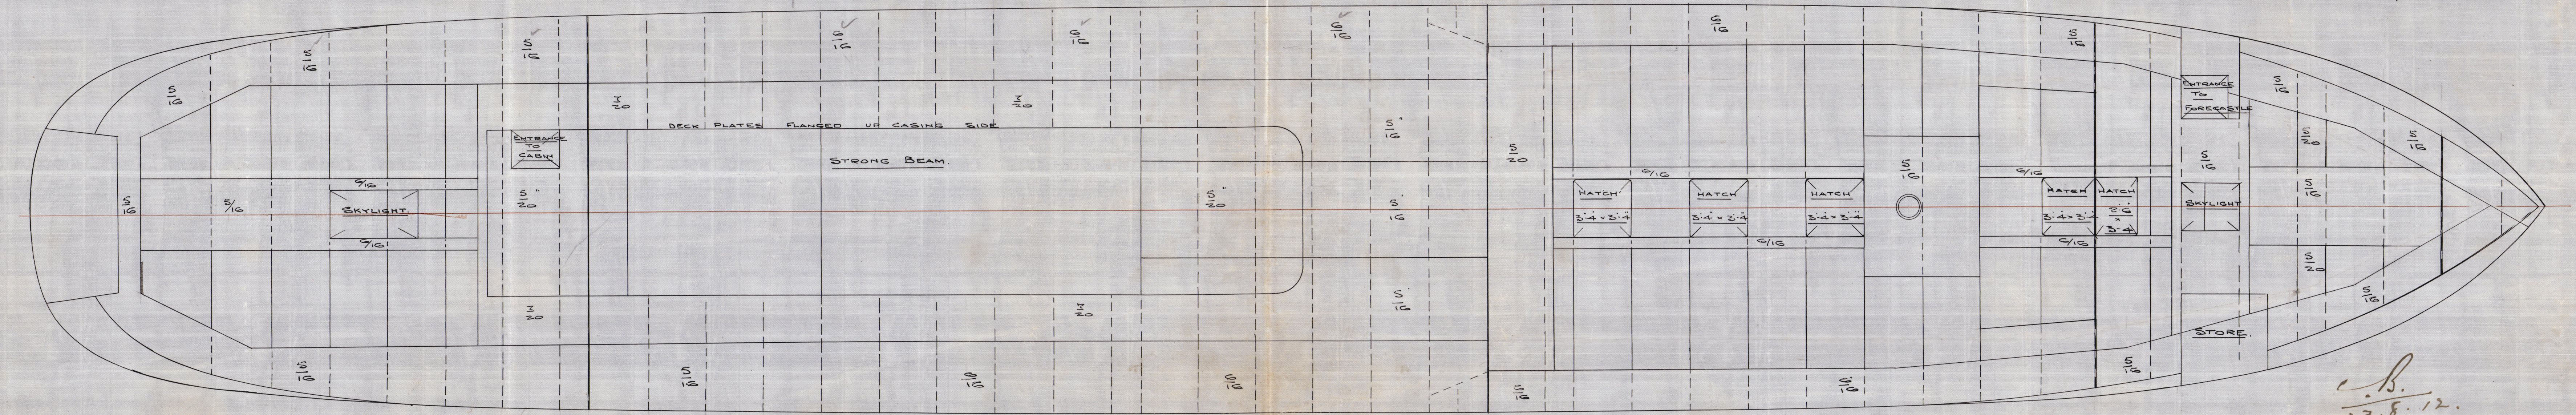

C.B.
23.8.12.

W855-0055

Cochrane & Sons
No. 543.
Profile and Decks

74-812
1/2 Neptunian
Hull Rpt No: 25845

11881
COCHRANE & SONS
FROM
TO
11881

SECTION
TO

RECEIVED
JUL 23 1881

W855-0055



© 2020

Lloyd's Register
Foundation