

7.6.10

PLAN No 9301

Messrs Lloyd's Surveyors  
Coastal & Marine  
SHIPBUILDERS  
DATE 21/5/10 RK

# PROFILE & DECK PLAN


STEEL SCREW STEAMER

No 473

DIM<sup>NS</sup> LENGTH 127'-0" x 22'-6" EX. x 9'-10" DEPTH M<sup>D</sup> AMIDSHIPS

SCALE 1/4" = ONE FOOT.

PILLARS THROUGHOUT TO SURVEYOR'S SATISFACTION

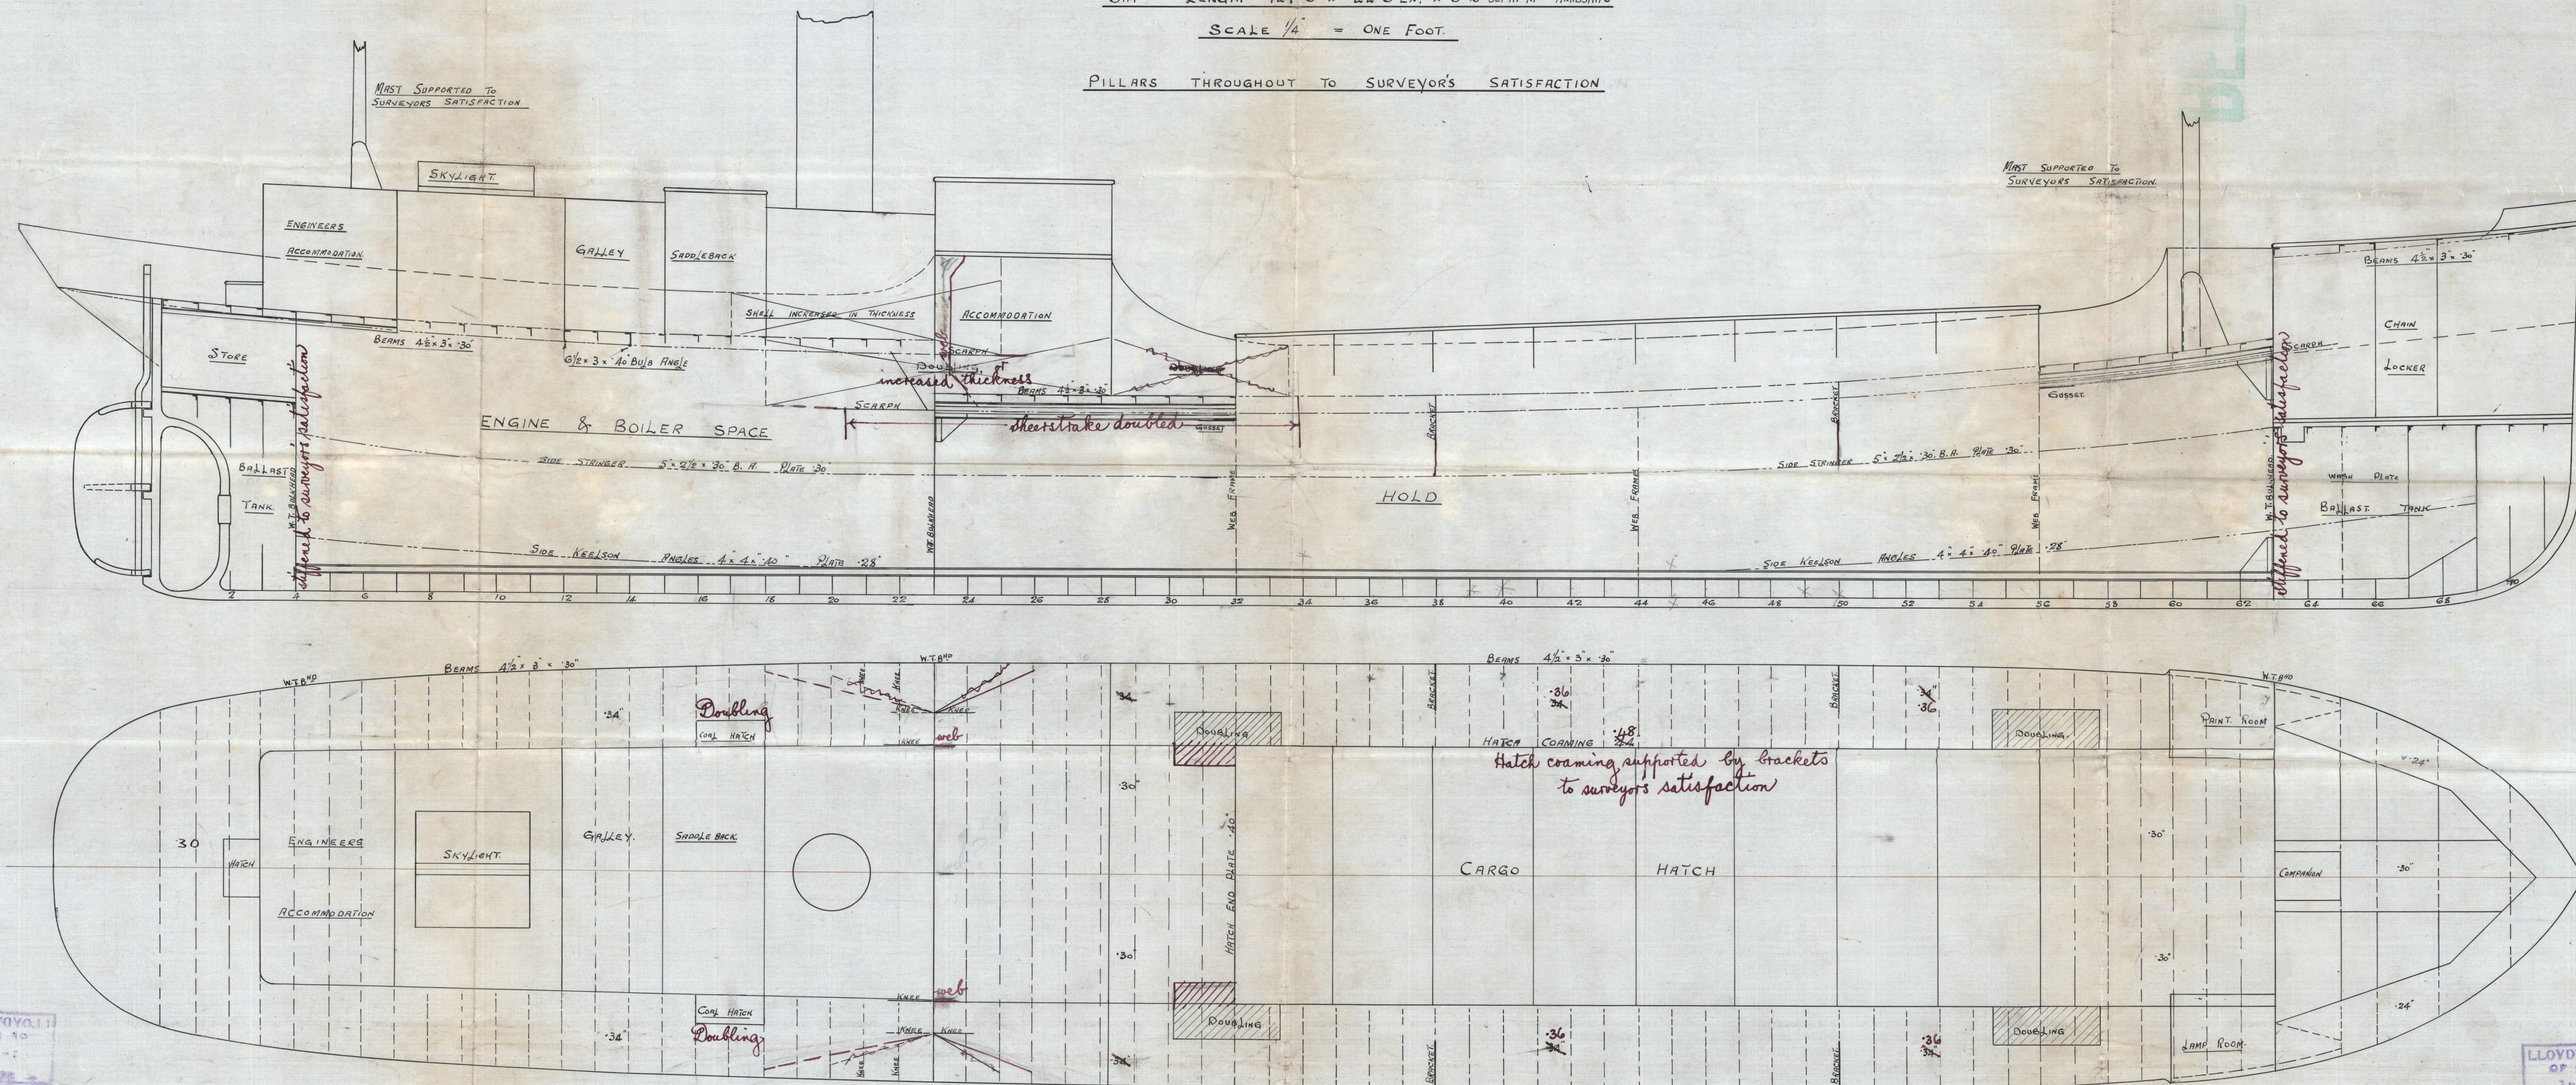

LLOYD'S REGISTER  
OF SHIPPING  
100, FLEET STREET  
LONDON, E.C. 4

LLOYD'S REGISTER  
OF SHIPPING  
100, FLEET STREET  
LONDON, E.C. 4




Cochrane & Sons

No. 443.

Profile & Deck Plan

of Hull Trader  
Hull Report No. 23326

RETAIN



© 2020

Lloyd's Register  
Foundation

W856-0192