

BOILERS. N° 1012

3 OFF. FOR MESSRS THE SUNDERLAND SHIPBUILDING CO^S S.S. N° 285

WORKING PRESSURE = 180 LBS PER SQ INCH TEST PRESSURE = 300 LBS PER SQ INCH TO LLOYD'S REQUIREMENTS

ALL PLATES, RIVETS & STAYS OF STEEL

ALL HOLES DRILLED IN POSITION

TENSILE STRENGTH OF SHELL PLATES, BUTT STRAPS & GIRDERS TO BE NOT LESS THAN 20% NOR MORE THAN 33 TONS PER SQ INCH

| | | |
|--|-----|---------------------------|
| OTHER | 26 | 20% |
| LONGITUDINAL STAYS | 28 | 32 |
| SCREW STAYS & RIVETS | 26 | 30 |
| <u>ELONGATION OF SHELL PLATES, BUTT STRAPS, GIRDERS & LONGITUDINAL STAYS TO BE NOT LESS THAN 20% IN A LENGTH OF 8 INCHES</u> | | |
| OTHER | 23% | 8 |
| SCREW STAYS | 23% | 3 TIMES DIA OF TEST PIECE |
| RIVETS | 25% | |

SUNDERLAND

GEORGE CLARK LTD

(3) BOILERS N°1012

W.P.=180 LBS

(DUPLICATE OF N°1000)

SUNDERLAND S/B CO LTD

S/S N°285

Mark on boilers:—


N° 3250

LLLOYD'S TEST

360 LBS

5-10-1914

L.C.D.

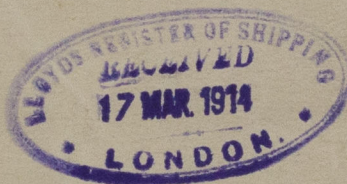

S/S "Meuse"

SUNDERLAND RPT. NO. 26288

RETAIN



© 2020

Lloyd's Register

W858-0066