


4377

STEEL BOILER 10'-6" DIA 10'-6" LONG 100 LBS W.P. LLOYDS

4441

17/4/12

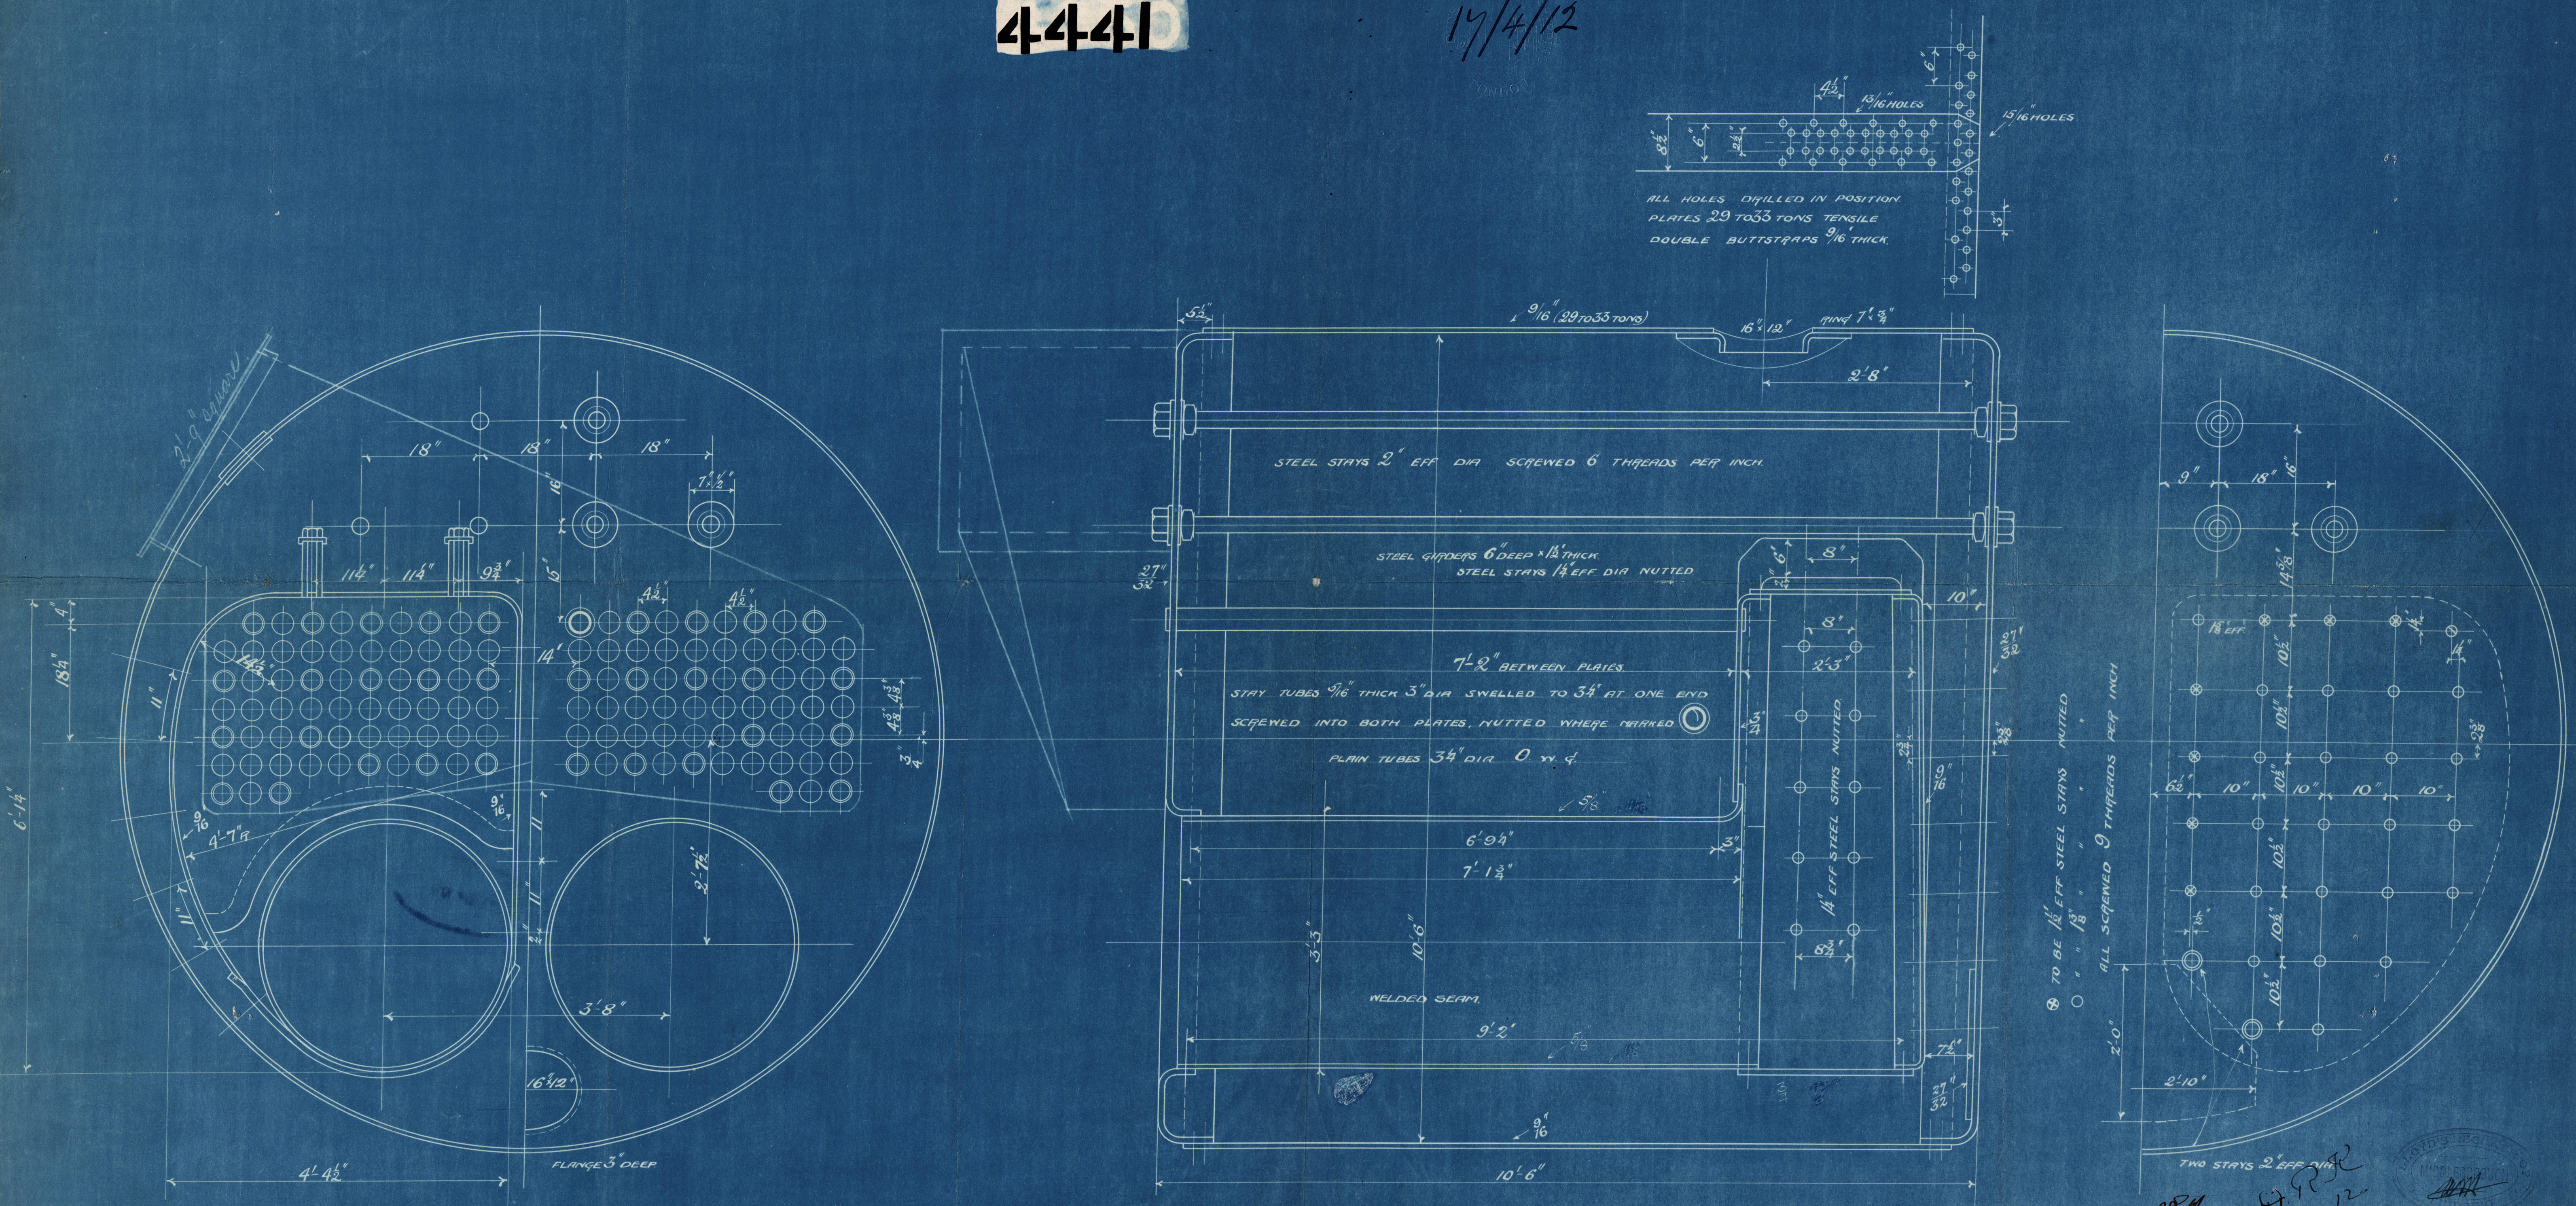

RILEY BROS. (BOILERMAKERS) LTD.
STOCKTON ON TEES.

28/16
17/4/12
15/4/12

W852-0089



W838-0089.

Messrs Wileys Bros Ltd
Boiler No. 4441

for

Messrs Sir Jas Laing & Sons Ltd
S.S. No. 637

Working Pressure 100 lbs

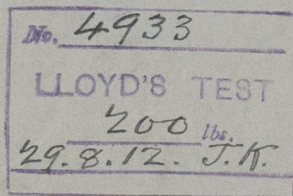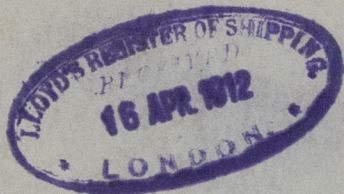

Mat. Report 7138

Laertis

Mat. Rpt. No. 25456

RETAIN



© 2020

Lloyd's Register
Foundation