
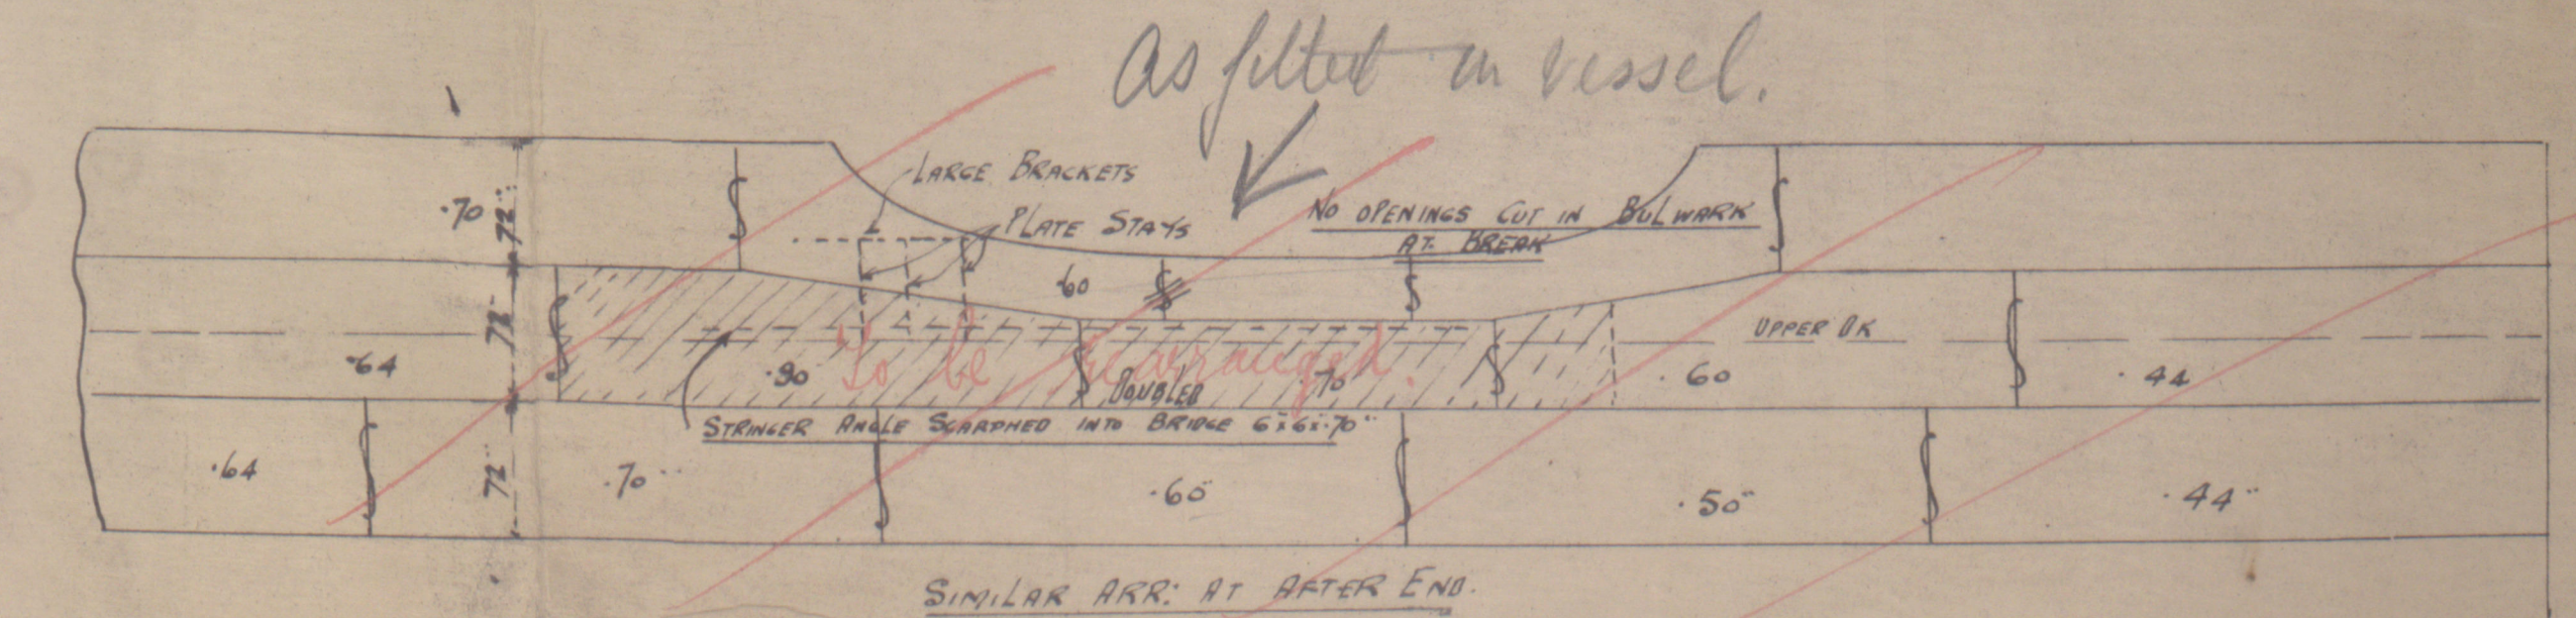


12.1.12  
27.2.12  
1.3.12  
7.5.12  
5.6.12  
11.6.12

S.S.637  
PROFILE

LENGTH B.P. 376'-0" BREADTH N<sup>o</sup> 50'-11 1/2" DEPTH N<sup>o</sup> 25'-3"  
To CLASS 100 A1 AT LLOYDS

1" = 100 FT

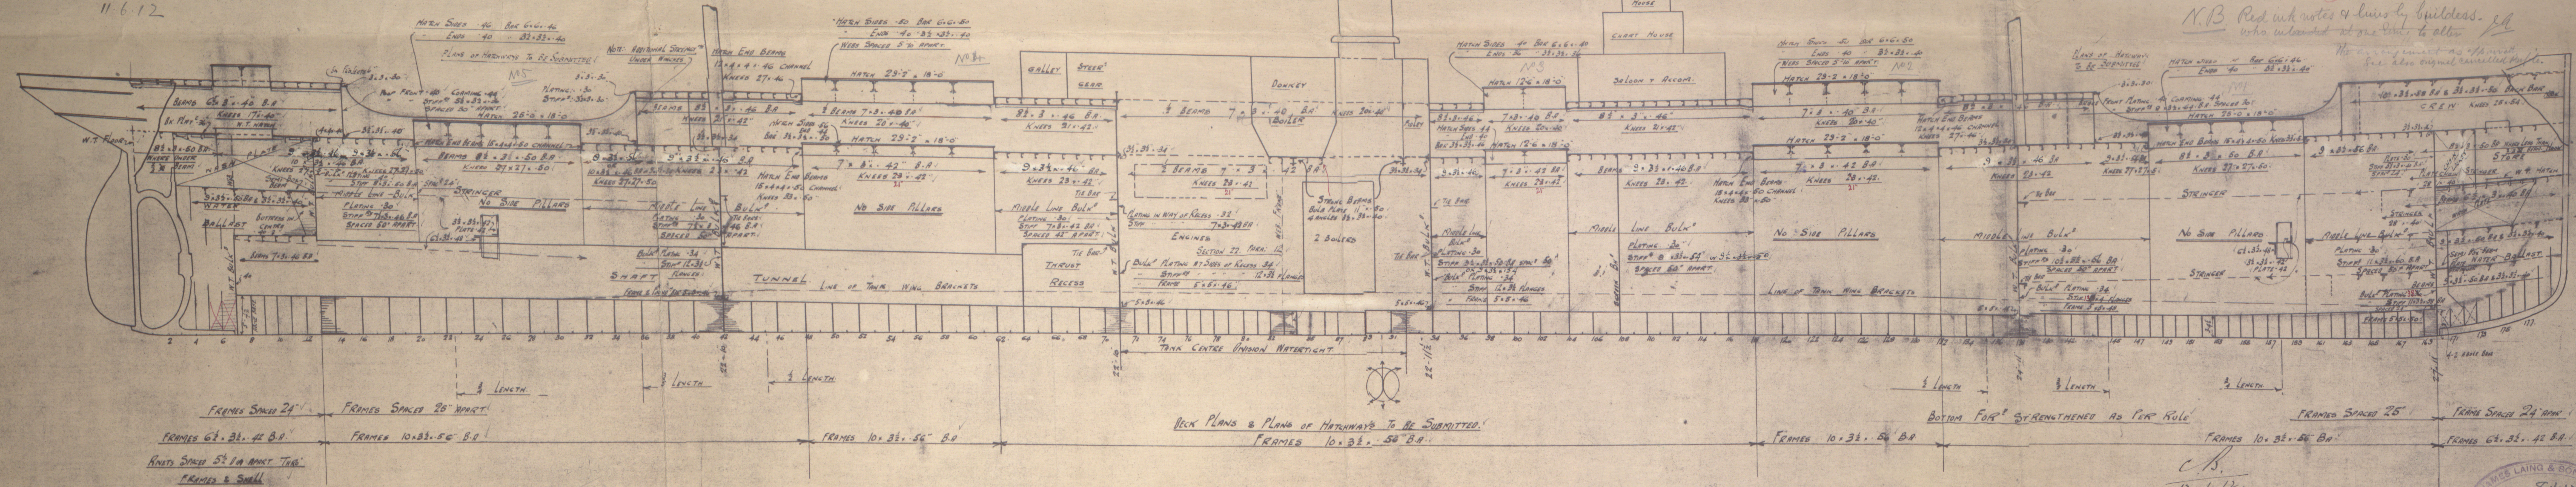

N.B. Red ink notes & lines by Builders. who indicated at one time to alter the original cancelled profile. See also original cancelled profile.

BECK PLANS & PLANS OF MATCHWAYS TO BE SUBMITTED.  
FRAMES 10 x 3 1/2" x 56" B.P.

BOTTOM FOR STRENGTHENED AS PER RULE

FRAMES SPACED 25'  
FRAMES SPACED 24' APART

C.B.  
12.1.12.





LAERTIS


Sld. Rht. No. 25456.  
PROFILE

Sir J. Laing & Sons

No 637



*Amended*

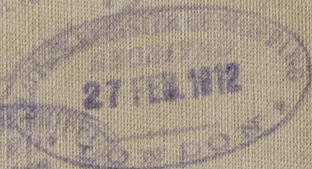

RETAIN



© 2020

Lloyd's Register  
Foundation

W858-0090