


To class. 100 A.I. Lloyds. three decks.

2. 11. 01
4. 12. 01
16. 12. 01
30. 12. 01 *Shelter*
10. 5. 02
23. 7. 02
25. 7. 02

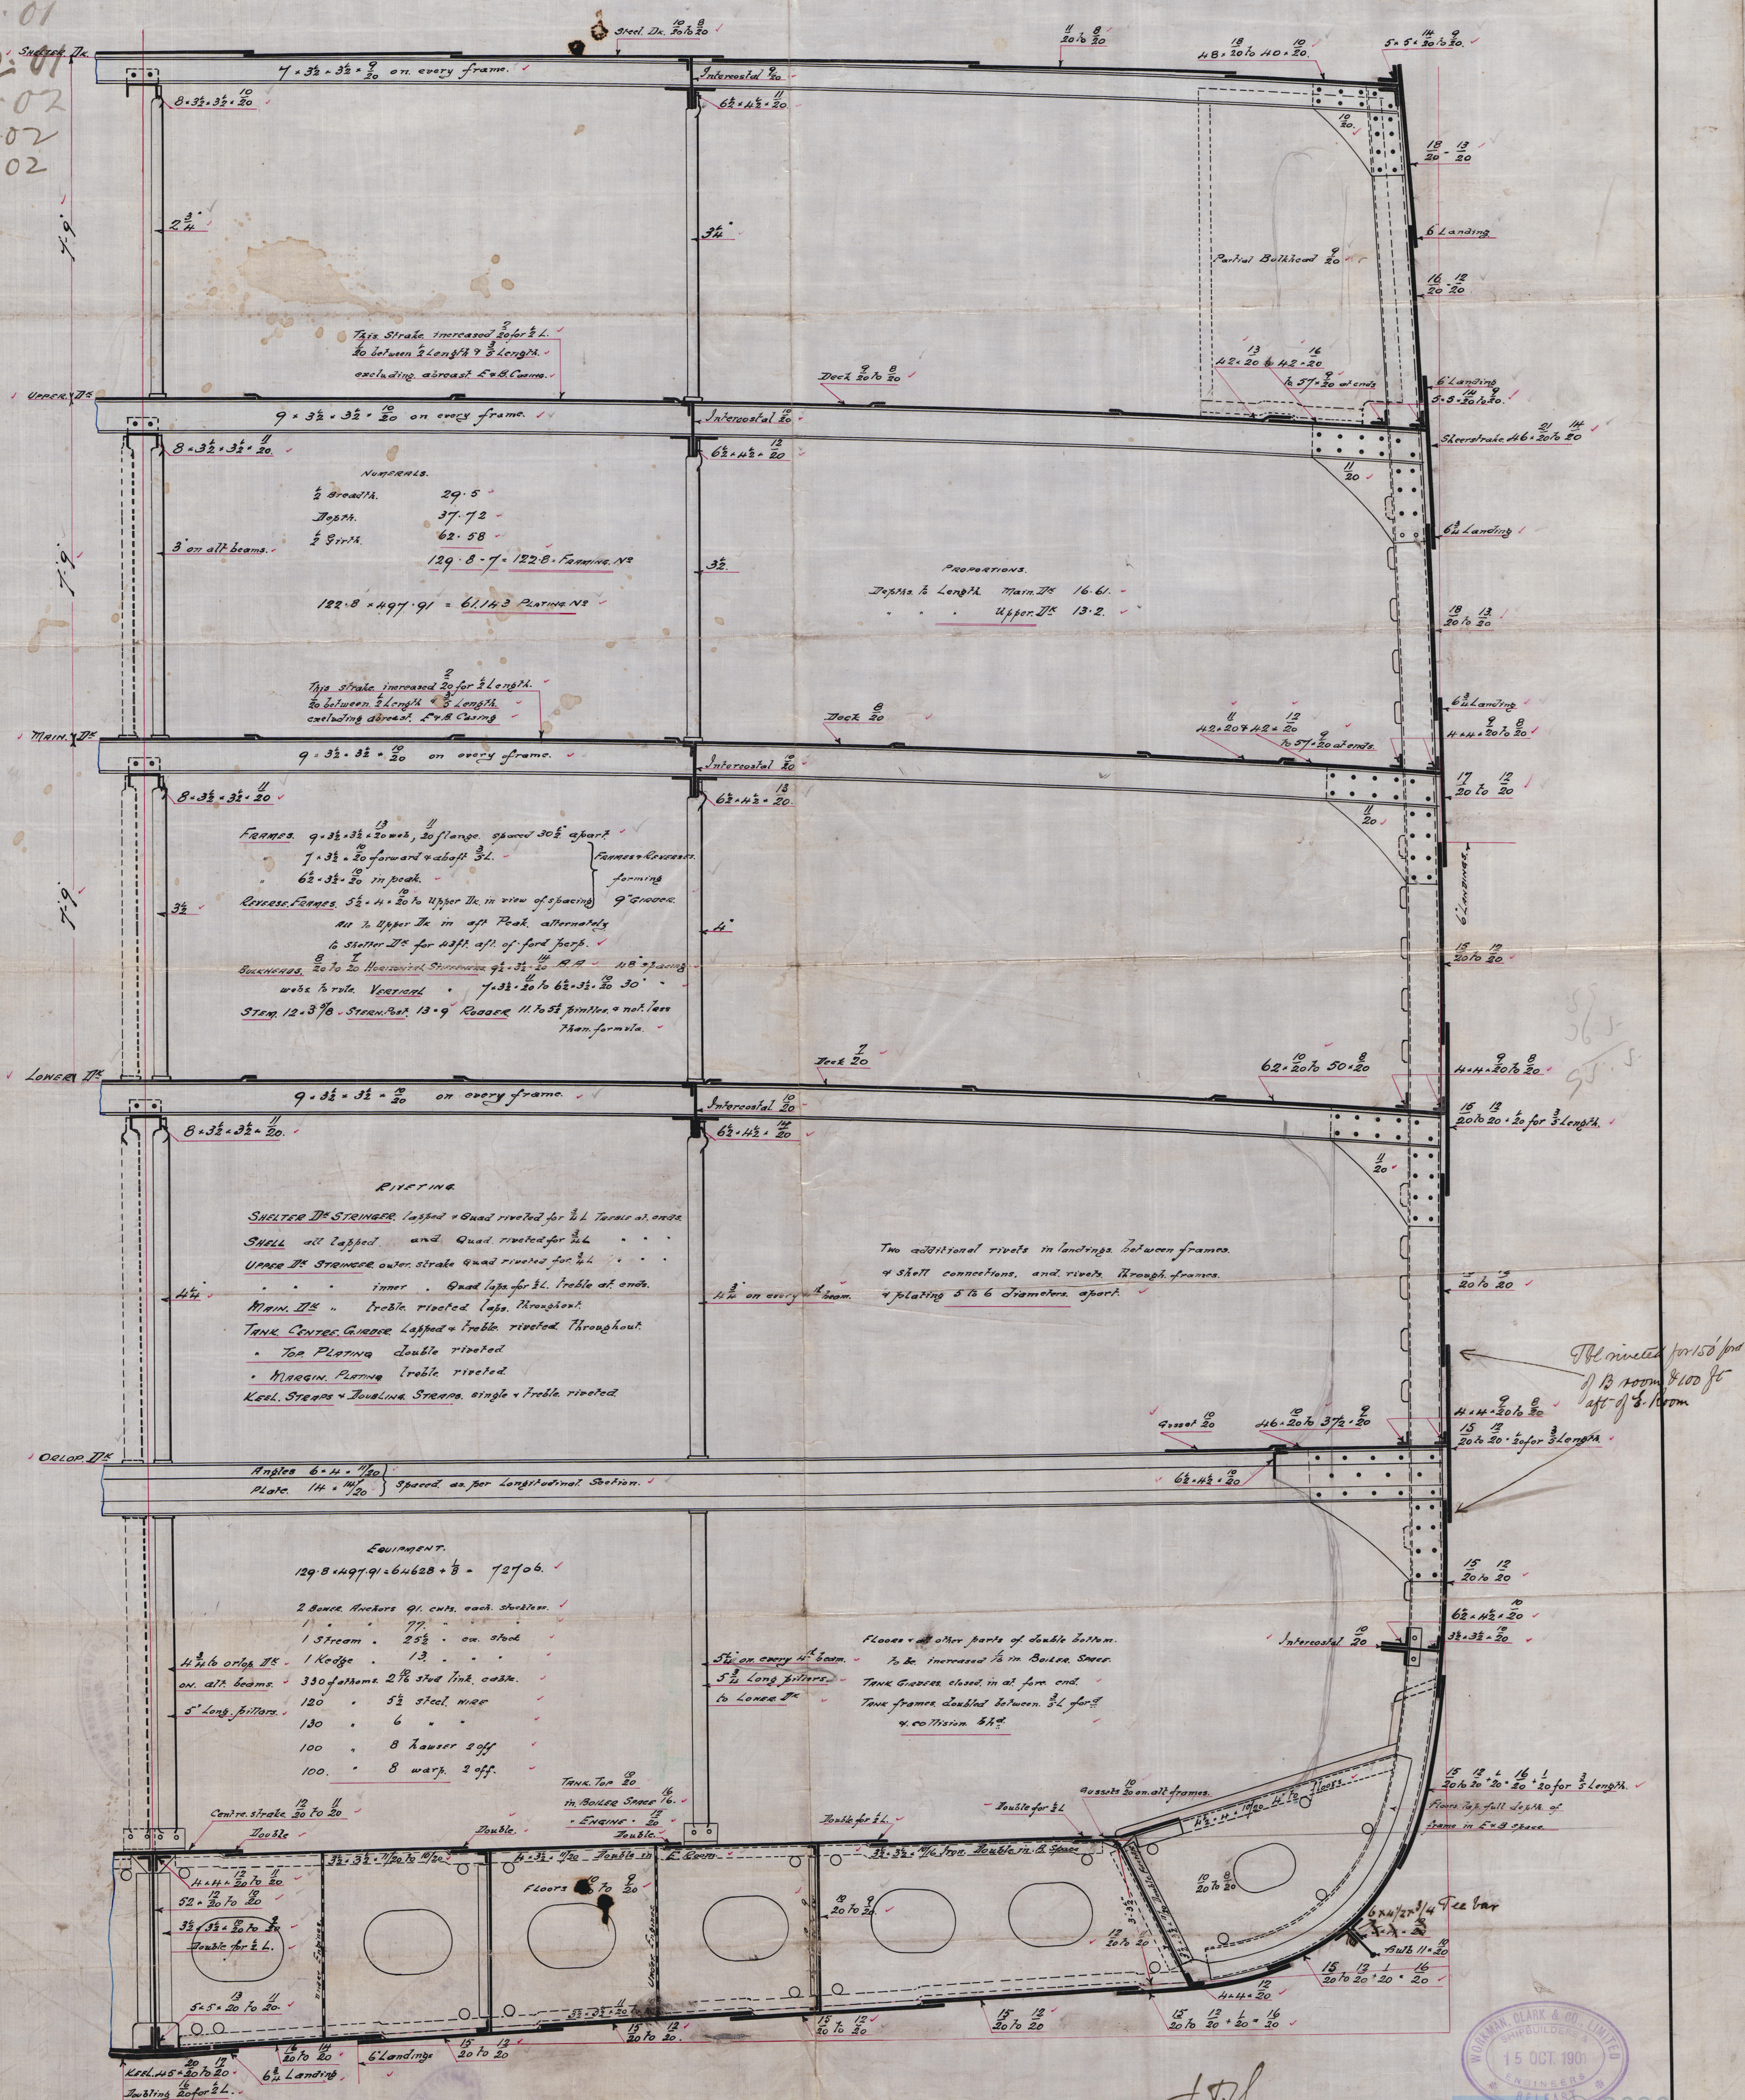

WORKMAN, CLARK & CO., LIMITED
SHIPBUILDERS &
15 OCT. 1901
ENGINEERS

© 2020

Lloyd's Register
Foundation

"Leak"

Bul 5529

West Workman Clark & Co
S.S. 193

Midship Section

As the built

LOYD'S REGISTER OF SHIPPERS
RECEIVED
25 JUL 1902
LONDON

LOYD'S REGISTER OF SHIPPERS
RECEIVED
28 DEC 1901
LONDON



© 2020

Lloyd's Register
Foundation