


Scale $\frac{1}{8}'' = 1 \text{ foot}$

12. 1. 06
6. 2. 06
73. 2. 06
21. 3. 06
28. 3. 06
1. 5. 06
11. 5. 06
73. 3. 06


Details of hatch supports to be submitted

 

SECTION AT FRAME 176

Lloyd's R
Foundat
W859-0


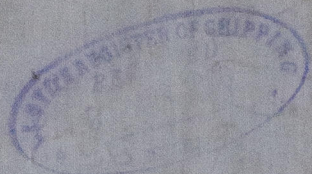


Mess^{rs} Workman Clark & Co

SS 237

Profile plan

S/S Howth Head

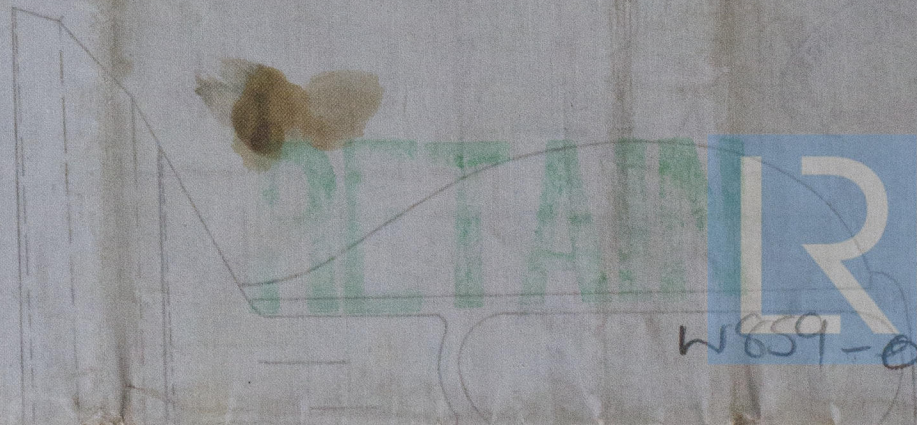

© 2020

Lloyd's Register
Foundation

W659-016