


MIDSHIP SECTION N° 237 S.S.

DIMENSIONS 380' x 48' x 31'6" M^{LD}

To class 100 A1 3 D⁵ Rule

Scale 1/2" = 1 Foot

12.1.06
6.2.06
13.2.06
21.3.06
28.3.06
1.5.06
11.5.06
13.5.06

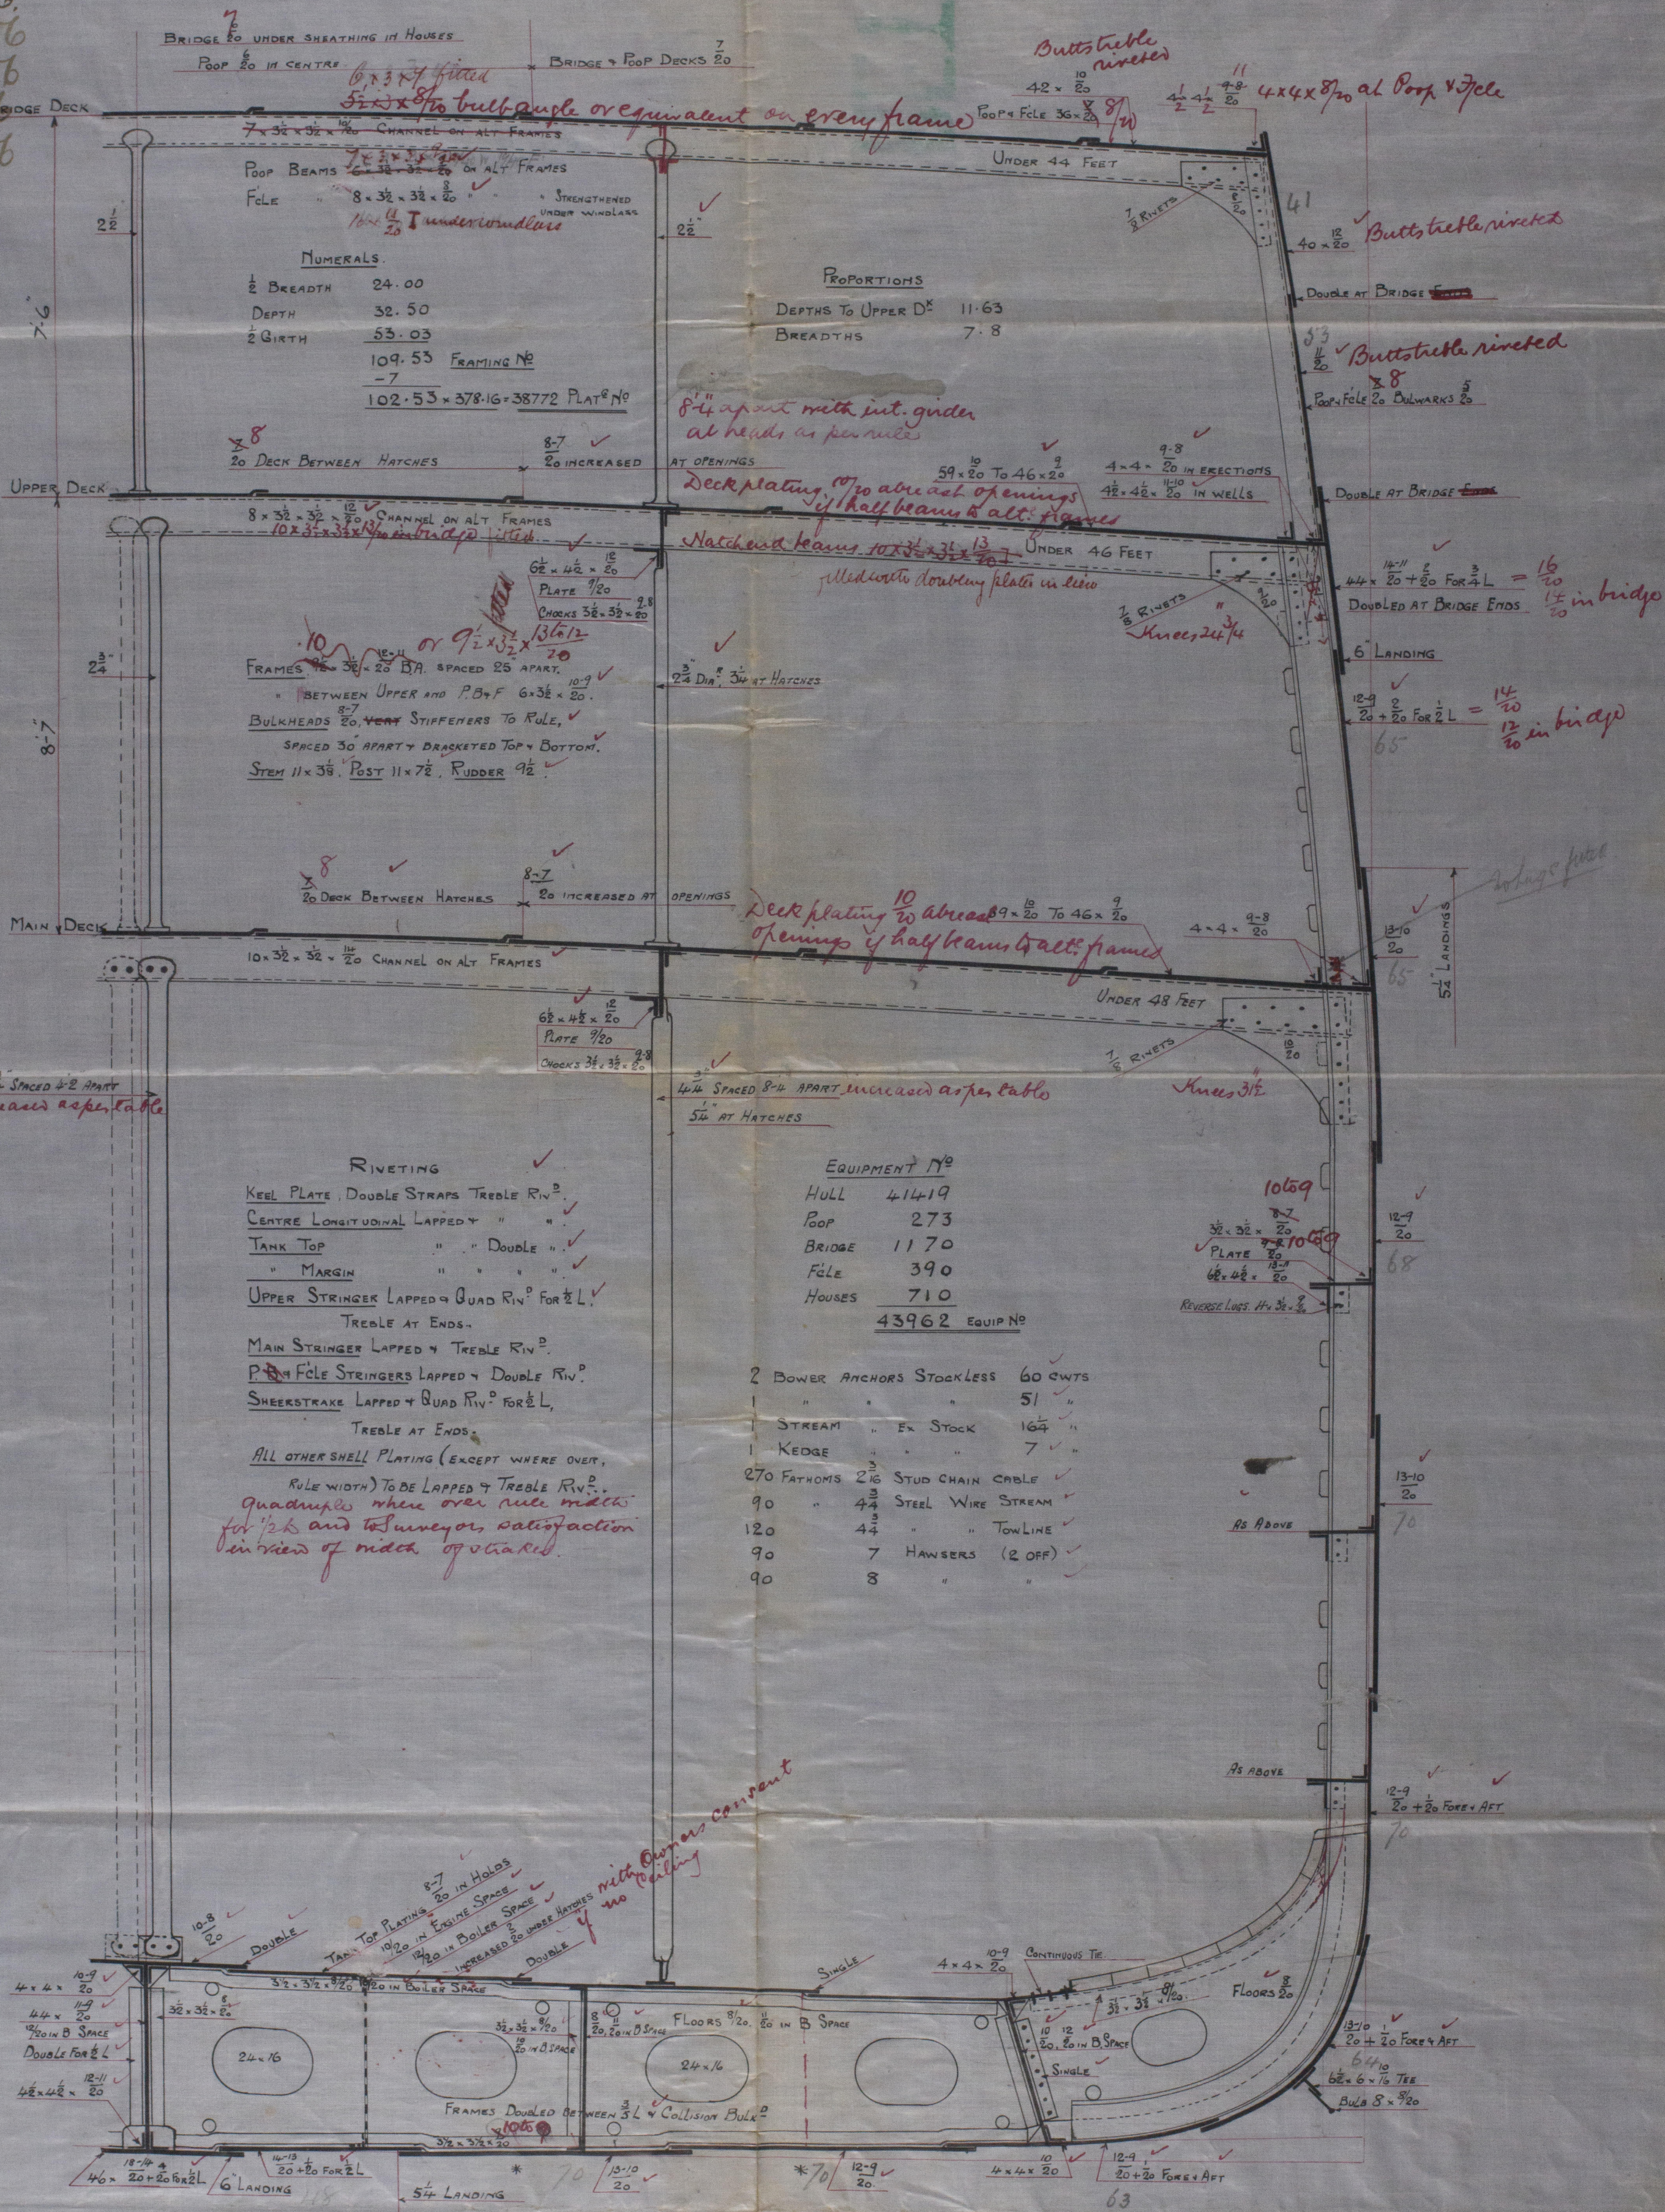

C.B.
12.1.06




Lloyd's Register Foundation

Messrs Workman Clark & Co

SS. 237

Midship Section

S/S Howth Head

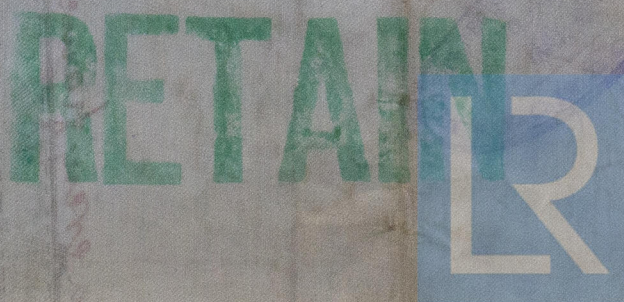

© 2020

Lloyd's Register
WFS9 01637