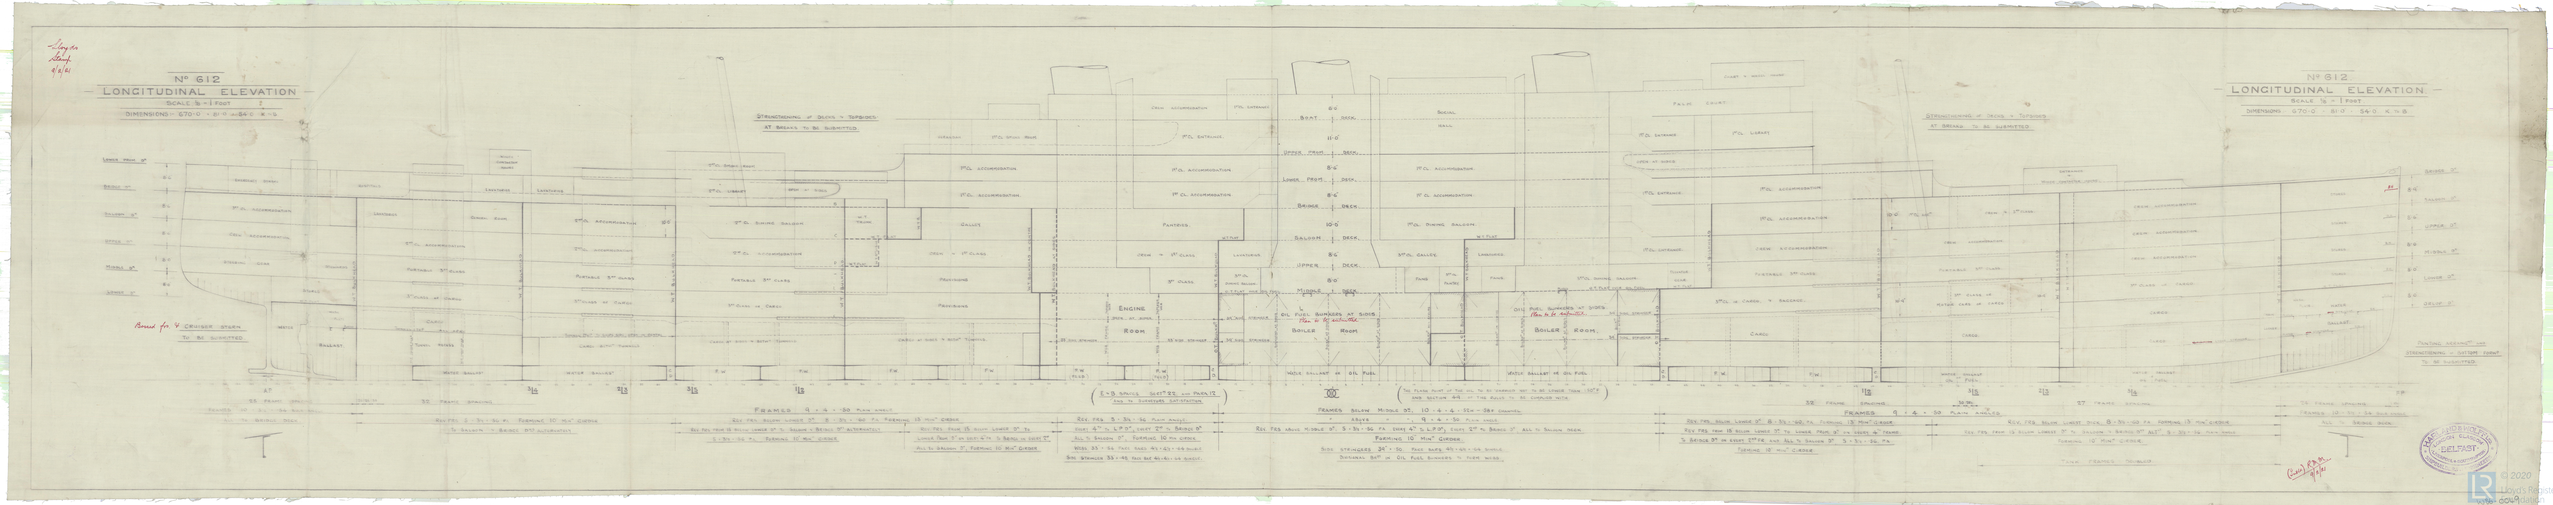

Nº 612
LONGITUDINAL ELEVATION
SCALE 1/8 = 1 FOOT
DIMENSIONS 670·0 × 81·0 × 54·0 K.S.B.
STRENGTHENING OF DECKS & TOPSIDES AT BREAKS TO BE SUBMITTED
Bossed for 4 CRUISER STERN TO BE SUBMITTED
ENGINE ROOM
BOILER ROOM
OIL FUEL BUNKERS AT SIDES
FRAMES 9 × 4 × 50 PLAIN ANGLES
FRAMES 9 × 4 × 50 PLAIN ANGLES
HARLAND & WOLFF
BELFAST

612

Harland & Wolff

~~Gen Box. 3481~~

Profile & Decks

~~310~~

GEN. BOX Nº

W86-0049

© 2020
Lloyd's Register
Foundation