


SCALE:- $\frac{1''}{8} = 1 \text{ FOOT.}$

~~TO CLASS 100 A1 WITH FREEBOARD CORRESPONDING TO THE DRAFT
CONTEMPLATED BY THE RULES FOR A C.S.S. VESSEL WITH TONNAGE OPENING
TIMBER FREEBOARD ALSO REQUIRED.~~

ALEXANDER STEPHEN & SONS LTD
SHIPBUILDERS & ENGINEERS
GLASGOW

MASTS, WINCHES, WINDLABS, DECKHOUSES, STEERING GEAR, E
SUPPORTED TO SURVEYORS SATISFACTION

 

APPROVED
LLOYD'S REGISTER OF SHIPPING
Hickman DATE 3637

2, x

Glasgow

Messrs. Alex. Stephen & Son Ltd

nos 561/2

Profile Decks.

Prelim. Hbd

GLASGOW/REPORT No 58561

561 Hbd

GLASGOW/REPORT No 60408


561 "Surat"

GLASGOW REPORT No 60460 460484

562 "Shillong"

GLASGOW REPORT No 60682

W82-0120

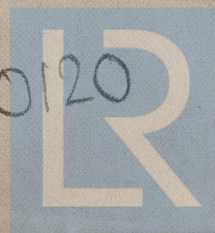

© 2020

Lloyd's Register
Foundation