


s/s Kirkham abbey

Hull Report No. 19969

No 542.
STAR ^{BD} BOILER.

POSITION OF STAYS IN STEAM SPACE.

STAYS SHOWN IN RED AS ACTUALLY FITTED.

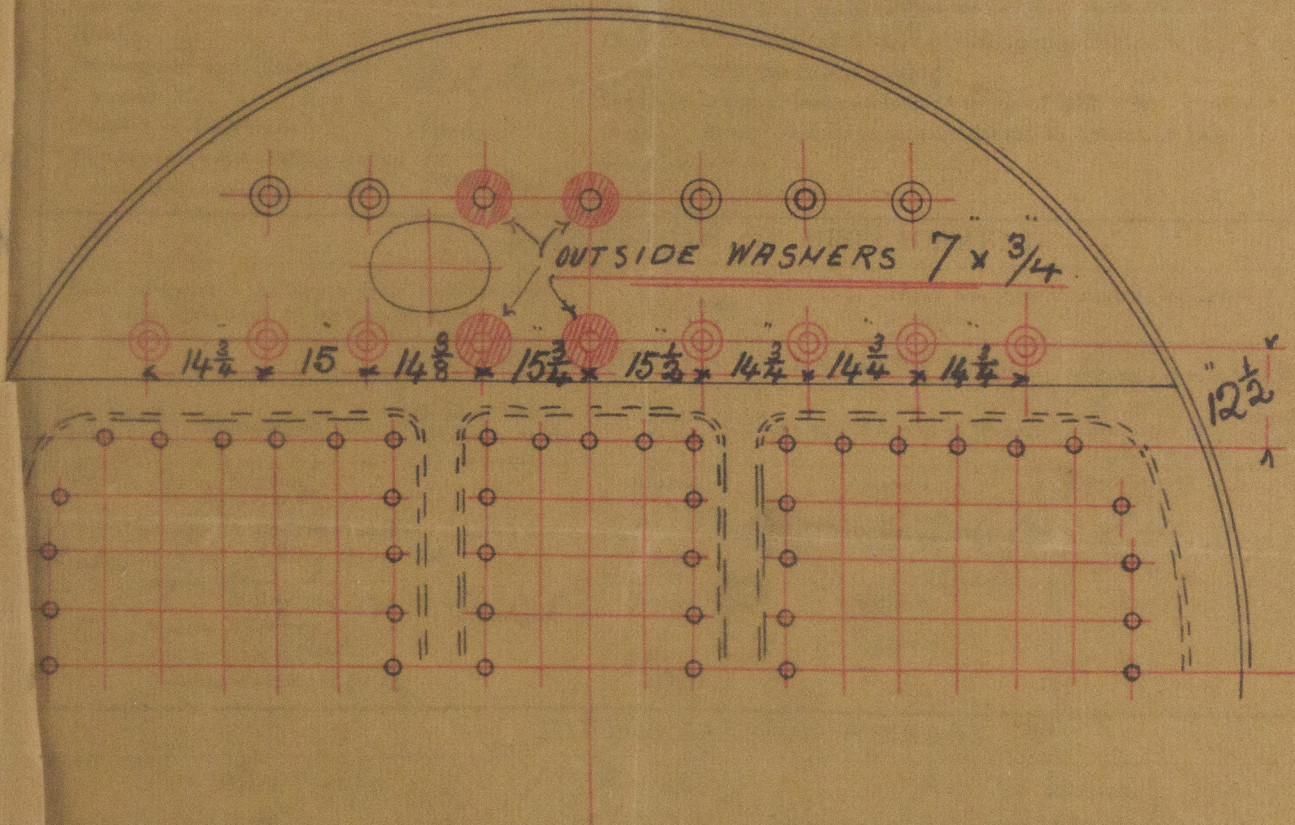

RING ON BACK OF BOILER.

7603. B.
8.4.08



© 2020

Lloyd's Register
Foundation

W860-0020