

24.3.08.

NUMERALS.

1/2 BEAM.	10.67.
DEPTH	12.96
1/2 GIRTH.	19.25
1st. No	42.88
LENGTH.	118.87
2nd No.	5097.94

$\frac{L}{B} = 5.57$ $\frac{L}{D} = 9.17$

Nos 819 & 391

MIDSHIP SECTION

OF TWO

STEEL SCREW TRAWLER.

TO CLASS 100 A.I. LLOYDS.


DIMENSIONS. 120'-0" B.P. x 21'-6" EXT. x 12'-6" MOULDED.

SCALE 1/2" = 1 FOOT.

EQUIPMENT.

1 ANCHOR.	5 1/4 CWTs.	EX STOCK OR 1/2 STOCKLESS
1 "	4 3/4 "	" " " " " " " "
1 "	2 1/2 "	" " " " " " " "
30 FATHOMS	1" STUDLINK CHAIN	
60 "	6" HAWSER OR 2 1/4" STEEL WIRE	
60 "	4 1/2" WARP " 1 1/4 "	

6.2.7.

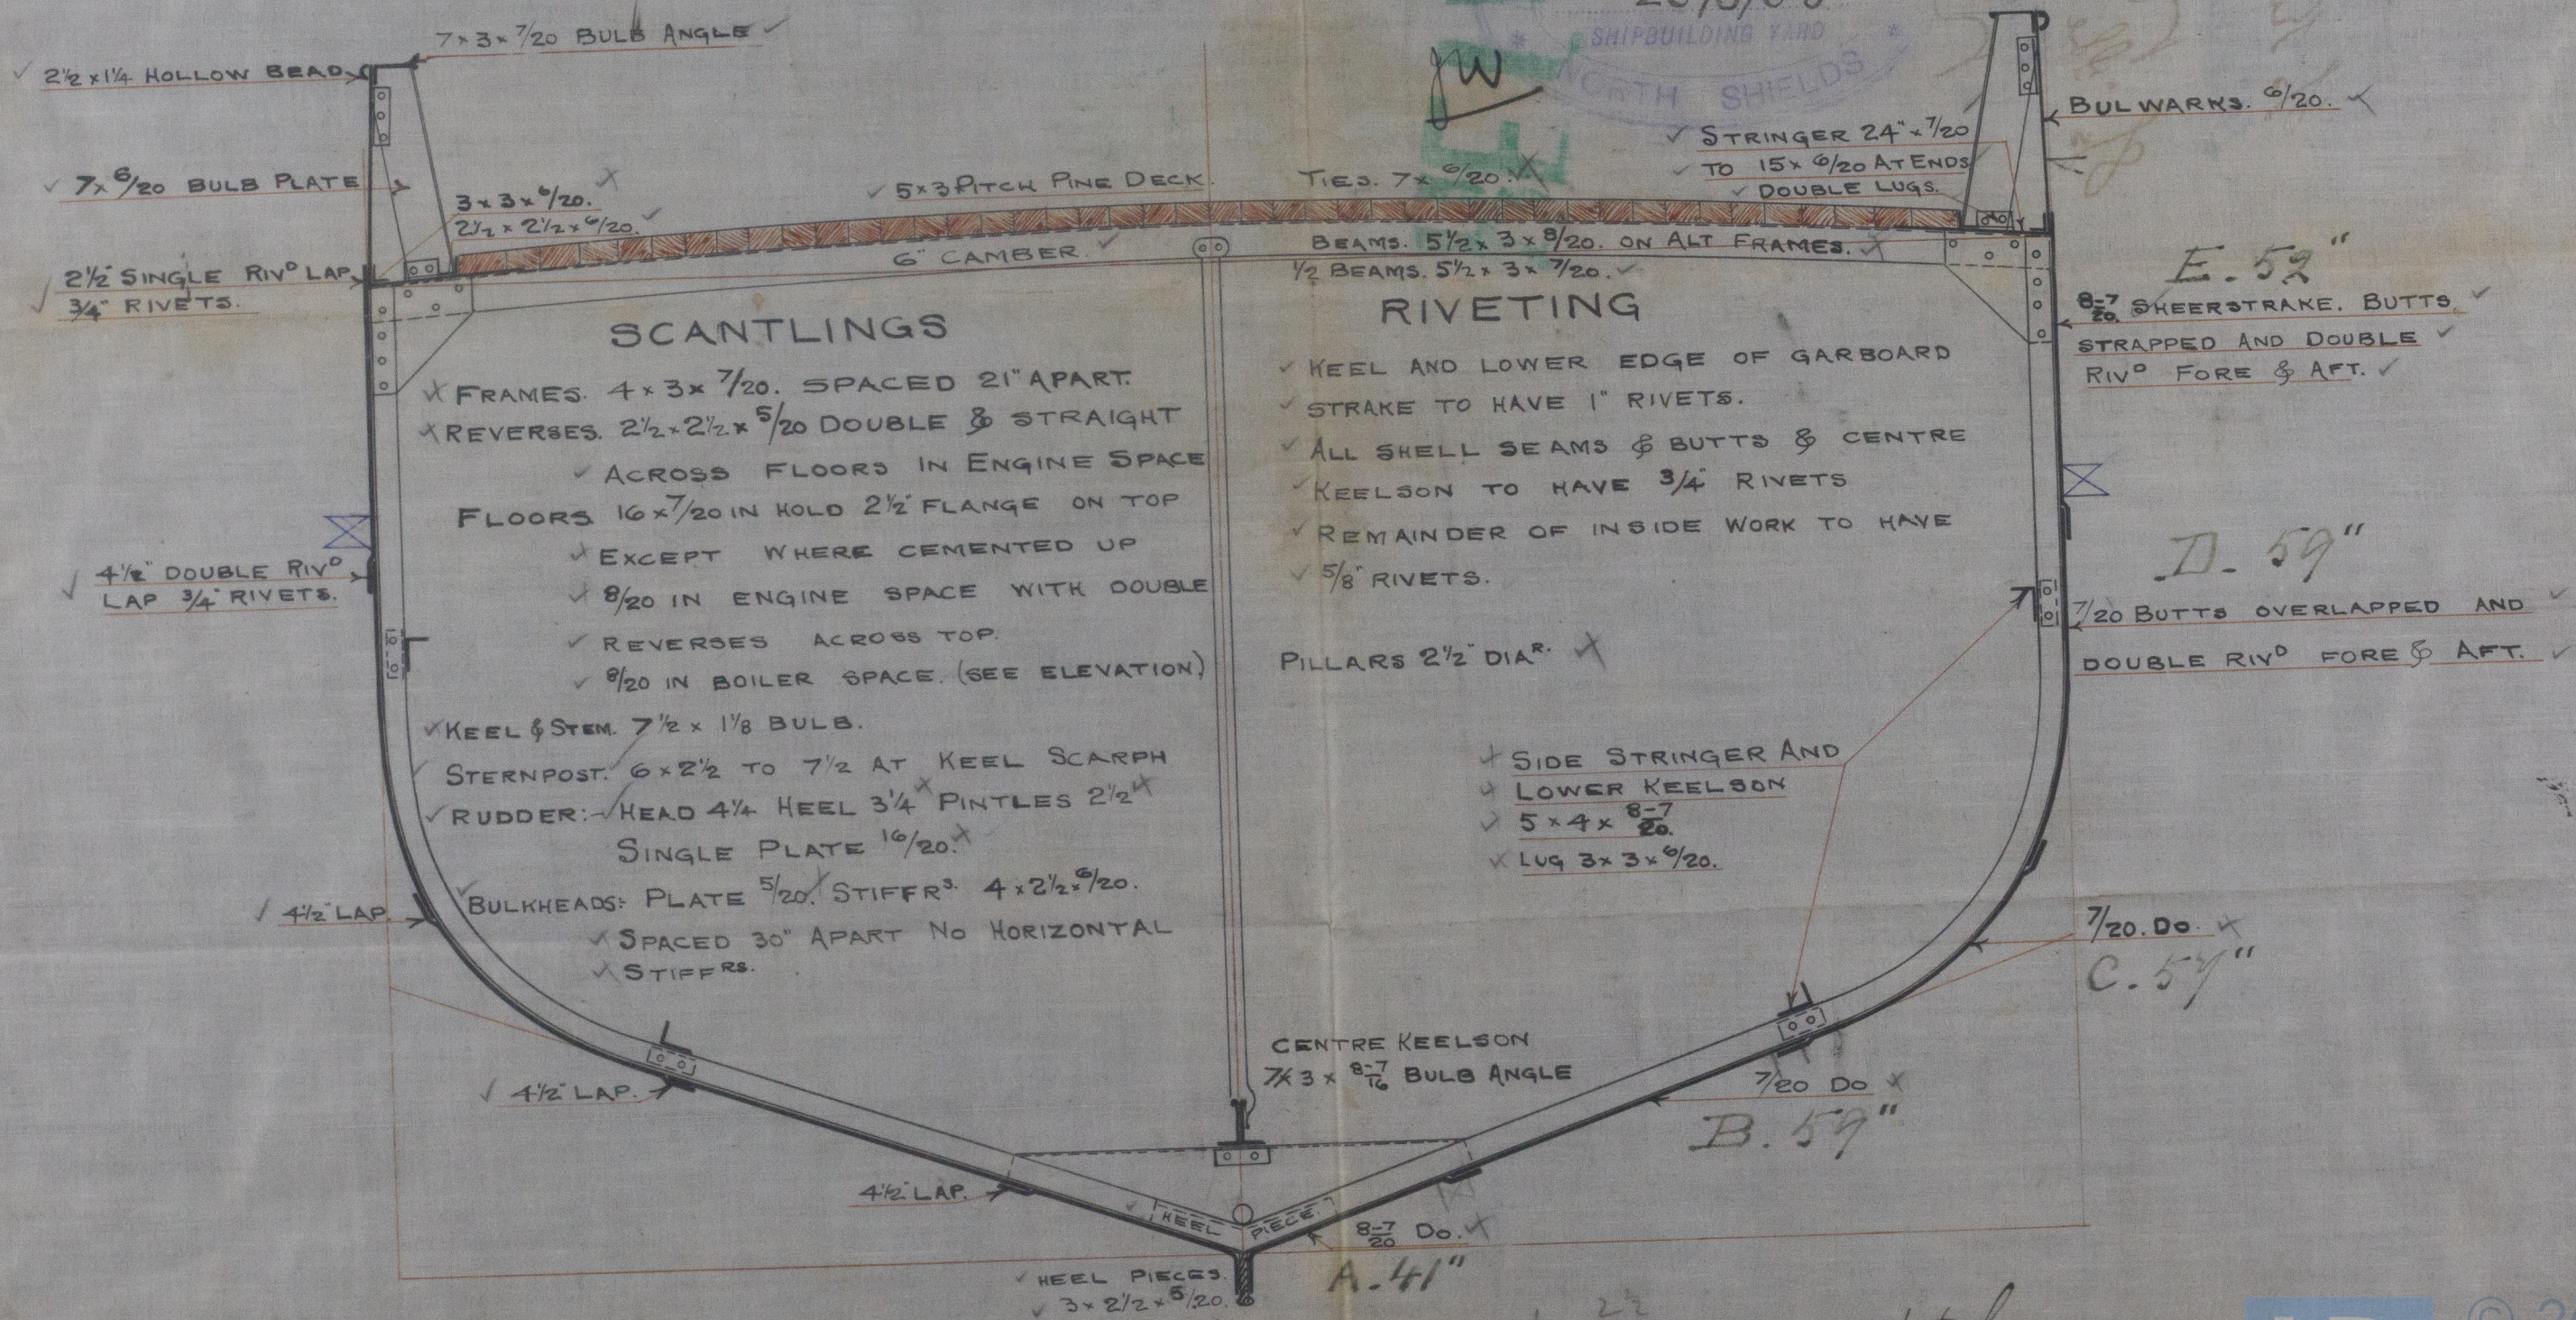


SMITH'S DOCK CO.
PRINT No. 708
20/3/08
SHIPBUILDING YARD
NORTH SHIELDS

120
118
116
114
112
110
108
106
104
102
100
98
96
94
92
90
88
86
84
82
80
78
76
74
72
70
68
66
64
62
60
58
56
54
52
50
48
46
44
42
40
38
36
34
32
30
28
26
24
22
20
18
16
14
12
10
8
6
4
2
0

E. 52"
D. 59"
C. 57"
B. 59"
A. 41"

Smith's Dock Co..
Nos. 819 & 391
Section

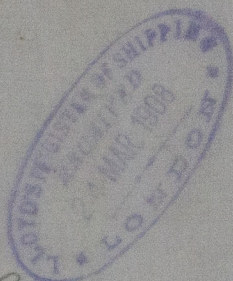

St. Kirkland
Newcastle-on-Tyne.

No. 55743.
St. "The Norman"
Newcastle-on-Tyne.
No. 55854



© 2020

Lloyd's Register
Foundation

W861-0171