



24.3.08.

Wm. D. & Co.
108 & 110
24.3.08

N^{os} 819 & 391.
ELEVATION

DIMENSIONS: - 120'-0" B.P. x 21'-6" E x T. x 12'-6" MLD.

$\frac{1}{4}" = 1 \text{ FOOT.}$

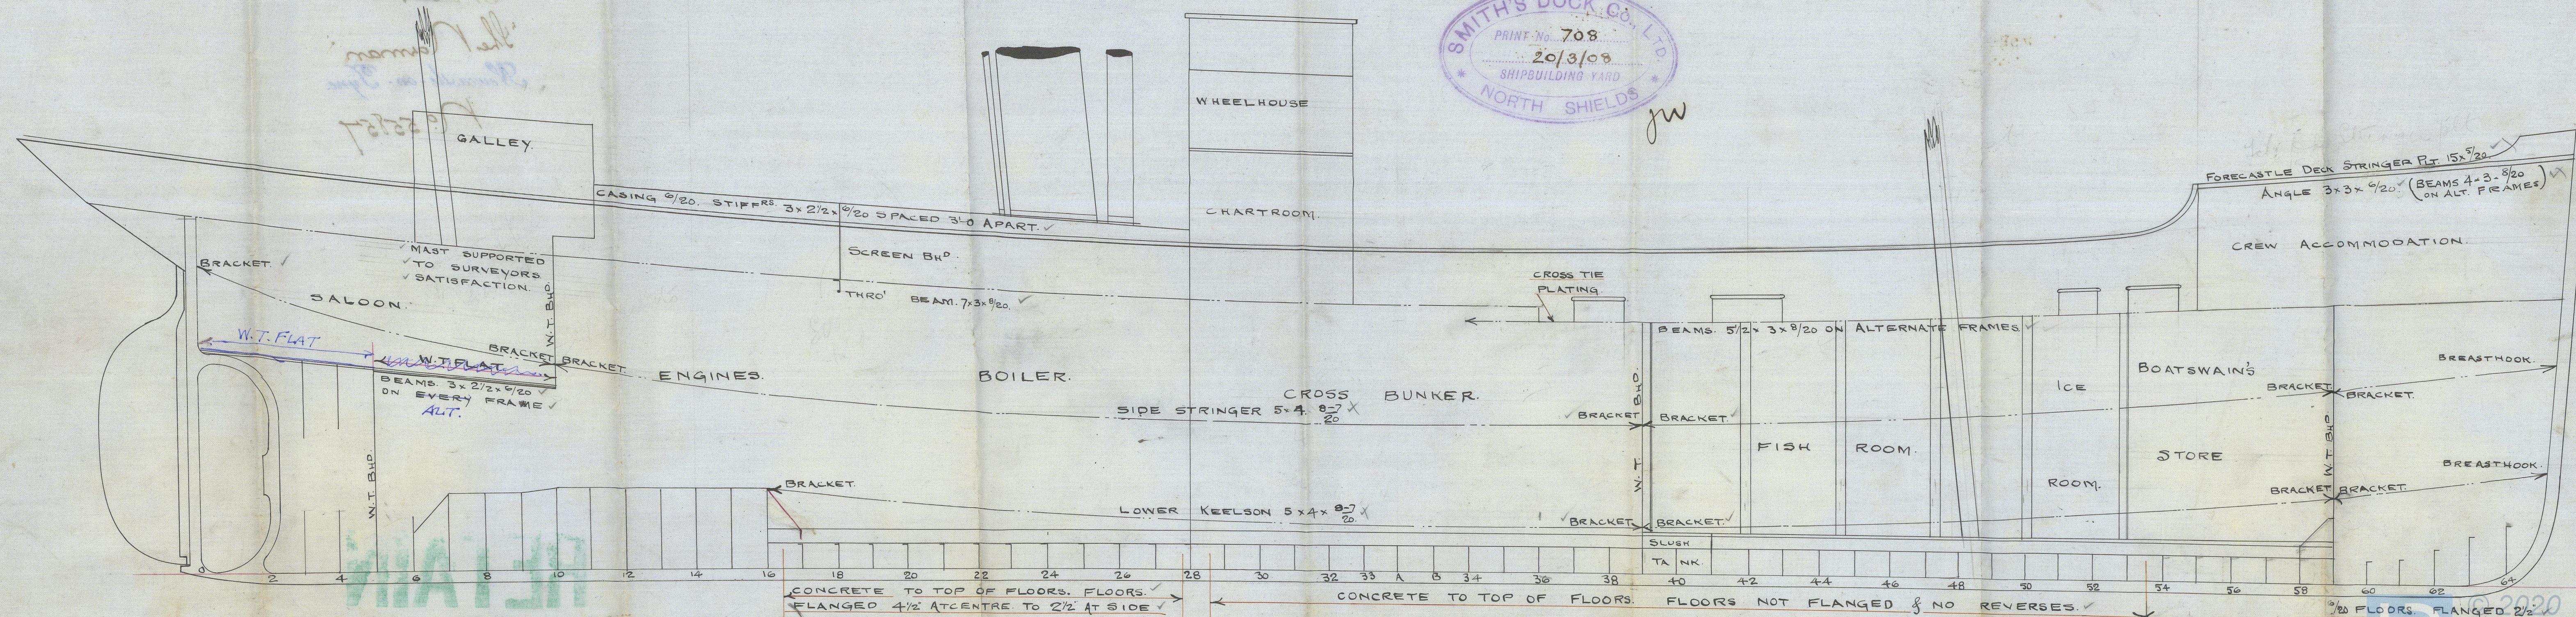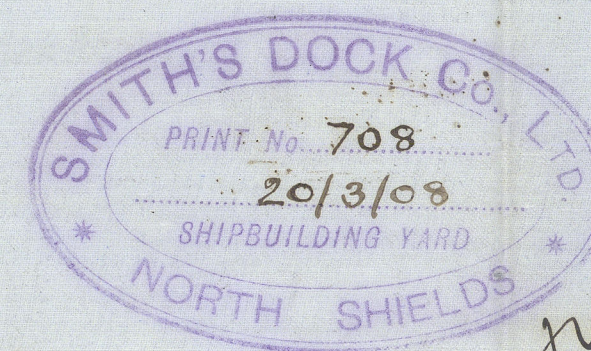

Pillars throughout to Surveyor's Satisfaction

24/3/08

Smith's Locks Co..
No. 819 & 391
Profile

J. S. "Kirkland"

Newcastle Report

No 55743.

"The Norman"
Newcastle-on-Tyne.

No 55857

REMAIN



© 2020

Lloyd's Register
Foundation

4/3/08