
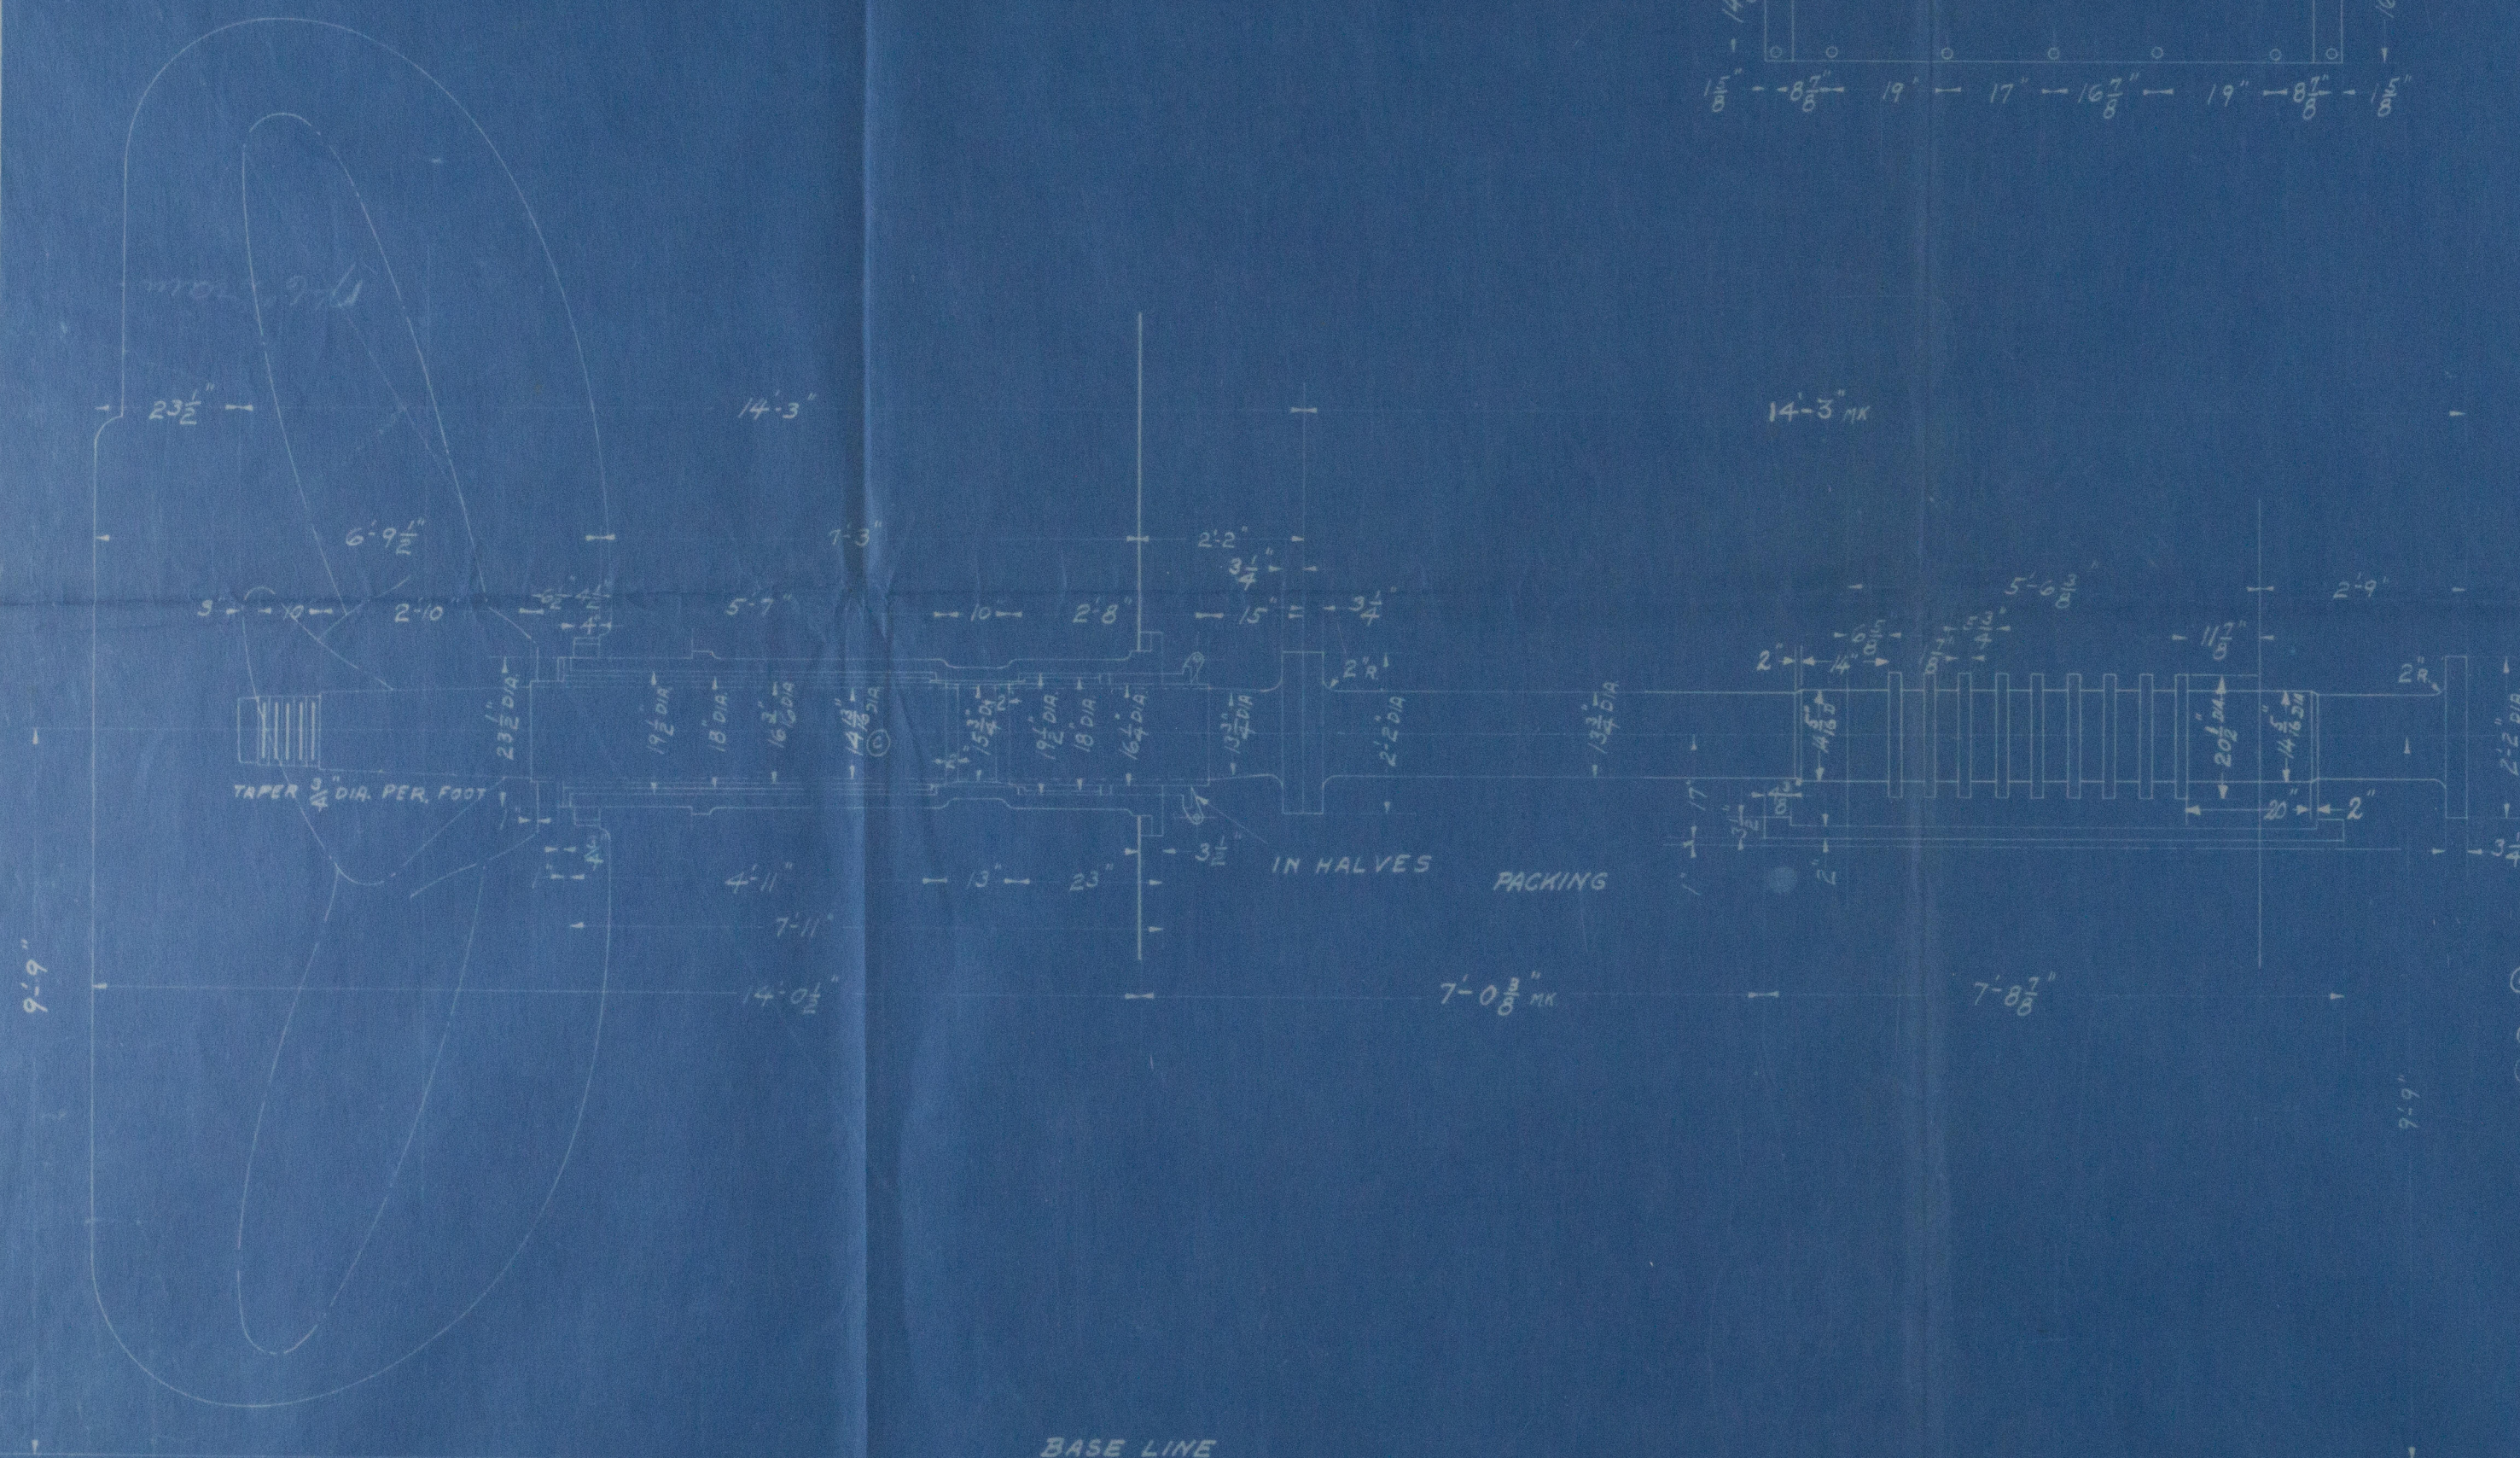


B-249-24-A
B-247-24-A

B-249-24-A
B-247-24-A

1000
84 RPM

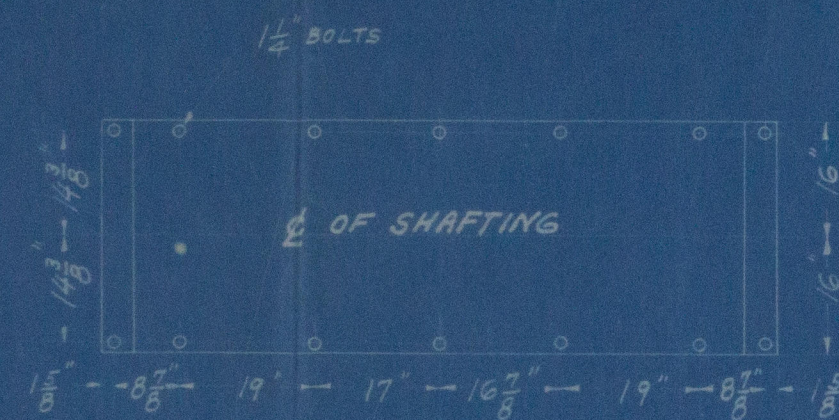

ARRANGEMENT AS SHOWN

ARRANGEMENT OF THRUST & PROPELLER SHAFTS

SCALE: 1/2" = 1 FT. DATE: 4-15-15

FORE RIVER SHIPBUILDING CORP.

QUINCY, MASS.

IN CHARGE N.W. CHECKED BY N.W. (initials)
DRAWN BY N.O.K. CHIEF DRAFTSMAN
TRACED BY J.L.C. APPROVED (initials)

ALTERATION	DATE	NOTED	APPROVED	PRINTS										
① SHAFTING CHANGED TO SUIT LLOYDS INSPECTOR	6-4-15 N.O.K.			DATE	B	D	I	M	N	PA	V	CA	HT	REC
② CONT. #249 ADDED	6-29-15 N.O.K.			4-15-15						1-A				
③ DIA. OF PROPELLER SHAFT CHANGED FROM 14 1/4" TO 14 13/16"	7-27-15 N.O.K.			5-18-15										
				5-28-15										
				6-1-15										
				7-6-15										
				7-22-15										
				7-27-15										

B-249-24-A
B-247-24-A

B-249-24-A
B-247-24-A

FORE RIVER HILLS 2479-52.


ARRANGEMENT OF THRUST
AND PROPELLER SHAFTING

S.S. "MIELE RO," BOSTON REPORT 899,

SISTER SHIP TO S.S. "CLUBADIST,"

BOSTON REPORT 852. AND

S.S. "SLICROSH," BOSTON REPORT 859.

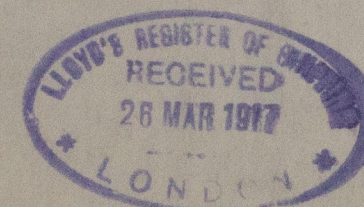

RETAIN

W862 -0082

JUL 30 1916



© 2020
Lloyd's Register
Foundation