

N° 525

- MIDSHIP SECTION. -


- DIMS. 135'0" x 22'4" MLD. x 13'4" MOULDED. -

- STEEL CLASS 100 A.I. FOR FISHING PURPOSES. -

- $\frac{1}{2}$ = ONE FOOT. -

9.5.06
19.5.06.
13.11.06

DEPTH = 20'70"
BREADTH = 11'17"
DEPTH = 13'83"
45'70" = 1ST NO.
133'792
91'40
41'130
31'990
13'710
13'710
45'70
61'1429440 = 2ND NO.

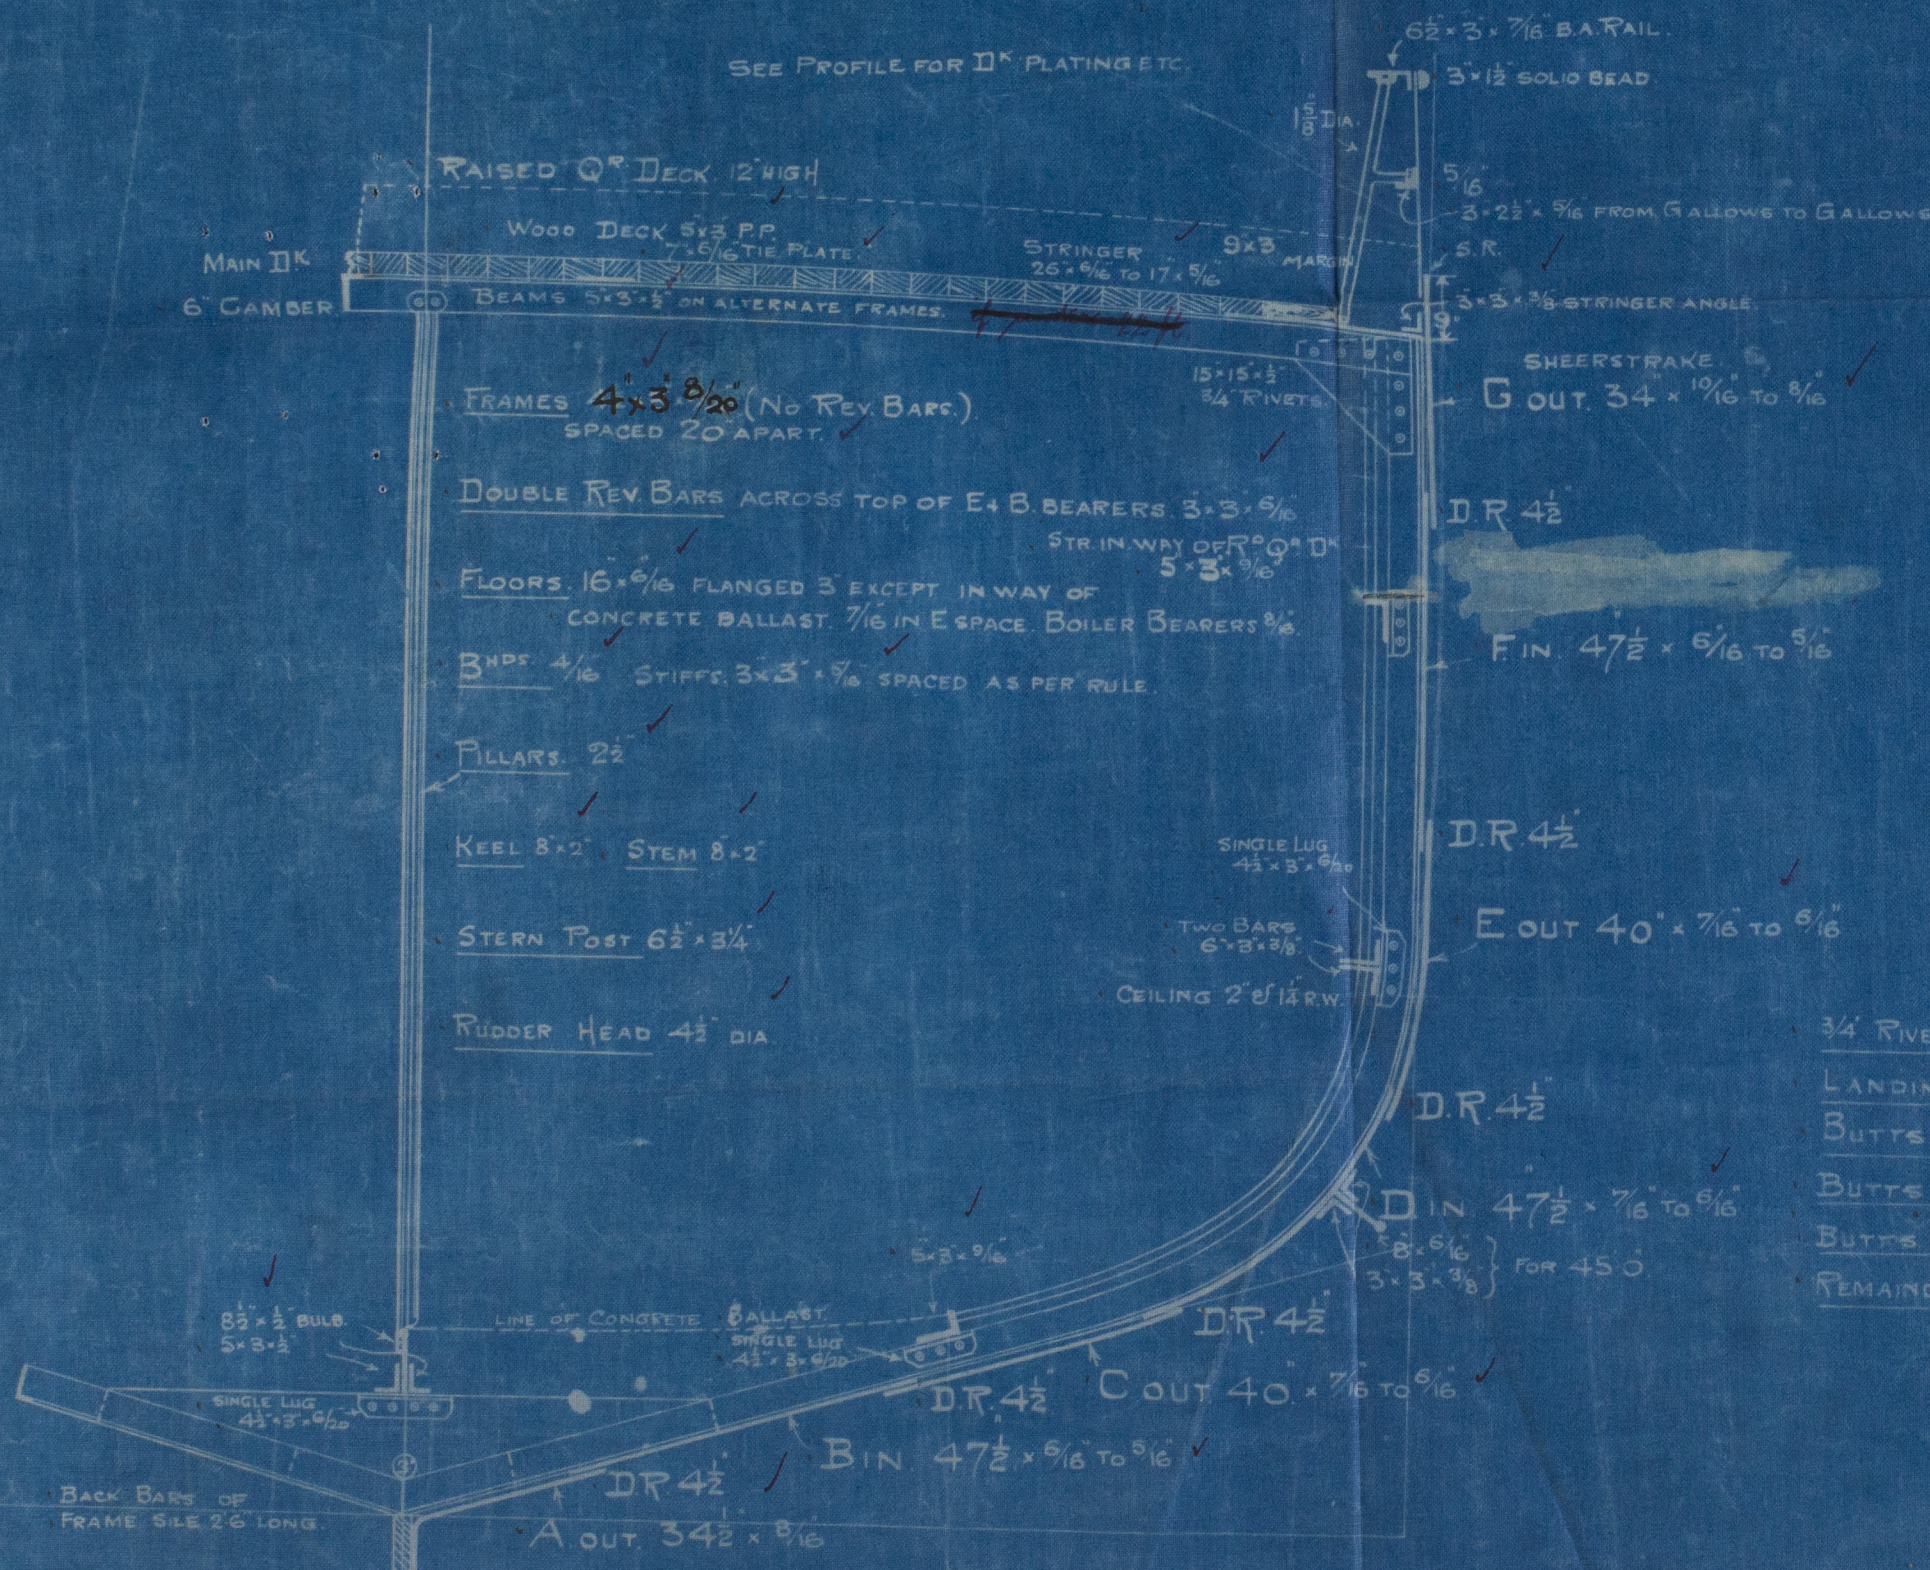

EQUIPMENT

ONE ANCHOR 6 CNTS EX STOCK
" 5 1/2 " "
" 3 " "
120 FATHOMS 1 1/8" CHAIN
60 " 6" HAWSER
60 " 5" WARP

RIVETING

3/4" RIVETS THROUGHOUT FOR SHELL
LANDINGS D.R. 4 1/2
BUTTS OF STR. PLATE D.R. 5/8 4 1/4" WIDE
BUTTS OF SHEER STRAKE STRAPPED D.R.
3/4 1 1/2 3/4 RIVETS
BUTTS OF GARB STRAKES STRAPPED D.R.
3/4 1 1/2 3/4 RIVETS
REMAINDER OF SHELL BUTTS LAPPED D.R.

C.B.
9.5.06.




Lloyd's Register
W363-0076

Earle's S. & C.

Nº 525.

Midship Section.

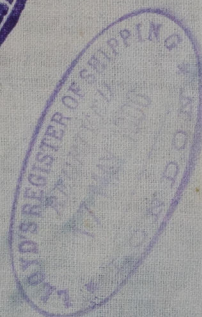

s/s 'Myton'

Hull Report No. 18539



Nº 525



© 2020

Lloyd's Register
Foundation

W863-0096