

* DOUBLING PLATE SEE
ARRGT. OF FOLE. DX. 159-209

PATTERN NO H-2
DRWG. NO S-301-2
20" DOUBLING 4" 5" x 25"

3" x 3" x 7.2"


8" HAND HOLE DRWG. NO S-307-2
PATTERN NO H-50

FOR DETAIL OF STRENGTHENING
UNDER WINDLASS SEE DRAWING
159-314

18" SCUTTLE DRWG. S-307-2
PATTERN NO H-51

NOTE: - DECK BEAMS 6" x 3 1/2" x 15" CHAN.

Capt. Approved.

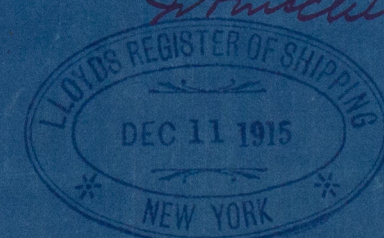

HULL NO 159
FORECASTLE DECK STEEL PLAN

Great Lakes Engineering Works.

DETROIT, MICH.
HULL DEPT.
Drawn by A.P.
Traced by A.P.
Checked by S.B.K.
Date APR. 14-'15



Lloyd's Register
Foundation
W863-0130

159-361

S. S. "MUNISLA."
FORECASTLE DECK.
DETROIT REPORT N^o 9.

DETROIT

159

[Faint red handwritten text, possibly "159" or "159/159"]

GREAT LAKES
ENGINEERING
WORKS
17 NOV 17



© 2020

Lloyd's Register
Foundation