


FOR FORECASTLE
DECK SEE DR. 159-361

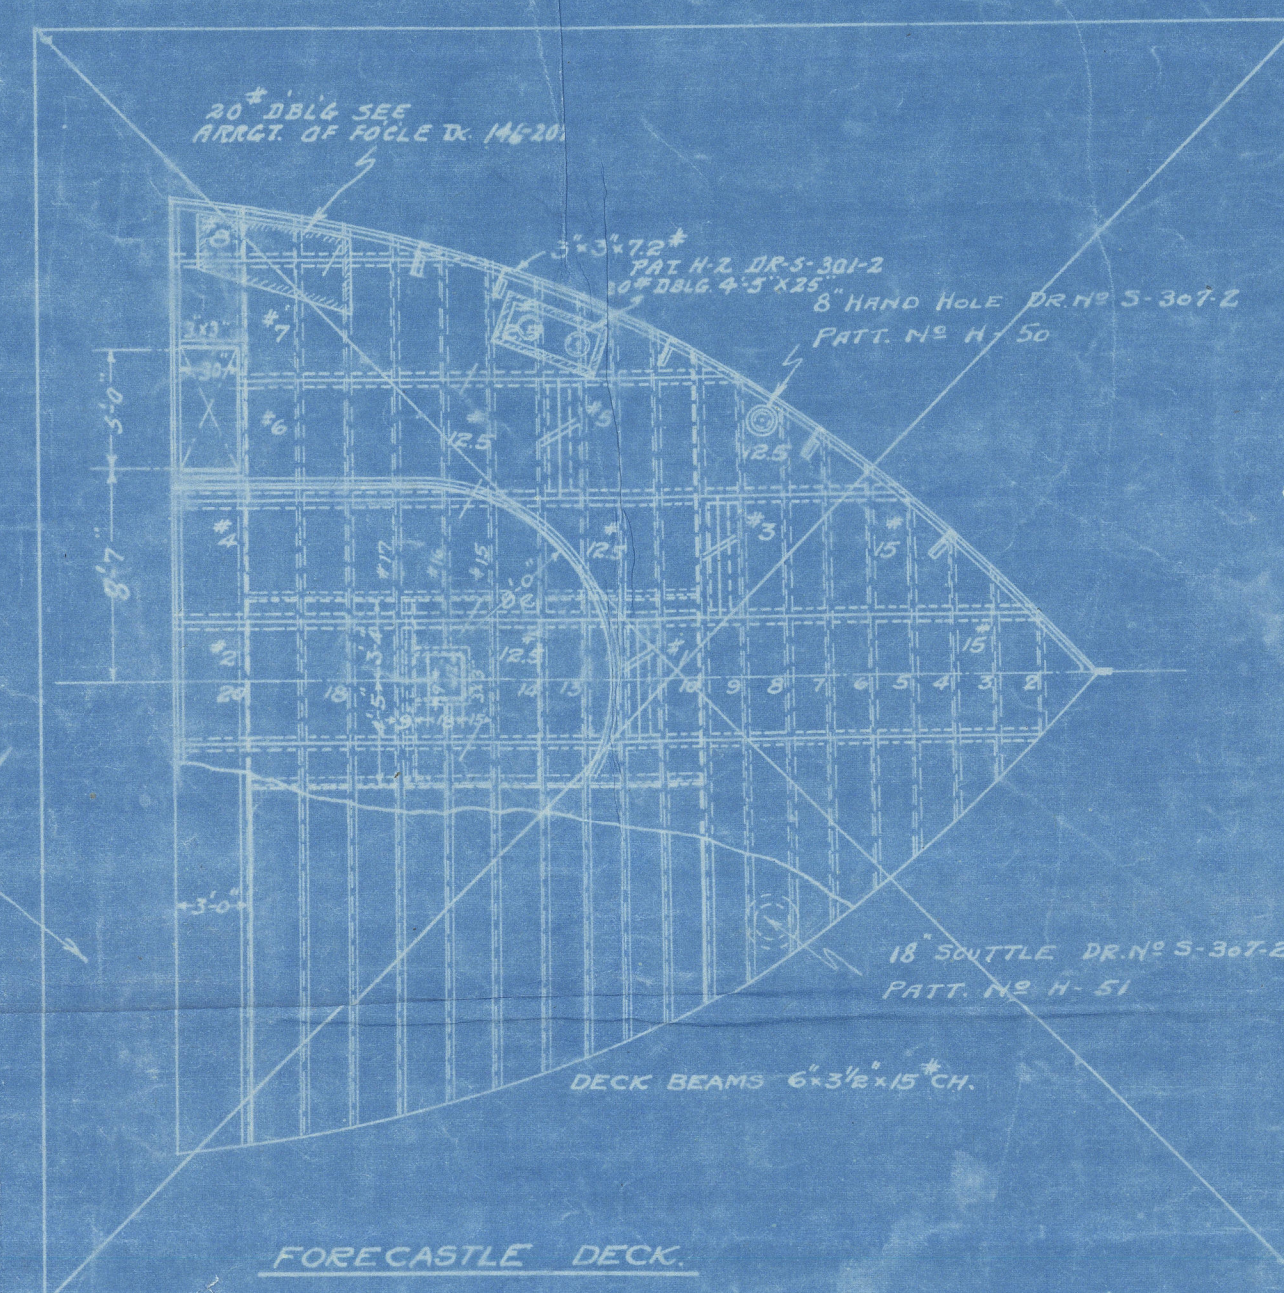

Copy. *Wm.*



CHANGES & ADDITIONS	
DATE	ITEM
12-20-15	INNER GUNW. BAR CUT AT 16 FR. & BOX END, SPARK.
	FRAMES 12-14 BKTD. TOP & BOTTOM, ON FACE.
	FRAMES 12-15 & 16 BKTD. TOP & BOT. KNEE BR'S.
12-30-15	FORE & AFT BIDS IN FUSEL. OUTBOARD 9"
MARCH 25-1916	SIZE OF HATCHES CHANGED

HULL No 159.

LOWER, SPAR, FORECASTLE STEEL DECKS.

Great Lakes Engineering Works.

DETROIT, MICH.
HULL DEPT.

Drawn by *W.M.*
Checked by *J.C.*

159-205

W863-0132

S. S. "MUNISLA"
DECK PLAN
DETROIT REPORT N^o 9.



RETAIN



© 2020

Lloyd's Register
Foundation