

N^o 138.

S. S. BENBROOK.


LONGITUDINAL SECTION

SCALE $\frac{1}{8}$ IN = ONE FOOT

TR N^o 9683.



DIMENSIONS.	
LENGTH B.P.	345'-0"
BREADTH MLD.	50'-11 $\frac{1}{2}$ "
DEPTH MLD TO MAIN DECK.	27'-9 $\frac{1}{2}$ "

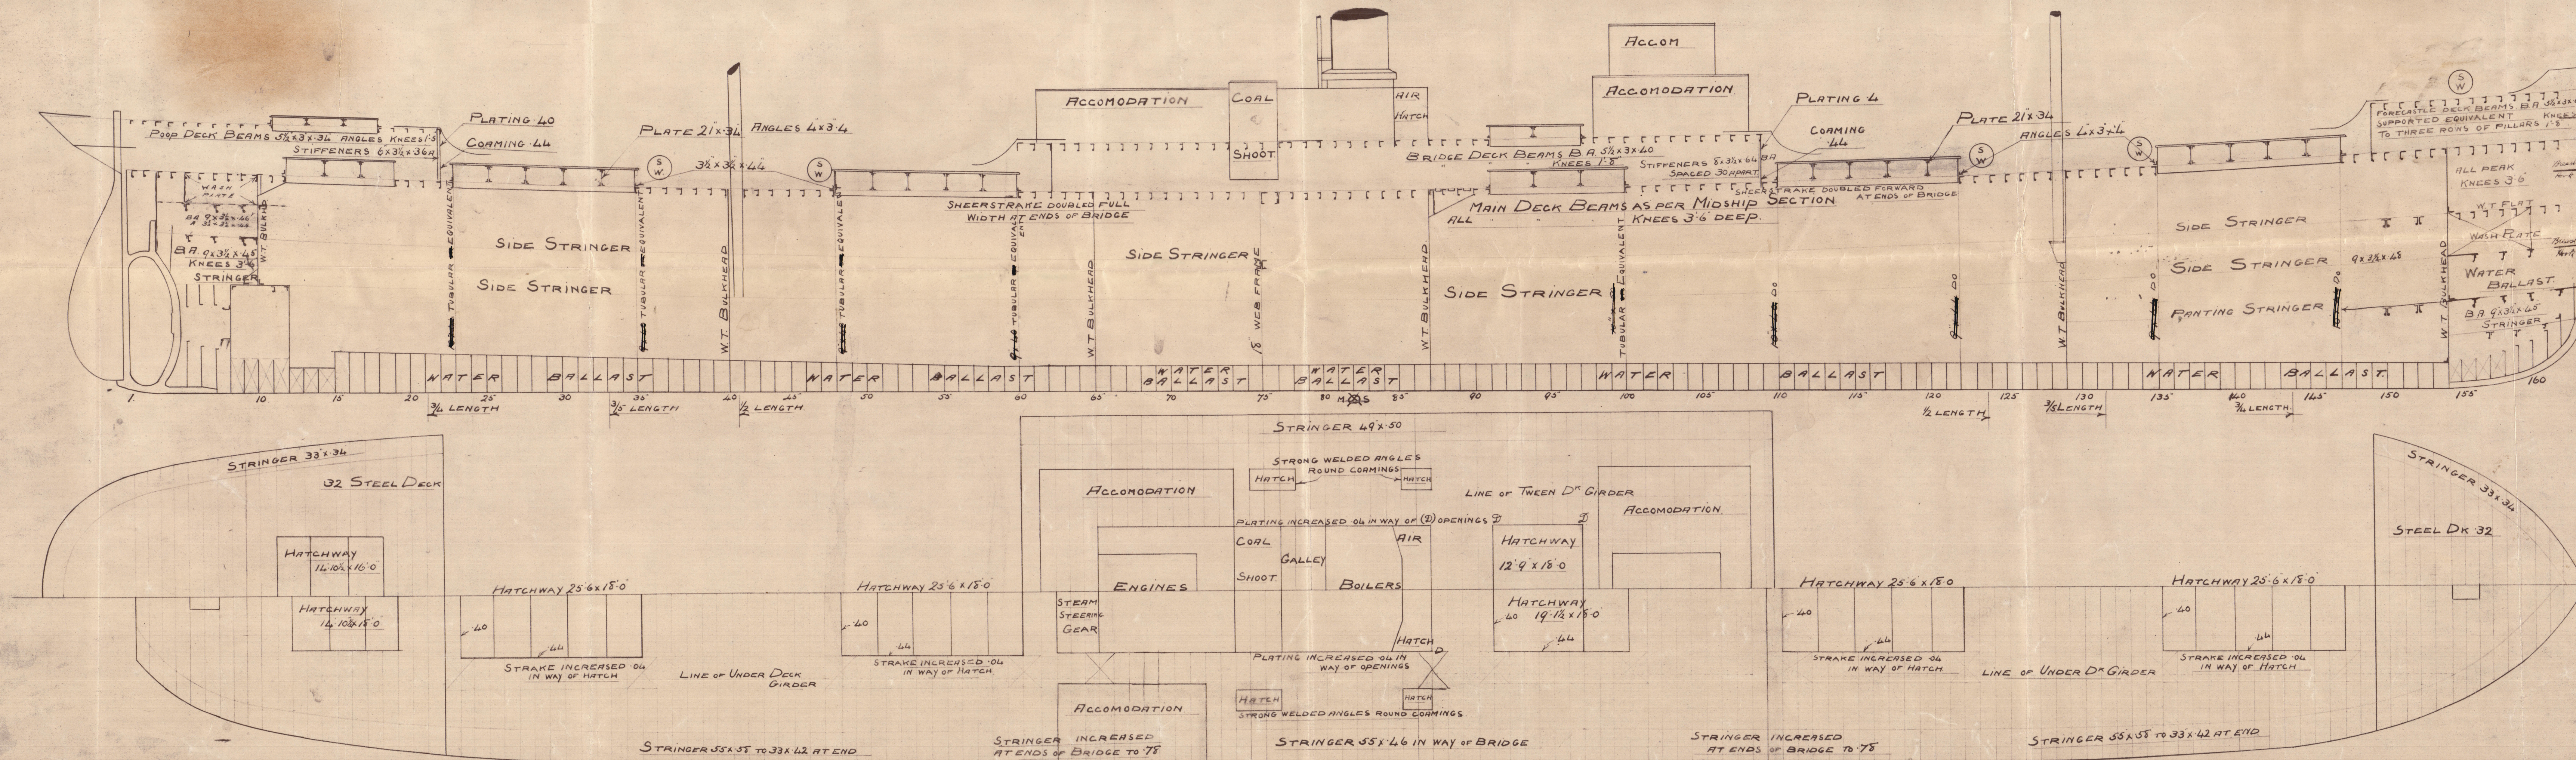

W864-0026

Craig, Taylor & Co.
No. 138

S. S. "Benbrook"
Profile & Deck Plans
as built.

Nav. Report No. 6128

RETAIN



© 2020

Lloyd's Register
Foundation