

LONGITUDINAL SECTION & DECK PLANS.


STEEL SINGLE SCREW STEAMER No 292.

MOULDED DIMENSIONS: - 257'-0" B.P. x 36'-0" x 17'-3" to MAIN D^{ck}

SCALE 1/8" = 1 FOOT.

22'-3" to QUARTER D^{ck}.


TO CLASS 100 A.I. AT LLOYDS.

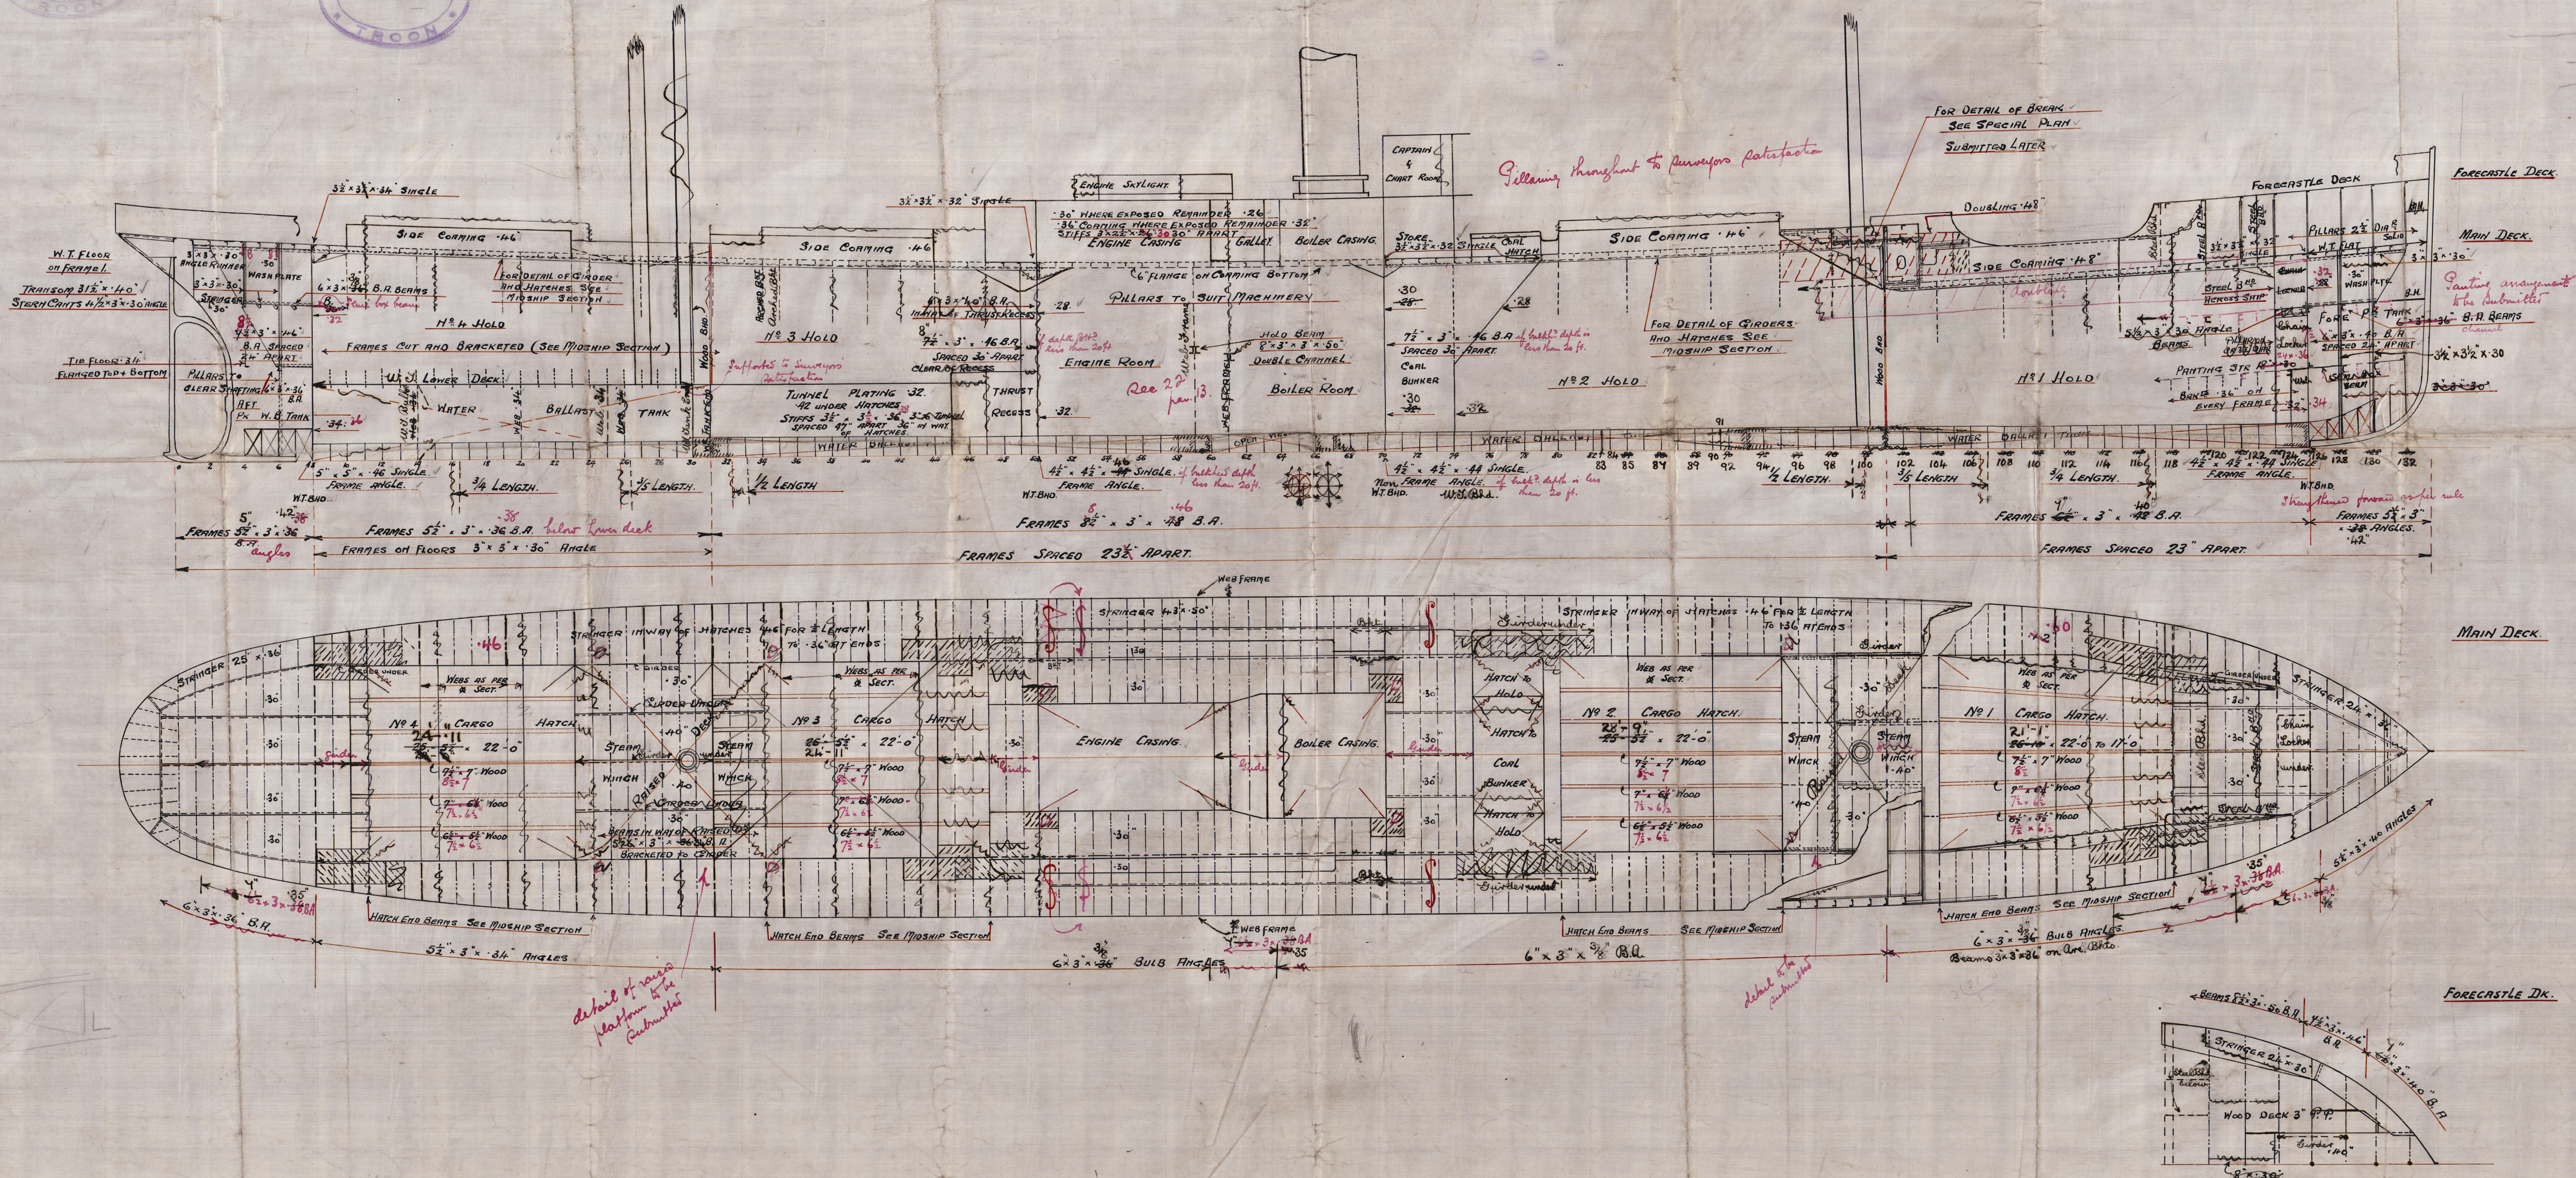

Aulsa S. B. 6^o

N^o 292

Profile + deck plan

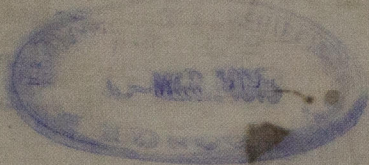

GLASGOW REPORT No. 36468

% Nantes



© 2020

Lloyd's Register
Foundation