



19.3.10

No 256 PROFILE & DECK PLANS.

SCALE 1/8" = 1 FOOT

PP. 20-23 SW


2117099

Mr. J. D. [unclear]

12221

Woodstock

1st 1st 1st 1st

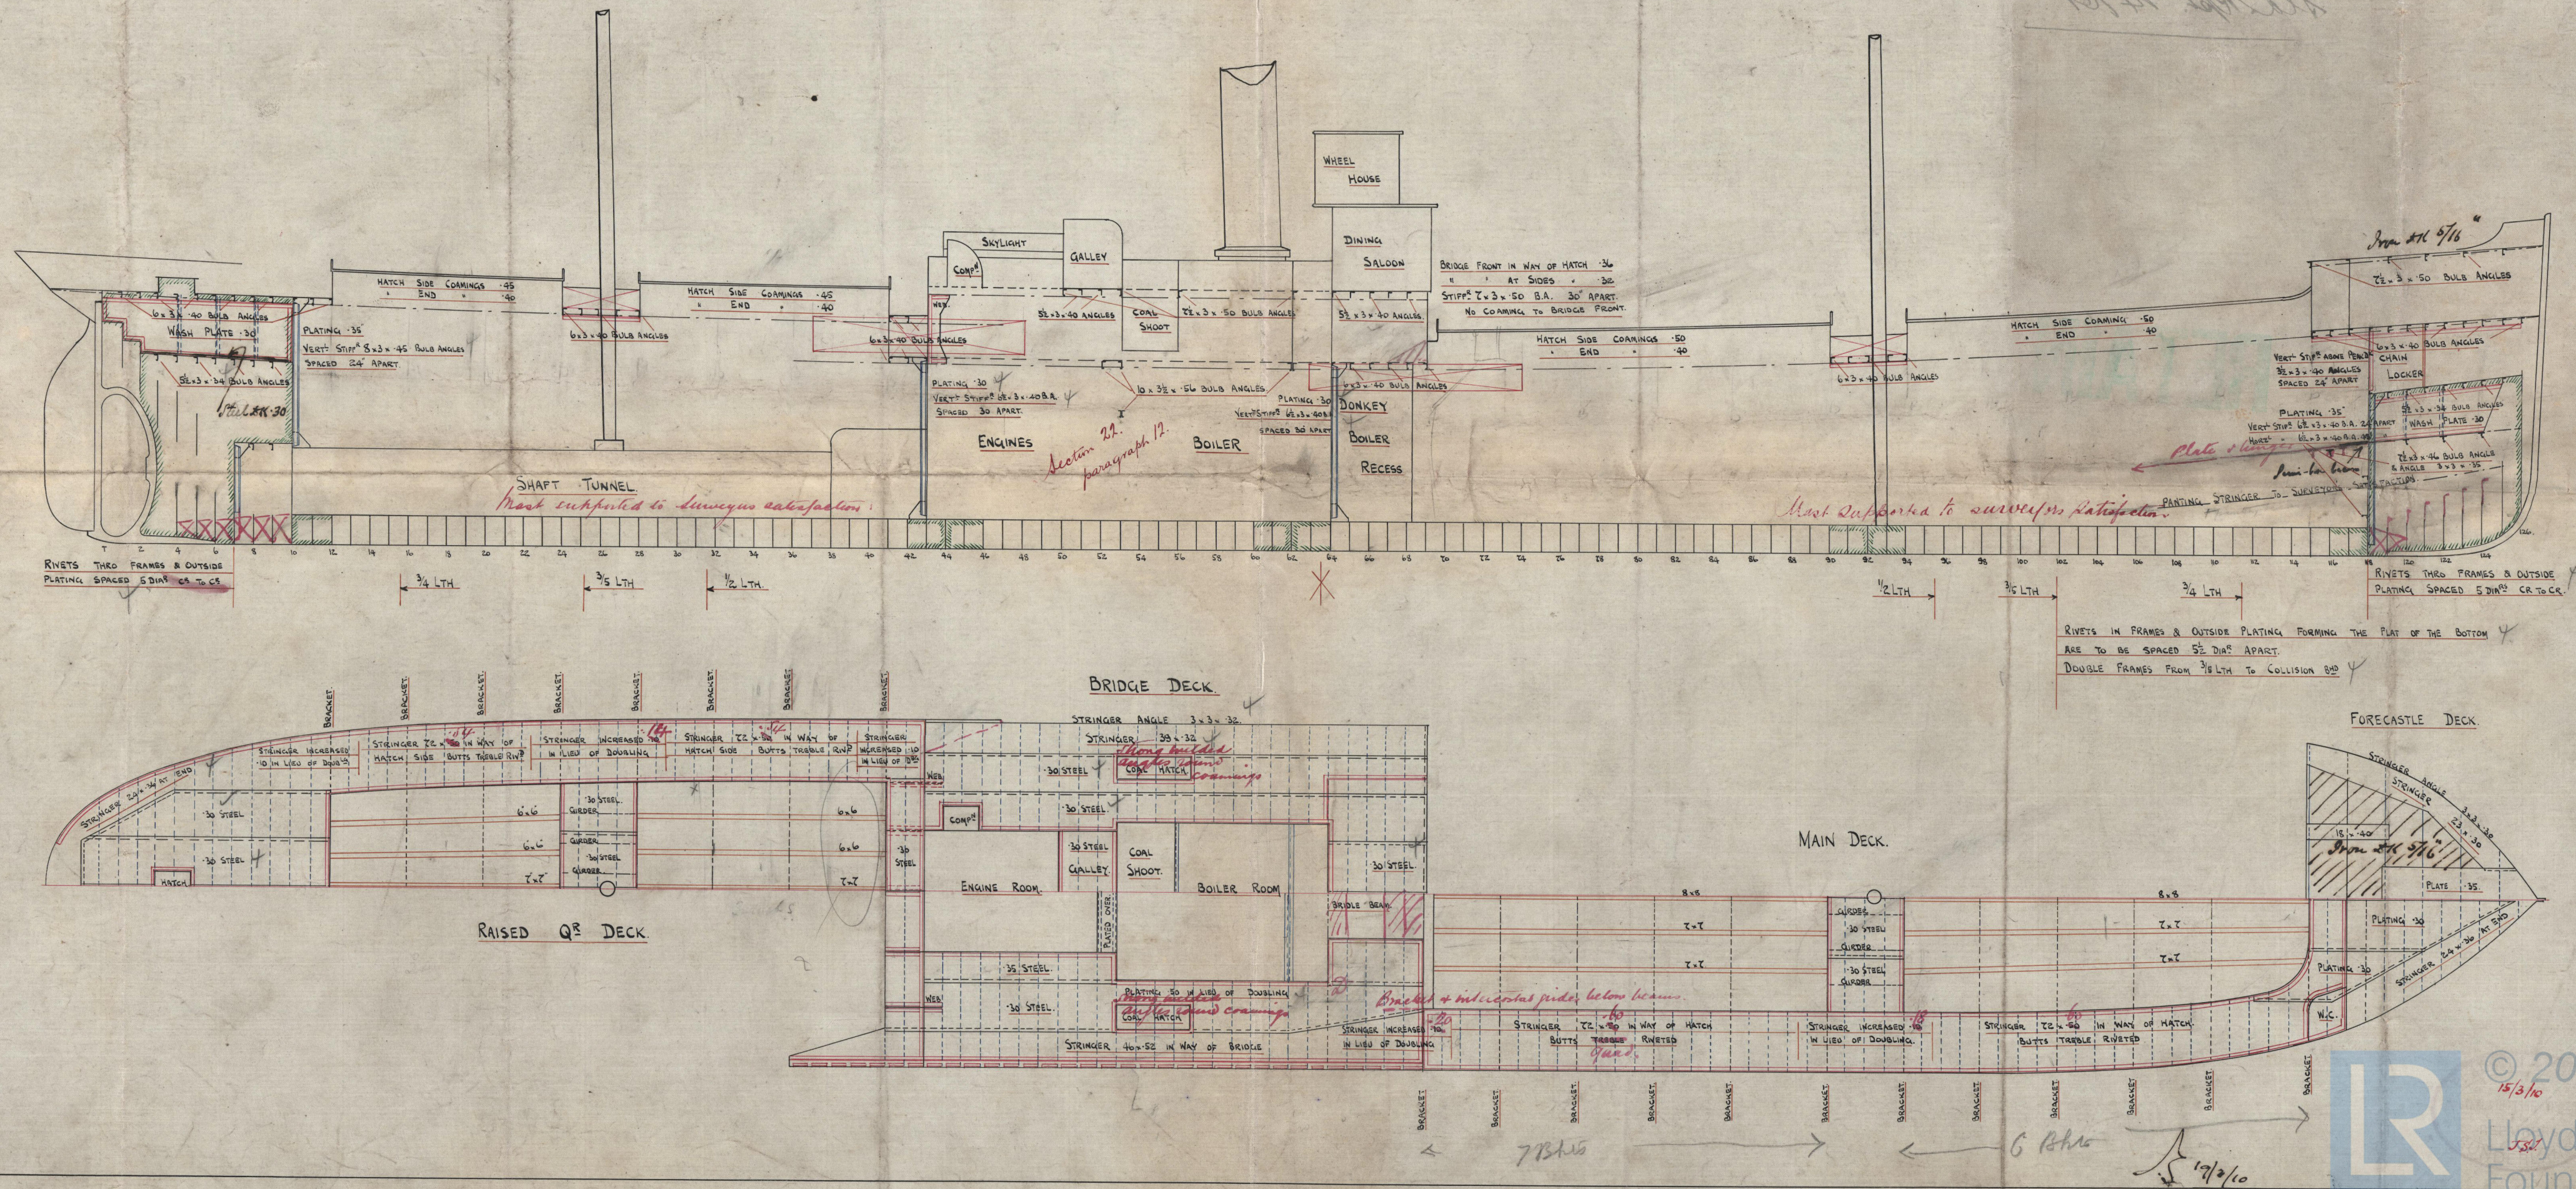

PROFILE

N 256

Hockwold.

Slid. Rpt. 24761

DECK PLANS