

BOILER No 1350 duplicate of No 1282

WORKING PRESSURE 160 LBS PER \square
SCALE 1 INCH = 1 FOOT.

TO HAVE LLOYD'S CERTIFICATE

1350
1287
GLASGOW

Ross & Duncan

Boiler N^o 1350

Duplicate of Boiler N^o 1284

W.P. = 160 lbs

For engine N^o 846

S/S N^o 218. by

R. Williamson & Son Wokington

mark on boiler:—

L.H.B.

2-2-11

N^o 11152

LLOYD'S TEST

320 LBS



11-8-1411

H.C.F.

for "McElwain"

GLASGOW REPORT No.

31118.

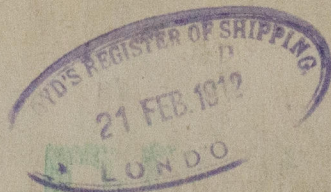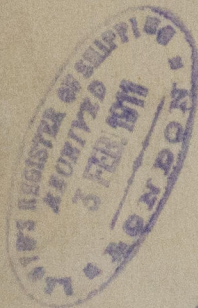

REMAIN

WS68-0073



© 2020

Lloyd's Register
Foundation