

NOS 1-15.

S/S KING GEORGE

Midship Section

STEEL SCREW TRAWLERS.

TO CLASS 100 A.I. LLOYDS.

SCALE $\frac{1}{2}$ " = ONE FOOT.

DIMENSIONS.


HALE MOULDED BREADTH	10.43
DEPTH FROM TOP OF KEEL	12.08
$\frac{1}{2}$ MIDSHIP GIRTH	17.83
LENGTH	103.75

NUMERALS.


$10.43 + 12.08 + 17.83$	$= 40.34$
$10.43 + 12.08 + 17.83 \times 103.75$	$= 4185.27$

PROPORTIONS.

$103.75 \div 12.08$	$= 8.58$
$103.75 \div 20.86$	$= 4.97$

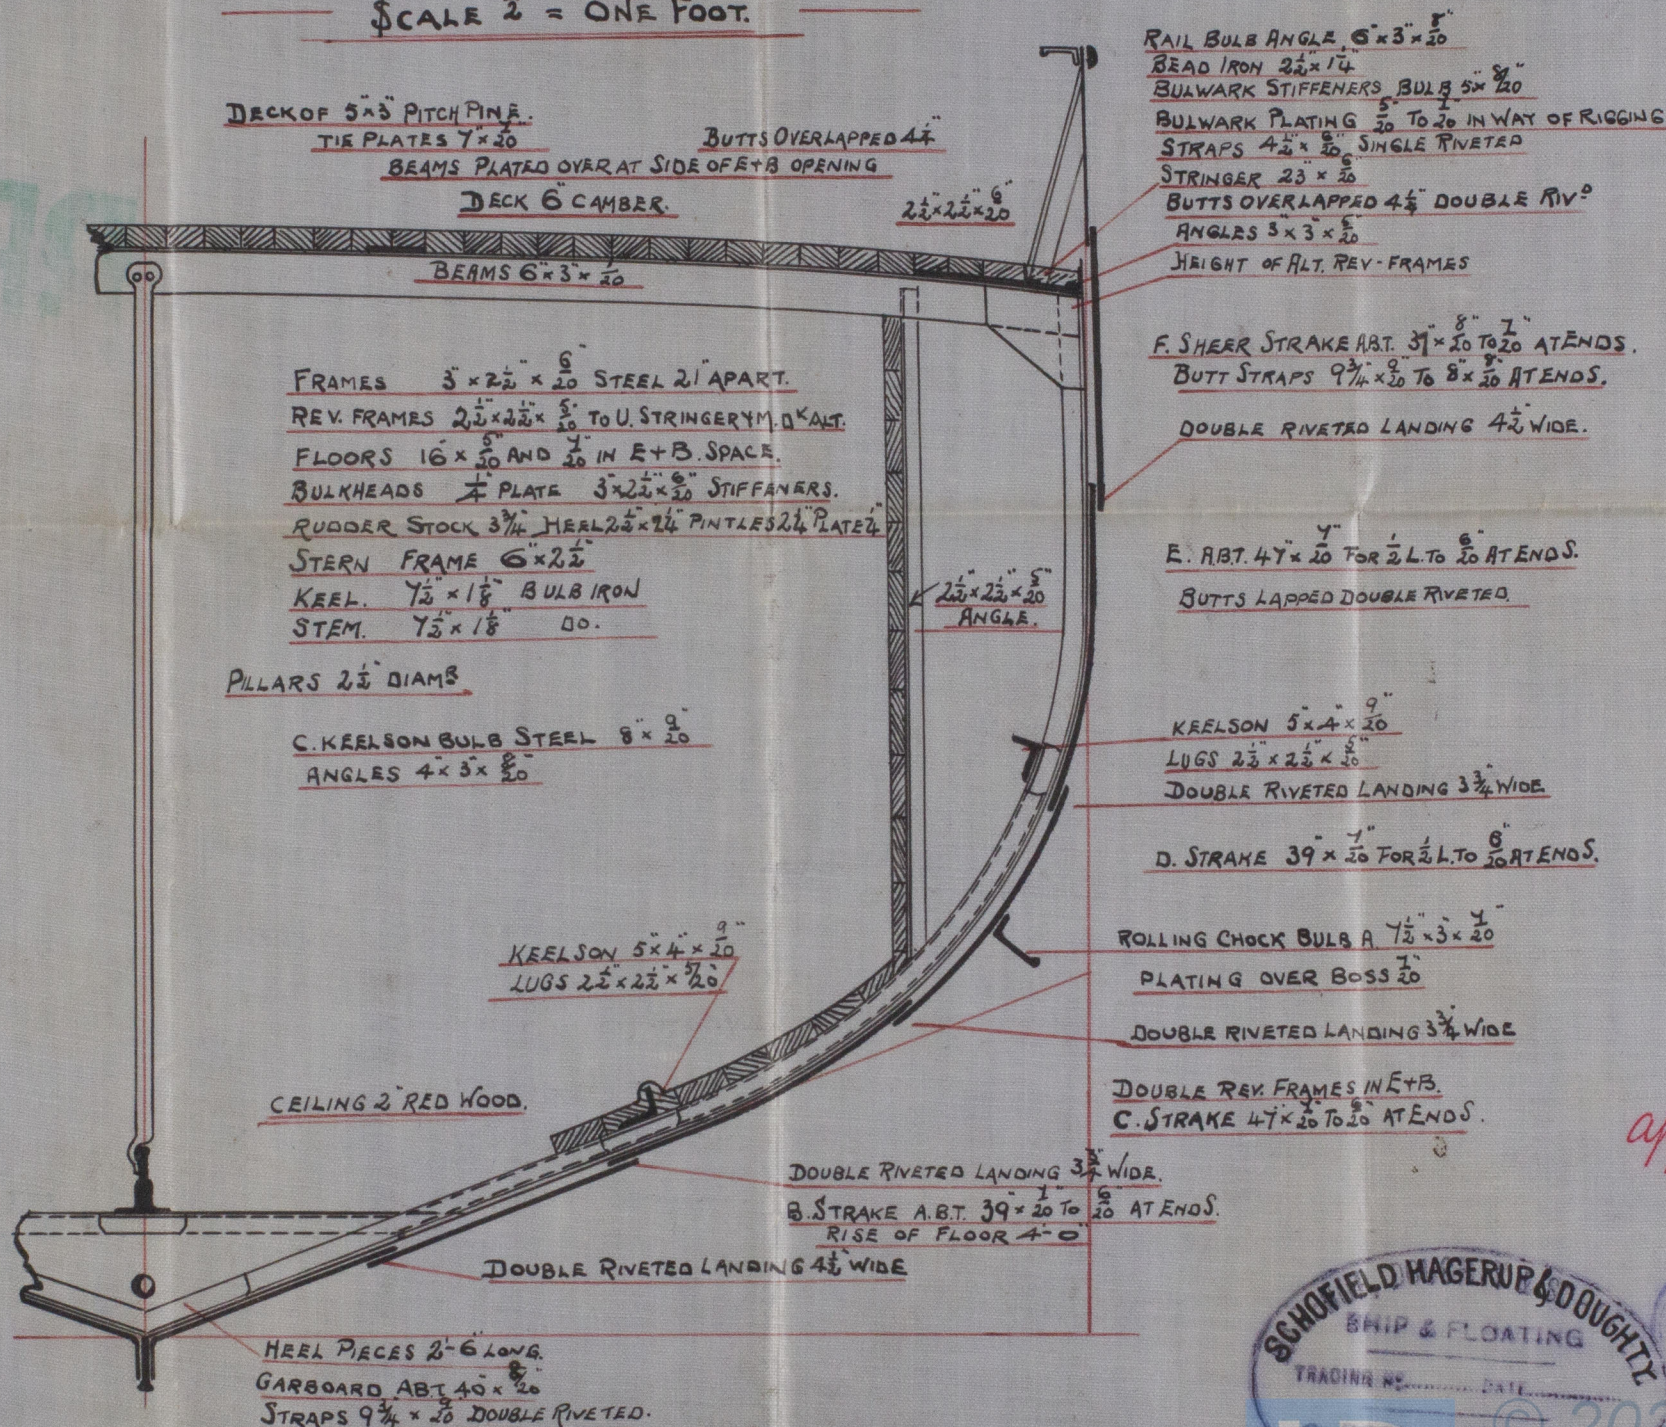

Approved
25/4/98

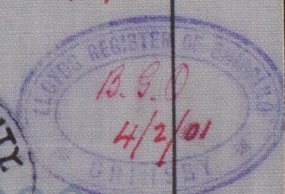

Lloyd's Register
Foundation

W889-0024

Midship Section
s/s "King George"
Schofield, Hagerup & Doughty
s/s "No 15"
Grimby Report No 989
—————

© 2020

Lloyd's Register
Foundation

W869-0024