
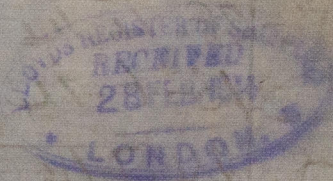
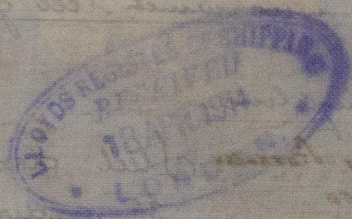
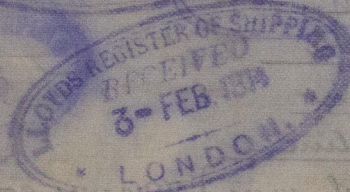


Amended Midship Section
Sunderland S. B. Co.

S.S. No. 284.

S.S. KILLELLAN

No. Report No 26378

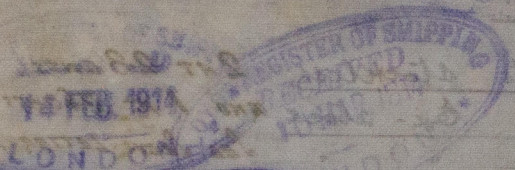

RETAIN



© 2020

Lloyd's Register
Foundation

W869-0081