

N<sup>o</sup> 550 SHIP.



PRINCIPAL DIMENSIONS - 352'0" x 49'6" x 24'3" M<sup>o</sup>

PROFILE AND DECK PLANS.


SCALE 1/8" = 1 FOOT.

SKETCH SHOWING METHOD OF FITTING  
HATCH COAMINGS ON UPPER DECK  
IN BRIDGE.

SKETCH SHOWING METHOD OF FITTING  
HATCH COAMINGS ON BRIDGE & PROP  
DECKS AND IN WELLS.

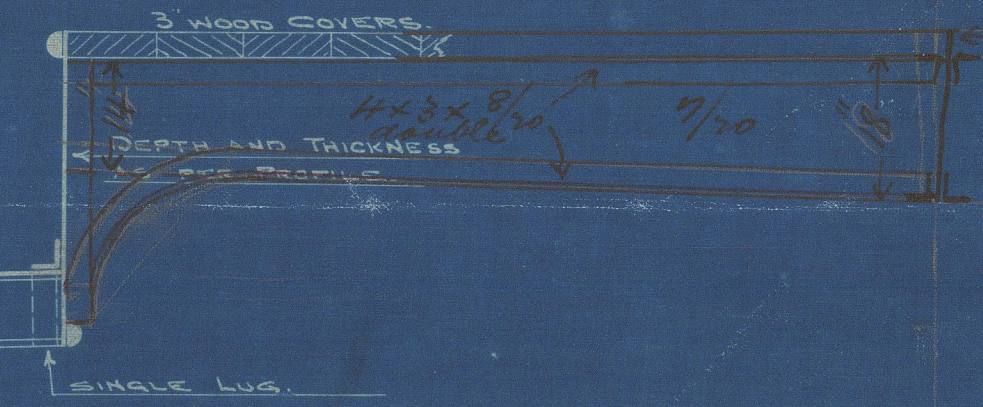
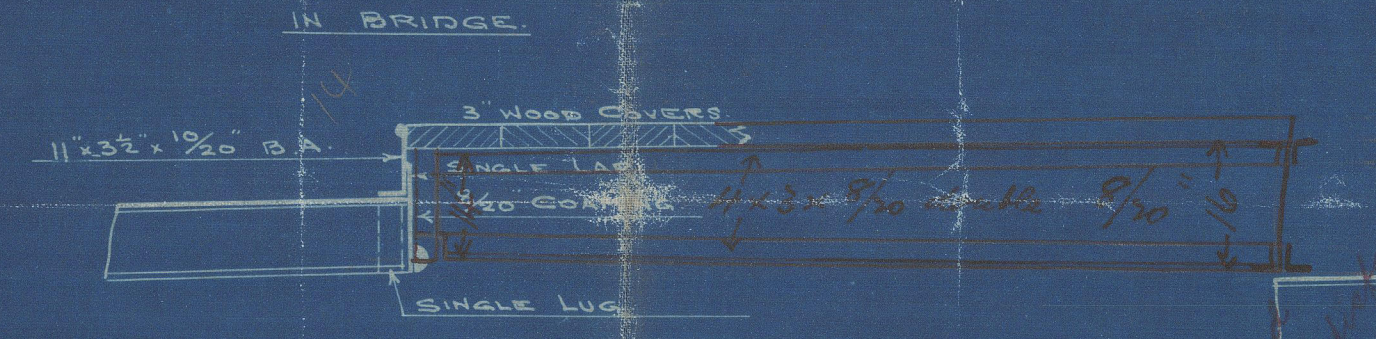


6'5" CR  
4'5" CR  
12'5" CR


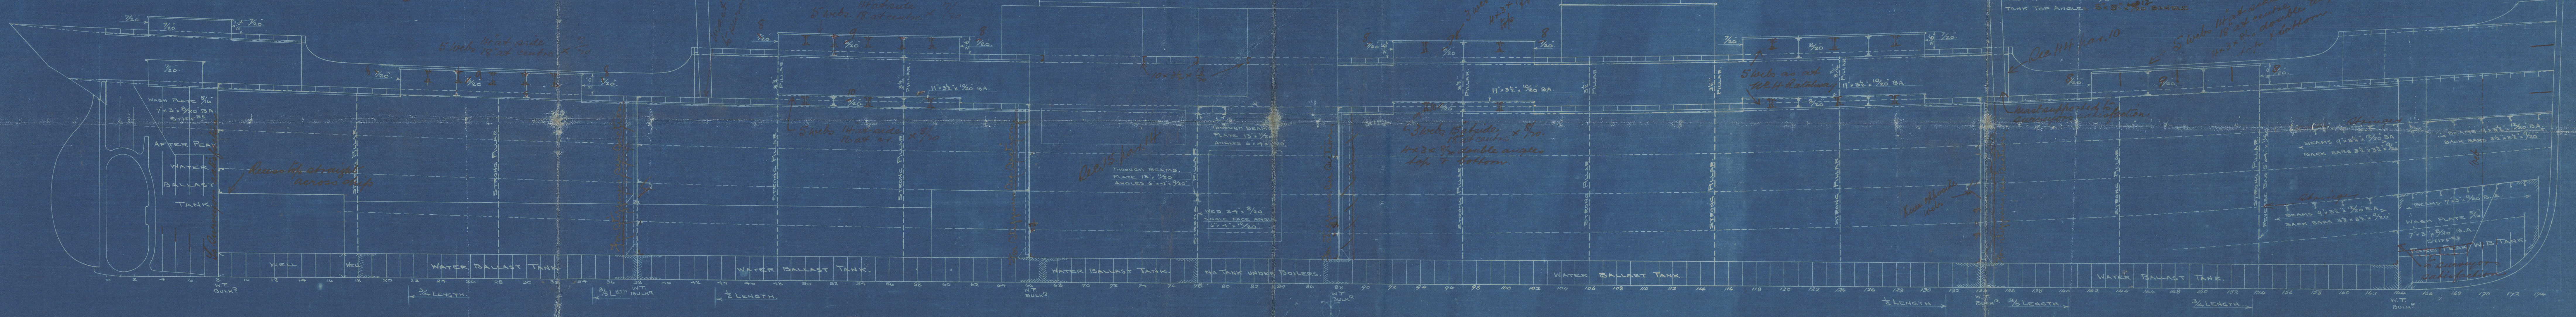


BULKHEADS.  
PLATING 1/2\"/>

5' with 11\"/>

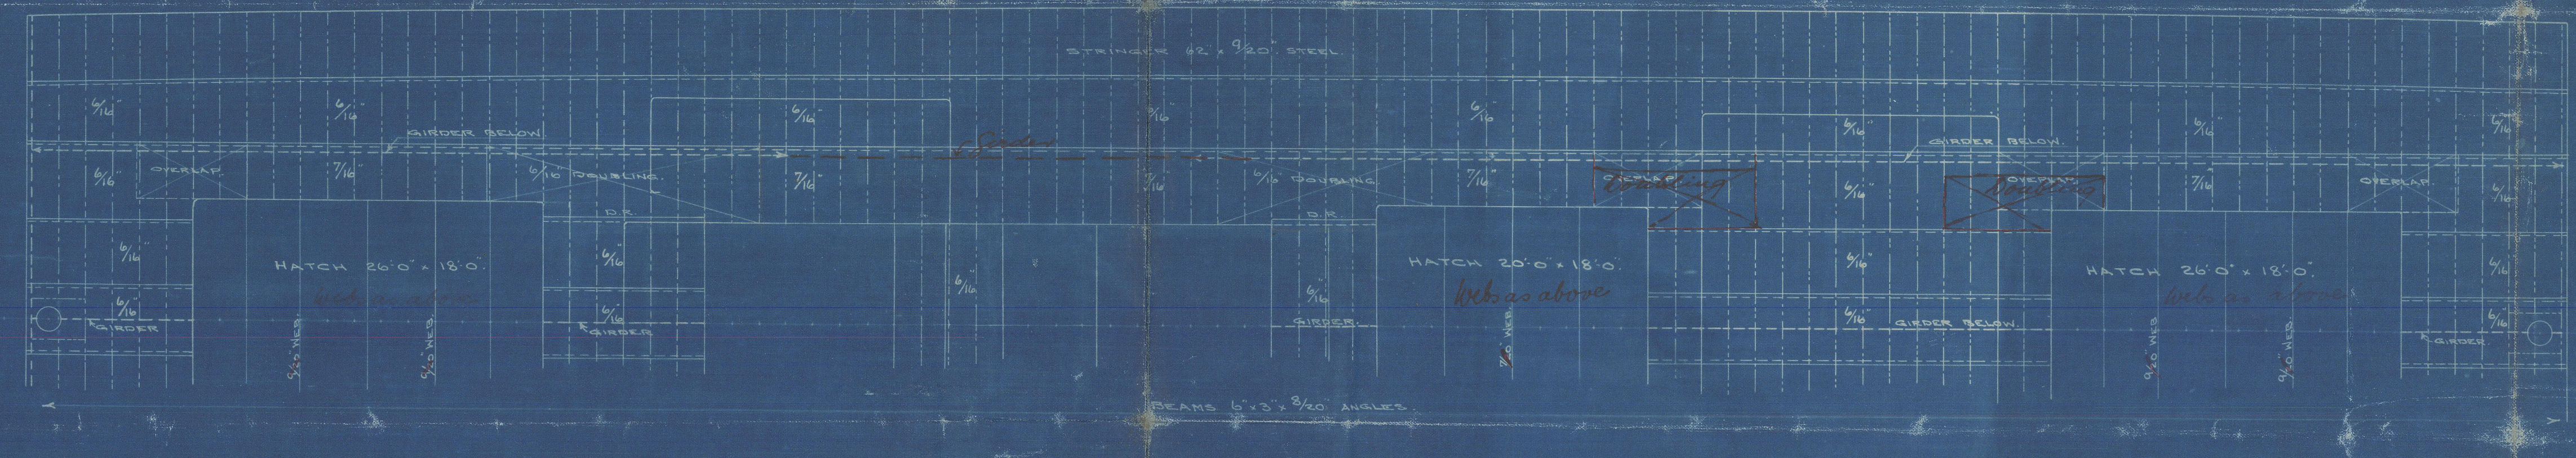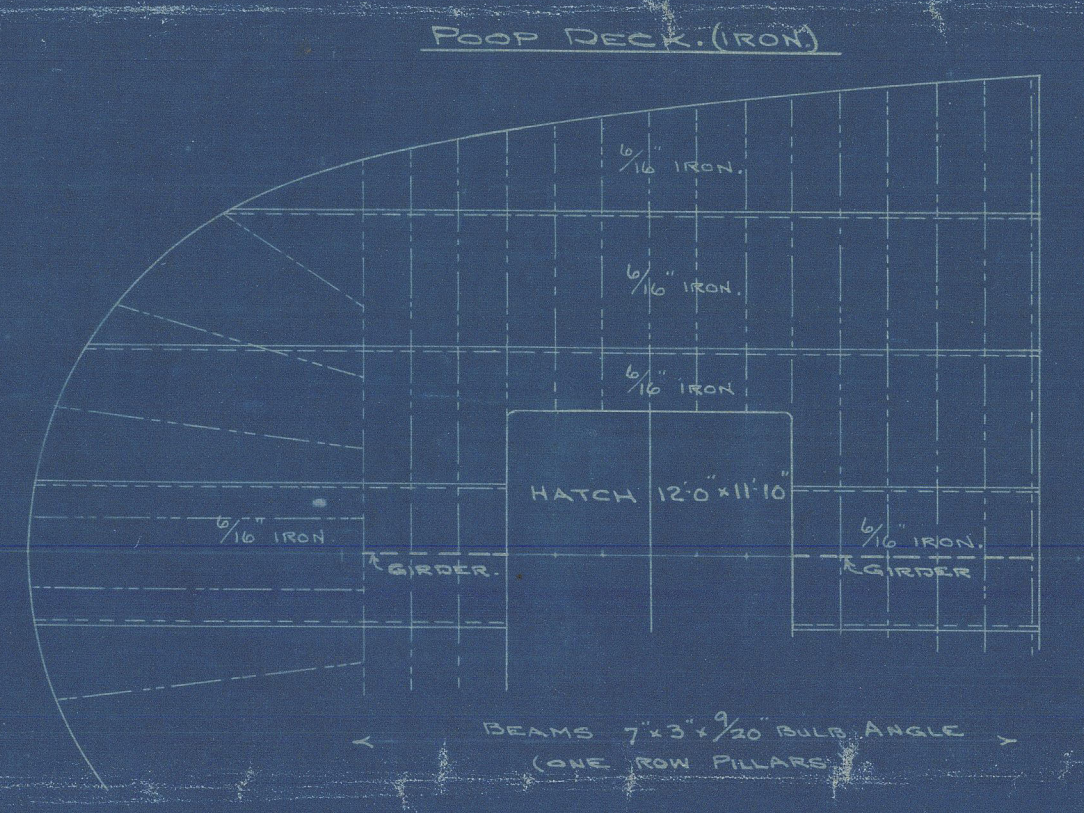

INTERMEDIATE BEAMS IN MATCHWAYS  
ON UPPER AND BRIDGE DECKS.  
3\"/>

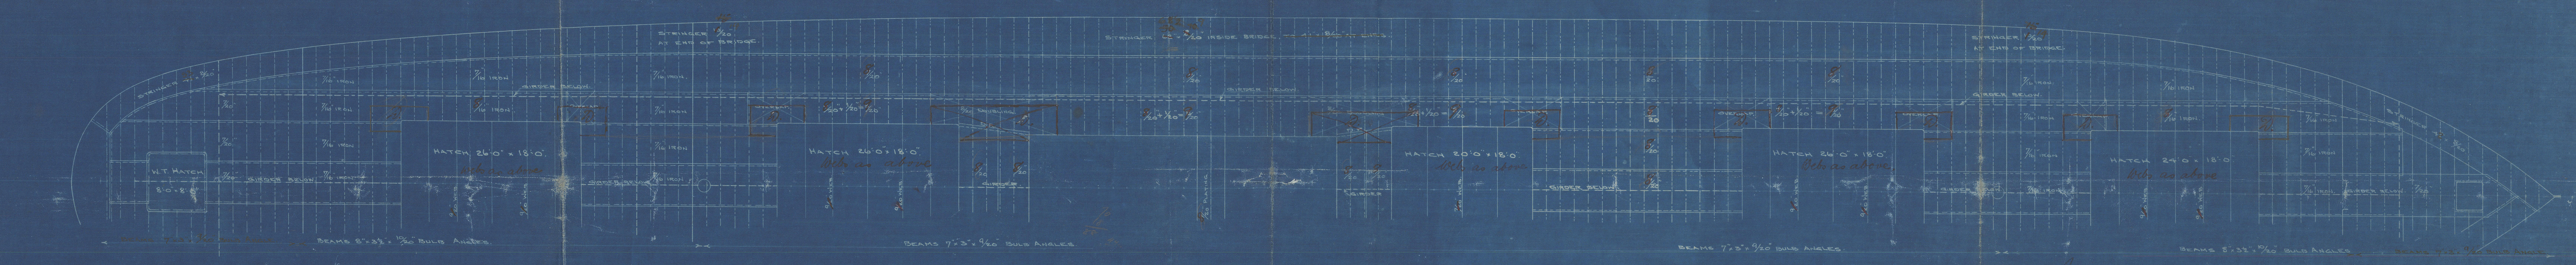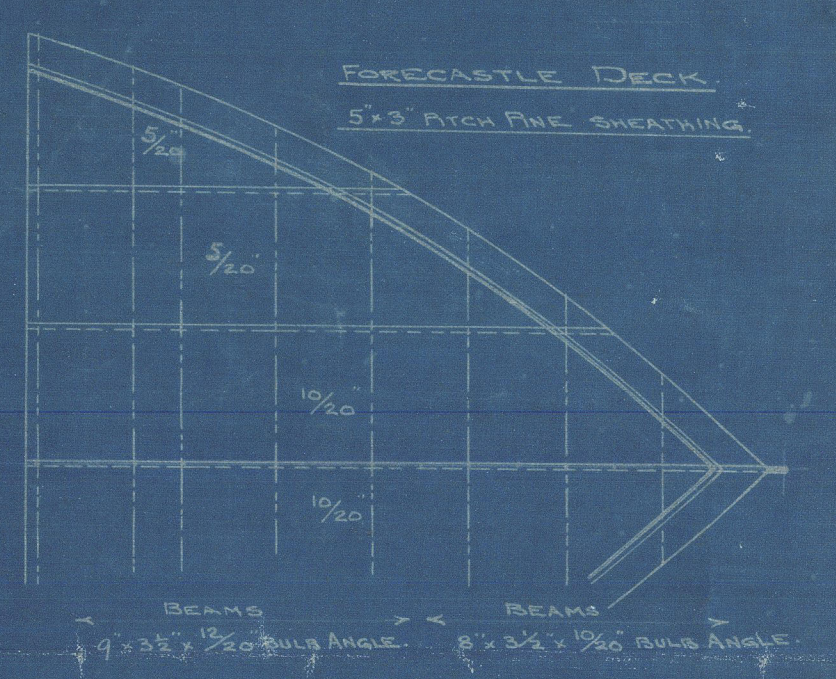



RETAIN



© 2020

Lloyd's Register  
Foundation






Profile & Deck Plans

Earle's Co. Ltd

No 550

of Hilnsea  
Hull Report No. 20,656

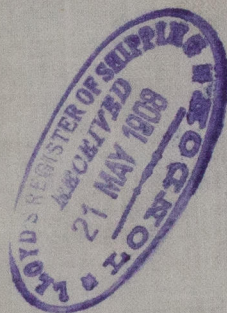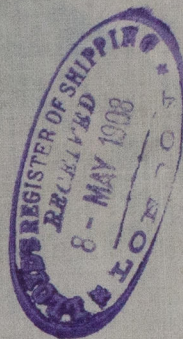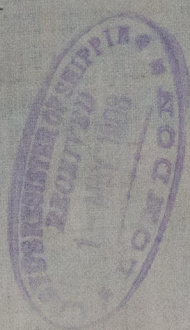

© 2020

Lloyd's Register  
Foundation

W869-0105