




SECTIONAL ELEVATION

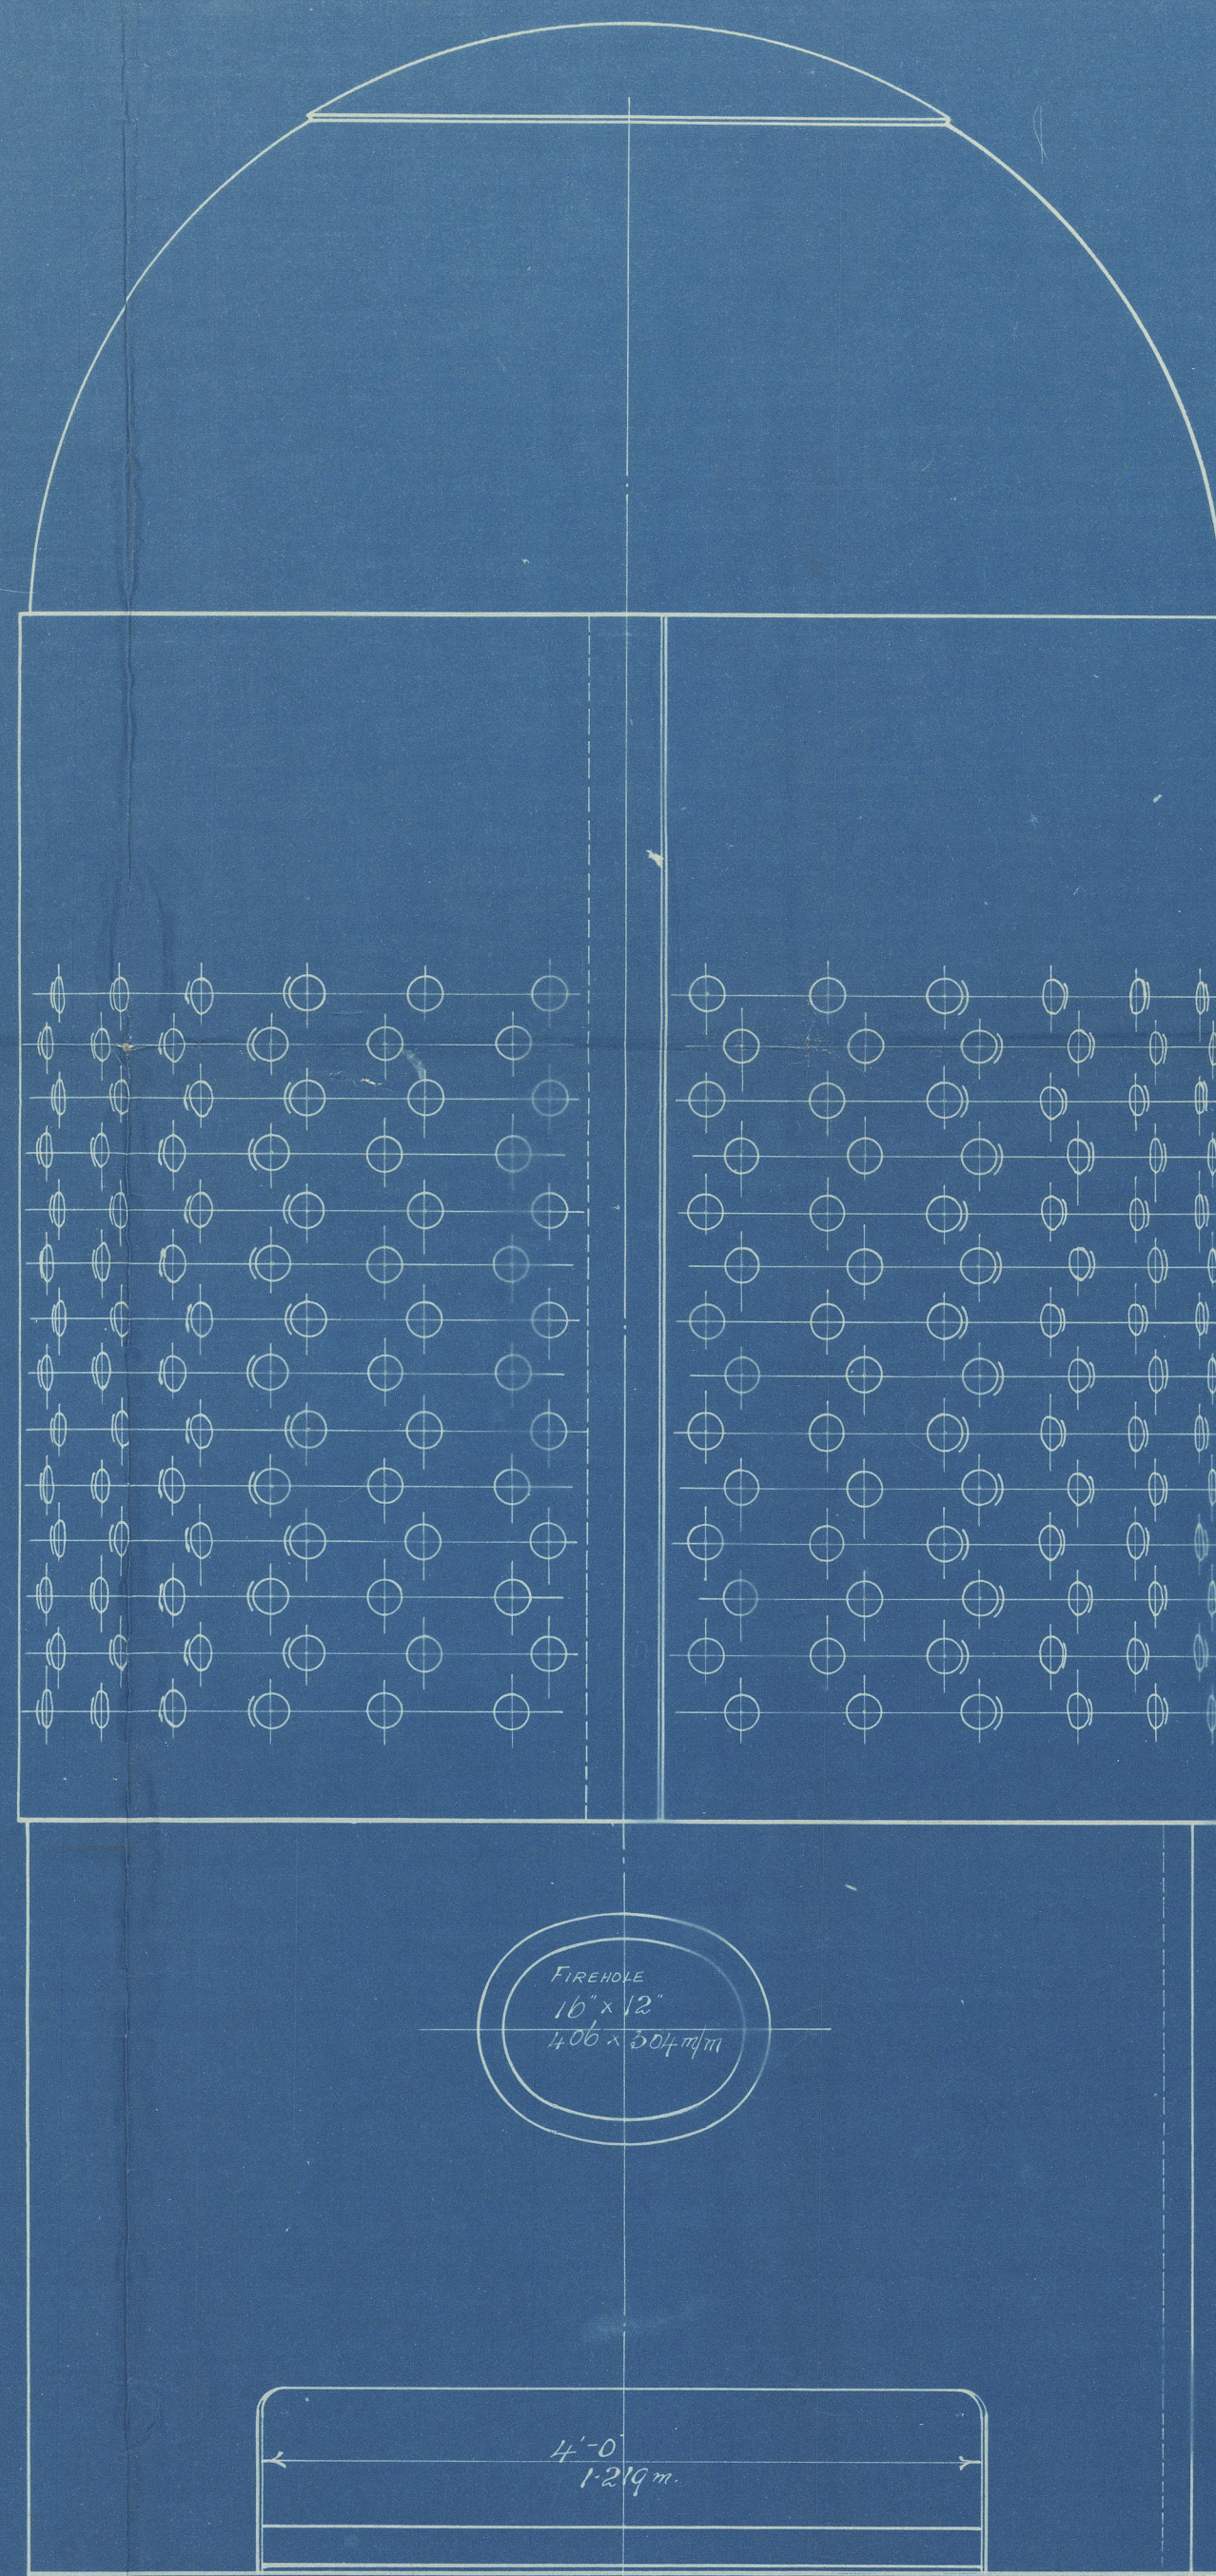


FRONT ELEVATION

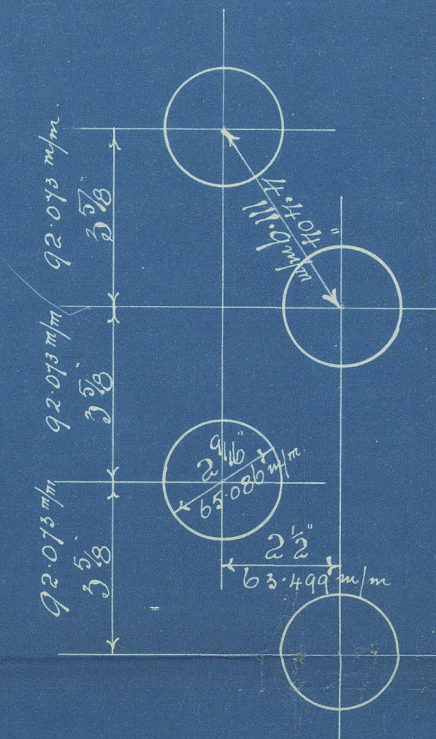


ARRANGEMENT OF TUBES ON SHELL

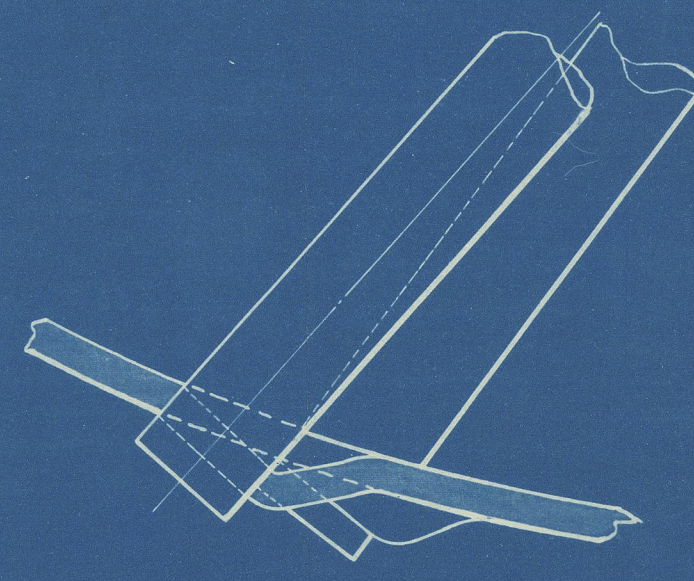

EXTREME WING VIEW

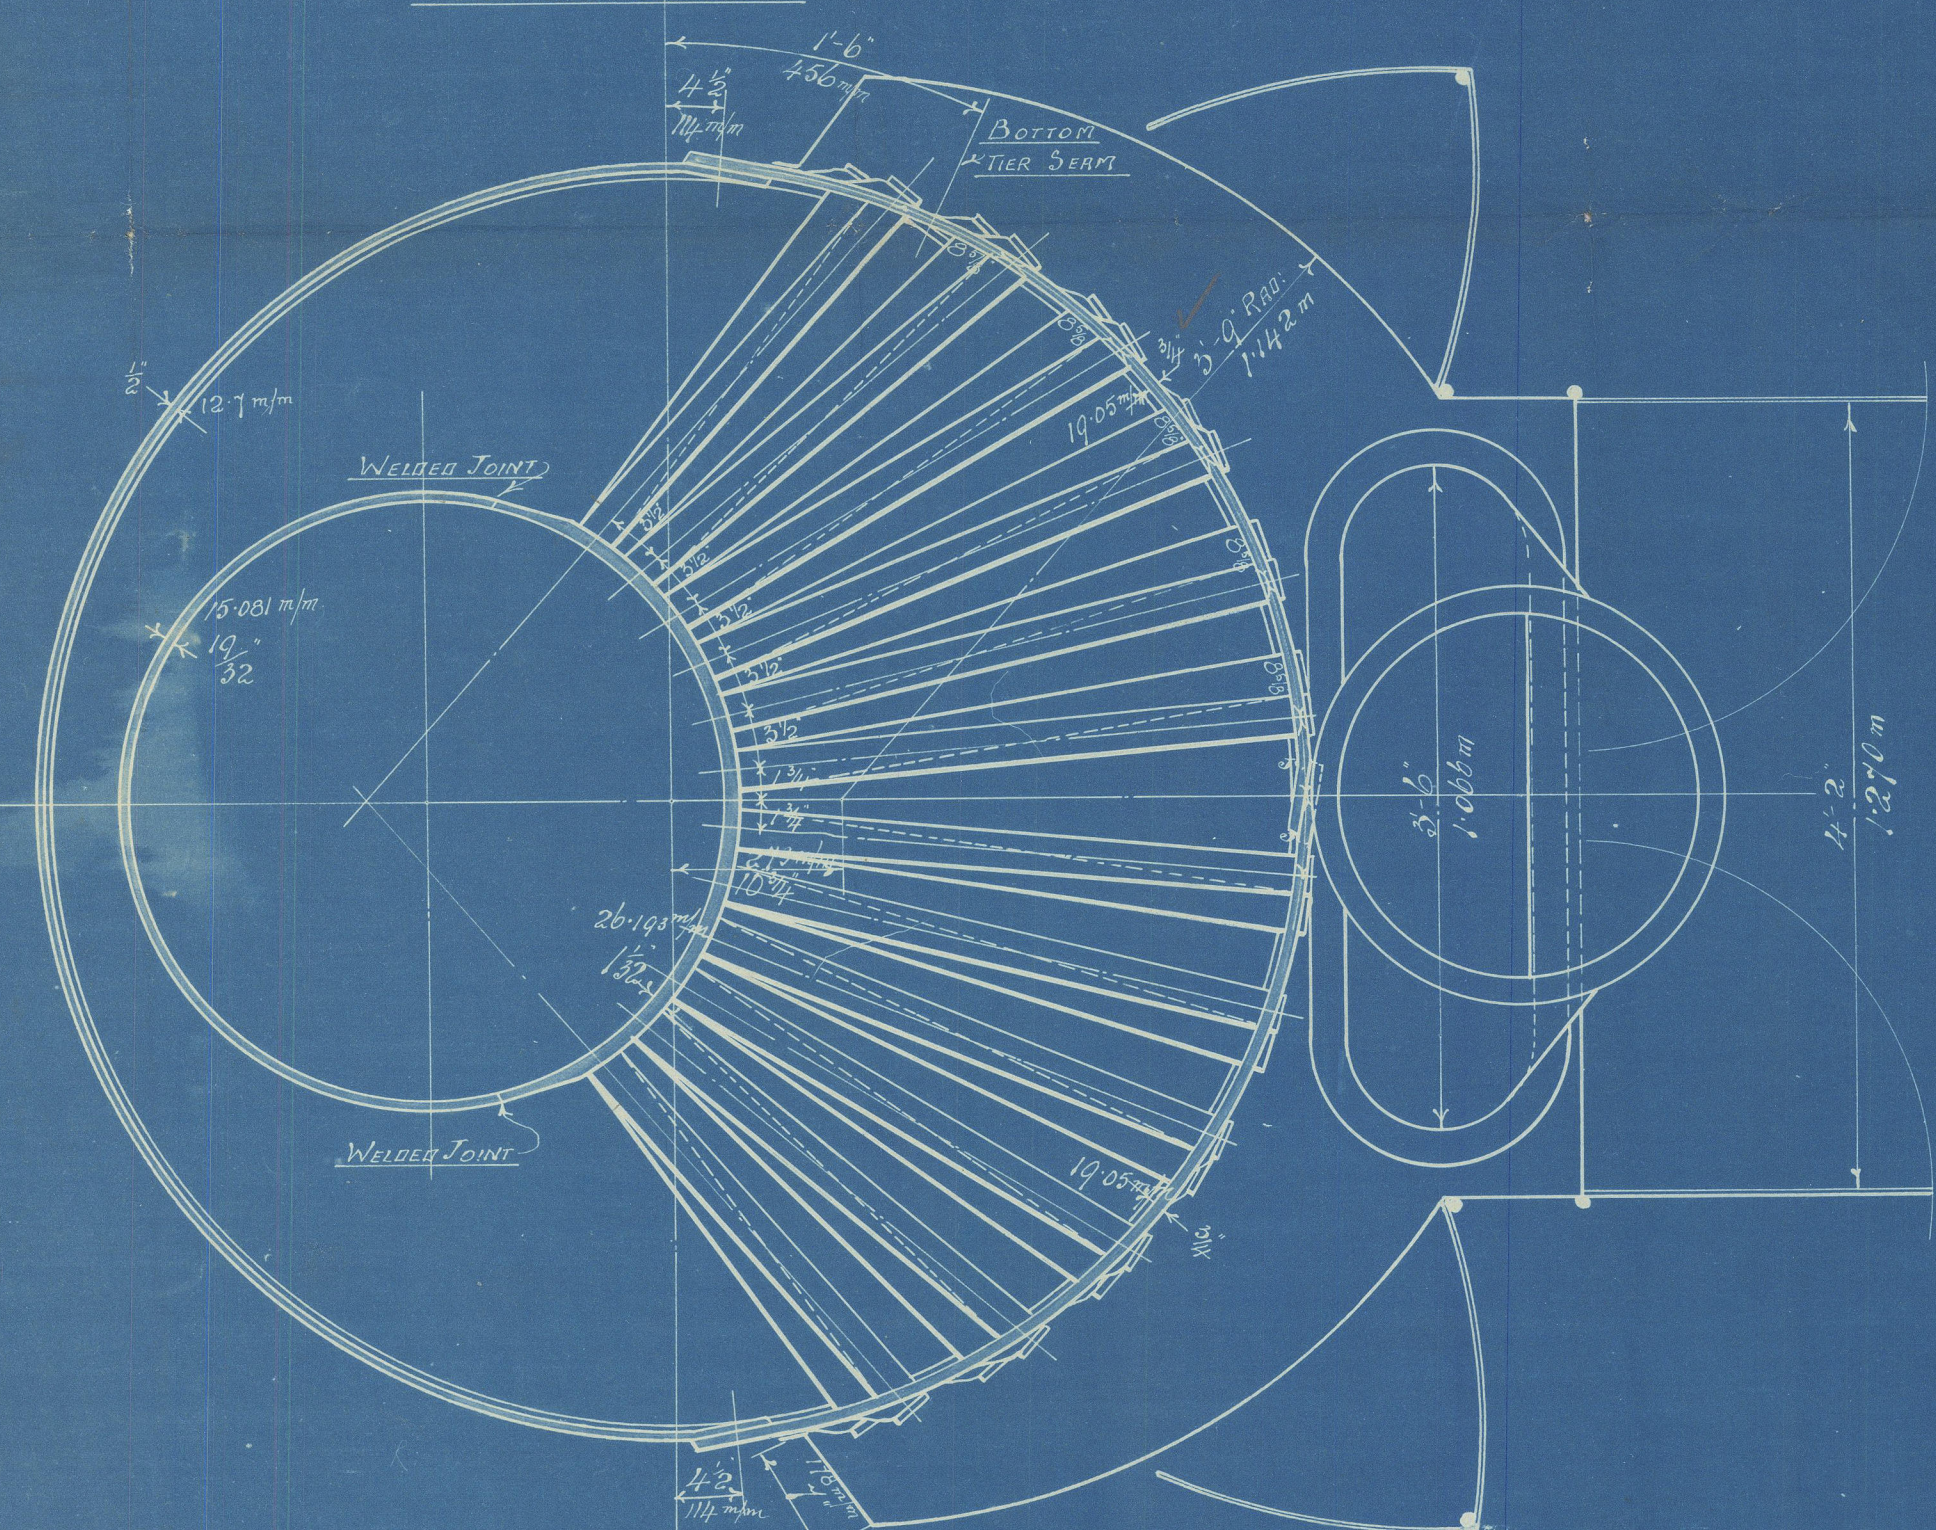

PLAN

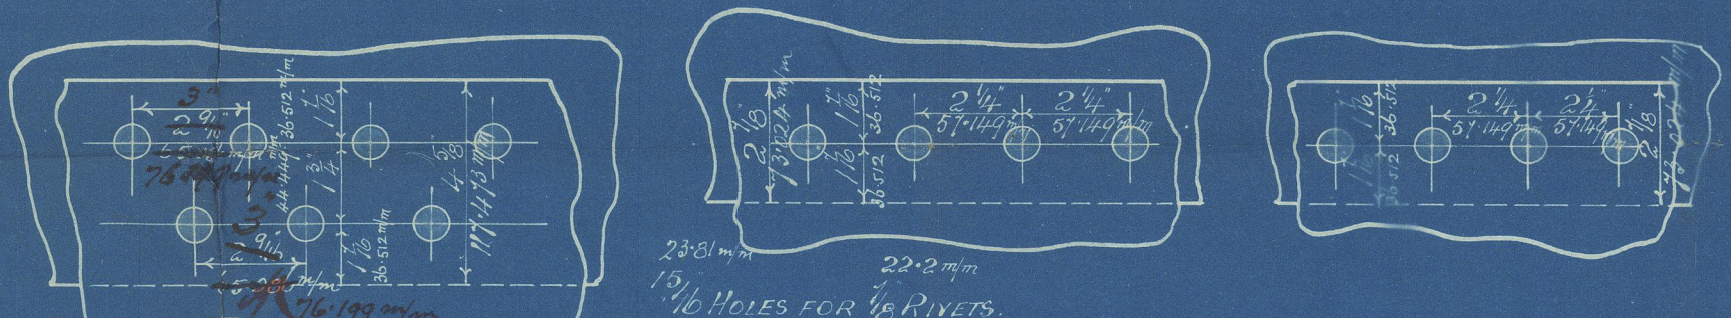




Percentage of strength of shell plating to be not less than 66.8% or the shell plating to be not less than 33.3% of the strength of the shell.

LONGITUDINAL SEAMS	CROWN AND CIRCUMFERENTIAL SEAMS	INTERNAL SEAMS


BLAKE PATENT BOILER - 14'-0" HIGH x 6'-6" DIA x 100 LBS.

Scale 1" = 1 Foot

BOILER No 3119.

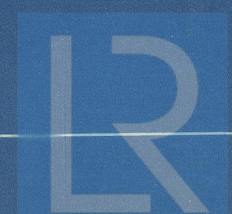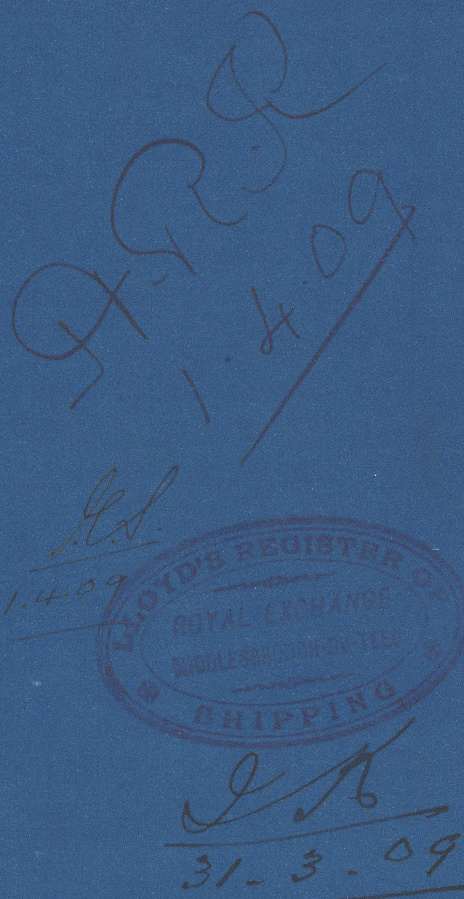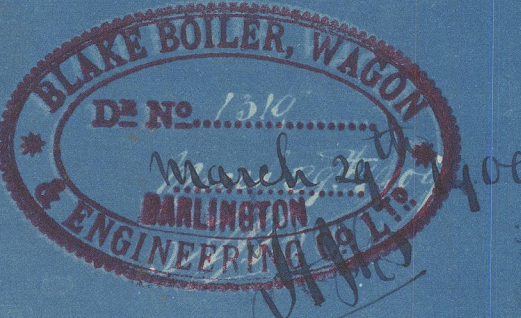

W869-022



Mess<sup>rs</sup> Lloyd's Surveyors

SOLANITE BRAND, REGD  
ALLOTT, JONES & CO., LIVERPOOL, MAKERS.



© 2020

Lloyd's Register  
Foundation



W869-0128



Blake Patent Boilers  
No. 3119

for  
Messrs. Wood Skinner & Co.  
S. S. No. 161

100 lbs W.P.

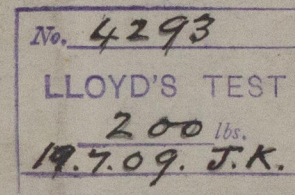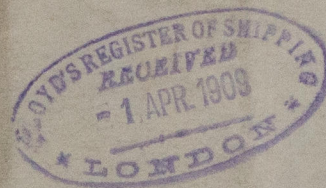

Mat. Rpt. No. 5903  
St. Belgique  
Inv. 57376.

RETAIN

W869-0128



© 2020

Lloyd's Register  
Foundation