

POOP DECK

09

09

Plate 28" x 7/20 Lapped + Double Riveted

6/20 or 7/10

CARGO HATCH

8'-0" x 6'-0"

3/8" F 7/10

2 4 4 6 10

3/20 Steel or 7/16 Iron Lapped + Single Riveted

1/20

OF STEEL SCREW STEAMER


TO CLASS 100 A.I. AT LLOYDS

SCALE $\frac{1}{8}$ " = ONE FOOT.

PRINCIPAL DIMENSIONS:- 281'-6" x 42'-10" x 21'-9" MLD.




BRIDGE DECK

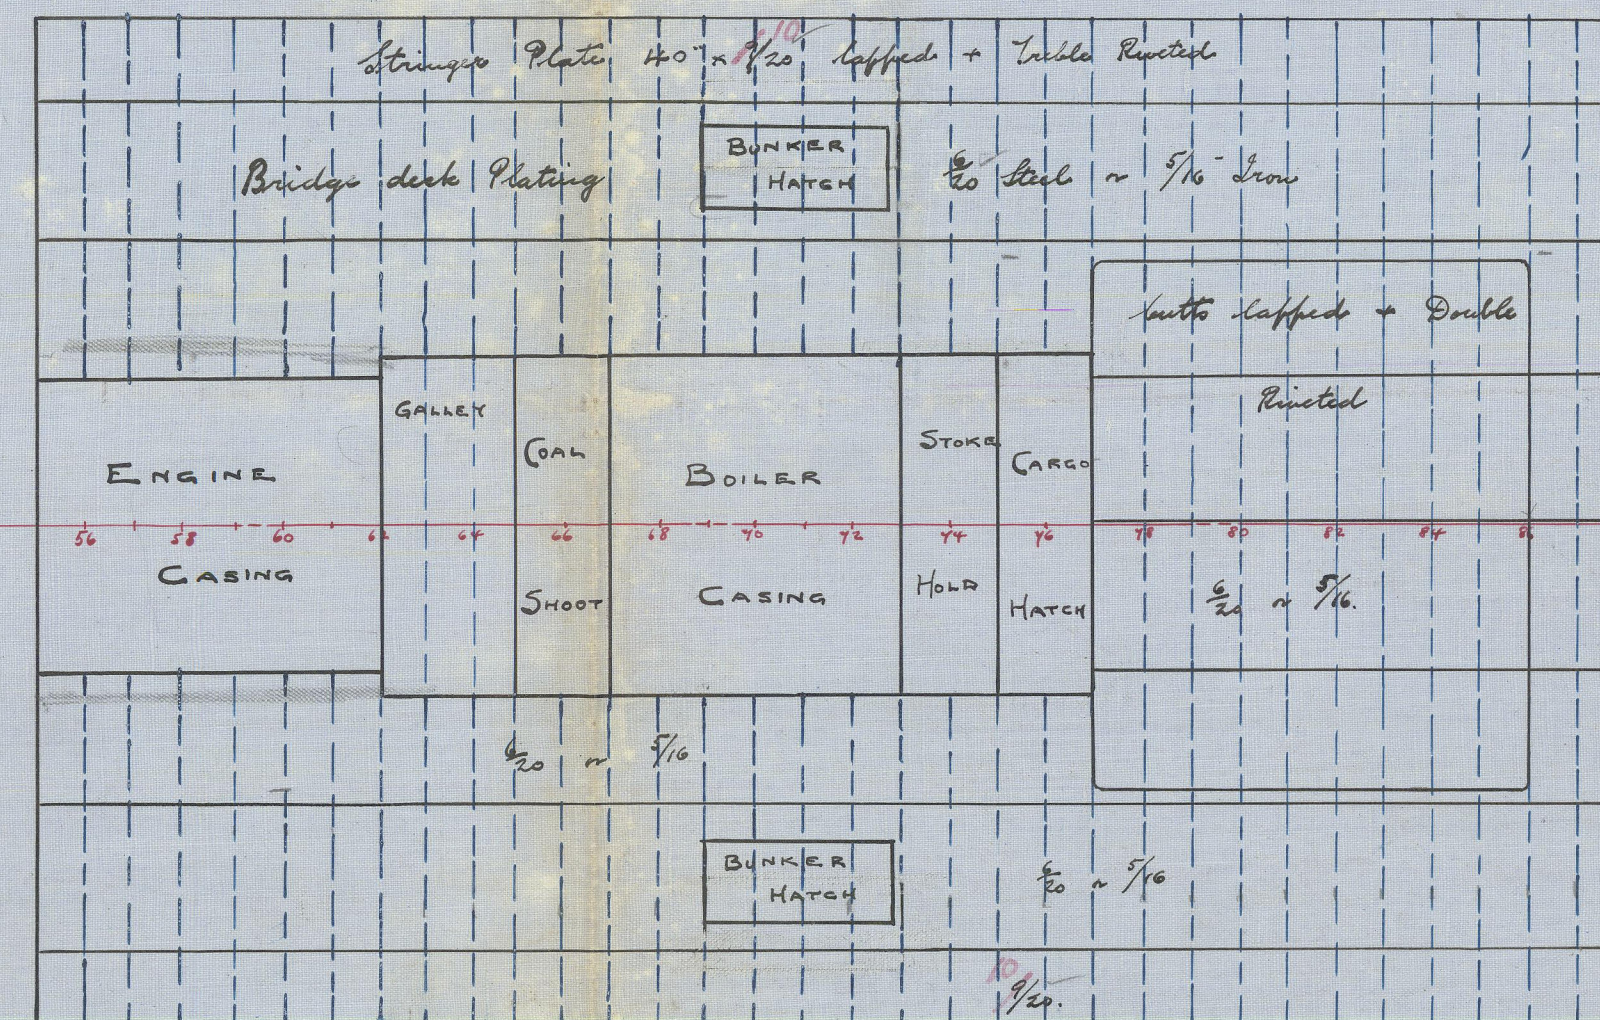


WOOD SKINNER & CO LTD
- SHIPBUILDERS -
NEWCASTLE-ON-TYNE

FORECASTLE DECK

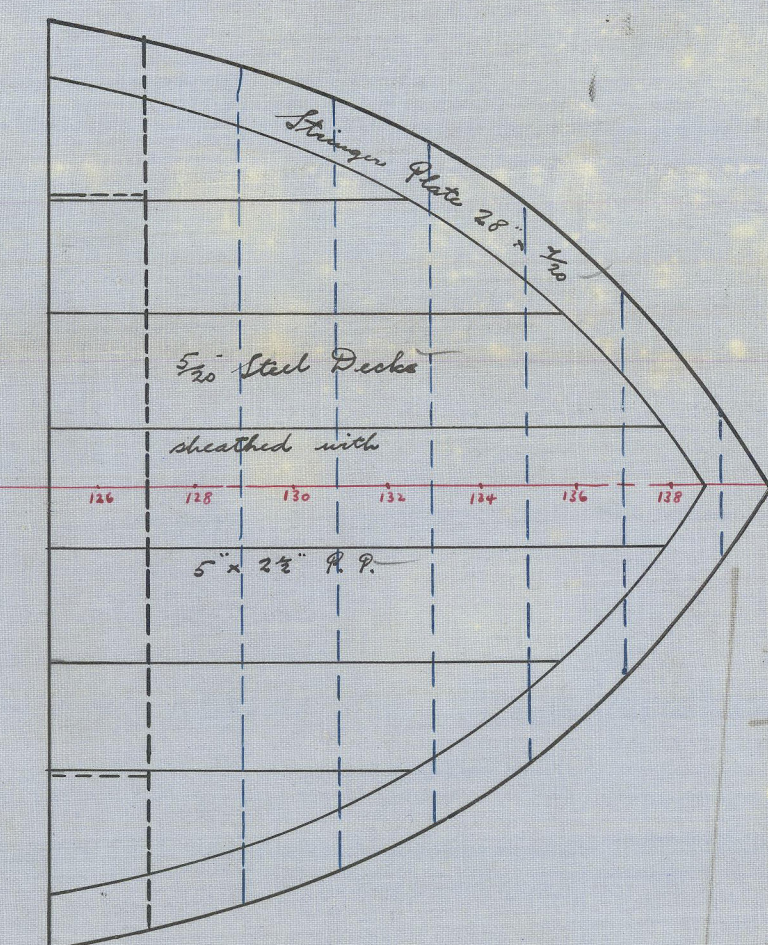


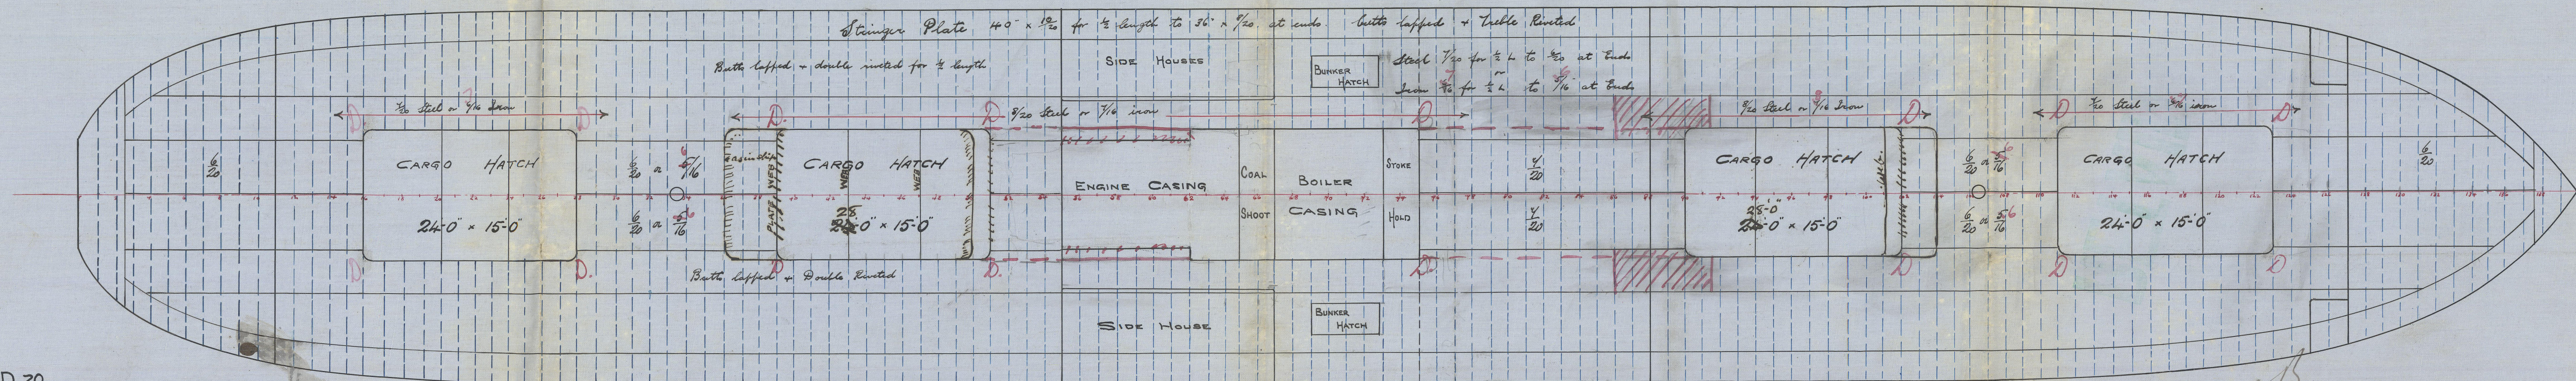

ENQUIRY N° D. 70.

0810-12801


ENQUIRY N° D 70



Deck plans of wood skimmers
S.S. N° 161
"BELGIQUE"


Report No 57376

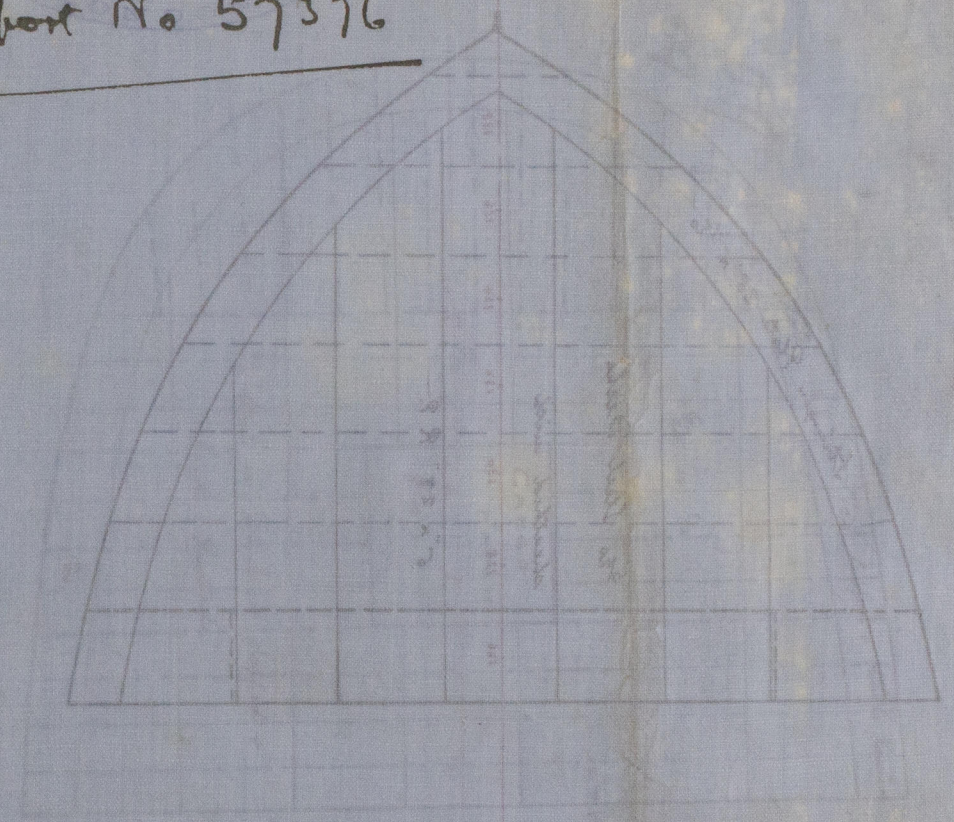

FORECASTLE DECK



LAKE
ENH
COT



© 2020
Lloyd's Register
Foundation

W869-0130