

MIDSHIP SECTION.

ISHERWOOD SYSTEM PATENT.

SCALE 1/2" = 1 FOOT

CLASS 100. A. 1. LLOYDS.


12.2.15
25.2.15
4.3.15
16.3.15
1.6.15

PRINCIPAL DIMENSIONS
LENGTH B.P. 410.0
BREADTH EXTREME 52.6
DEPTH MOULDED 28.4 1/2

NUMERALS
BREADTH 52.20
DEPTH 28.37
TRANSVERSE NO 81.15
LENGTH 409.75
LONGITUDINAL NO 33251
1/4 TO SHELTER DECK 11.08
EQUIPMENT NO 36035.


EQUIPMENT

2. BOWERS 6 3/4 CHTD STOCK
1. " 5 1/2 CHTD " "
1. STREAM 1 1/2 CHTD EX. STOCK
1. KEDGE 1 1/2 CHTD " "
270 FATHOMS 2 1/4 STD CHAIN CABLE
30 " 4 1/2 MOORING WIRE
120 " 5 STEEL TOWLINE
2 of 90 " 2 1/2 STEEL HANDER
2 of 90 " 1 MANILLA WARE

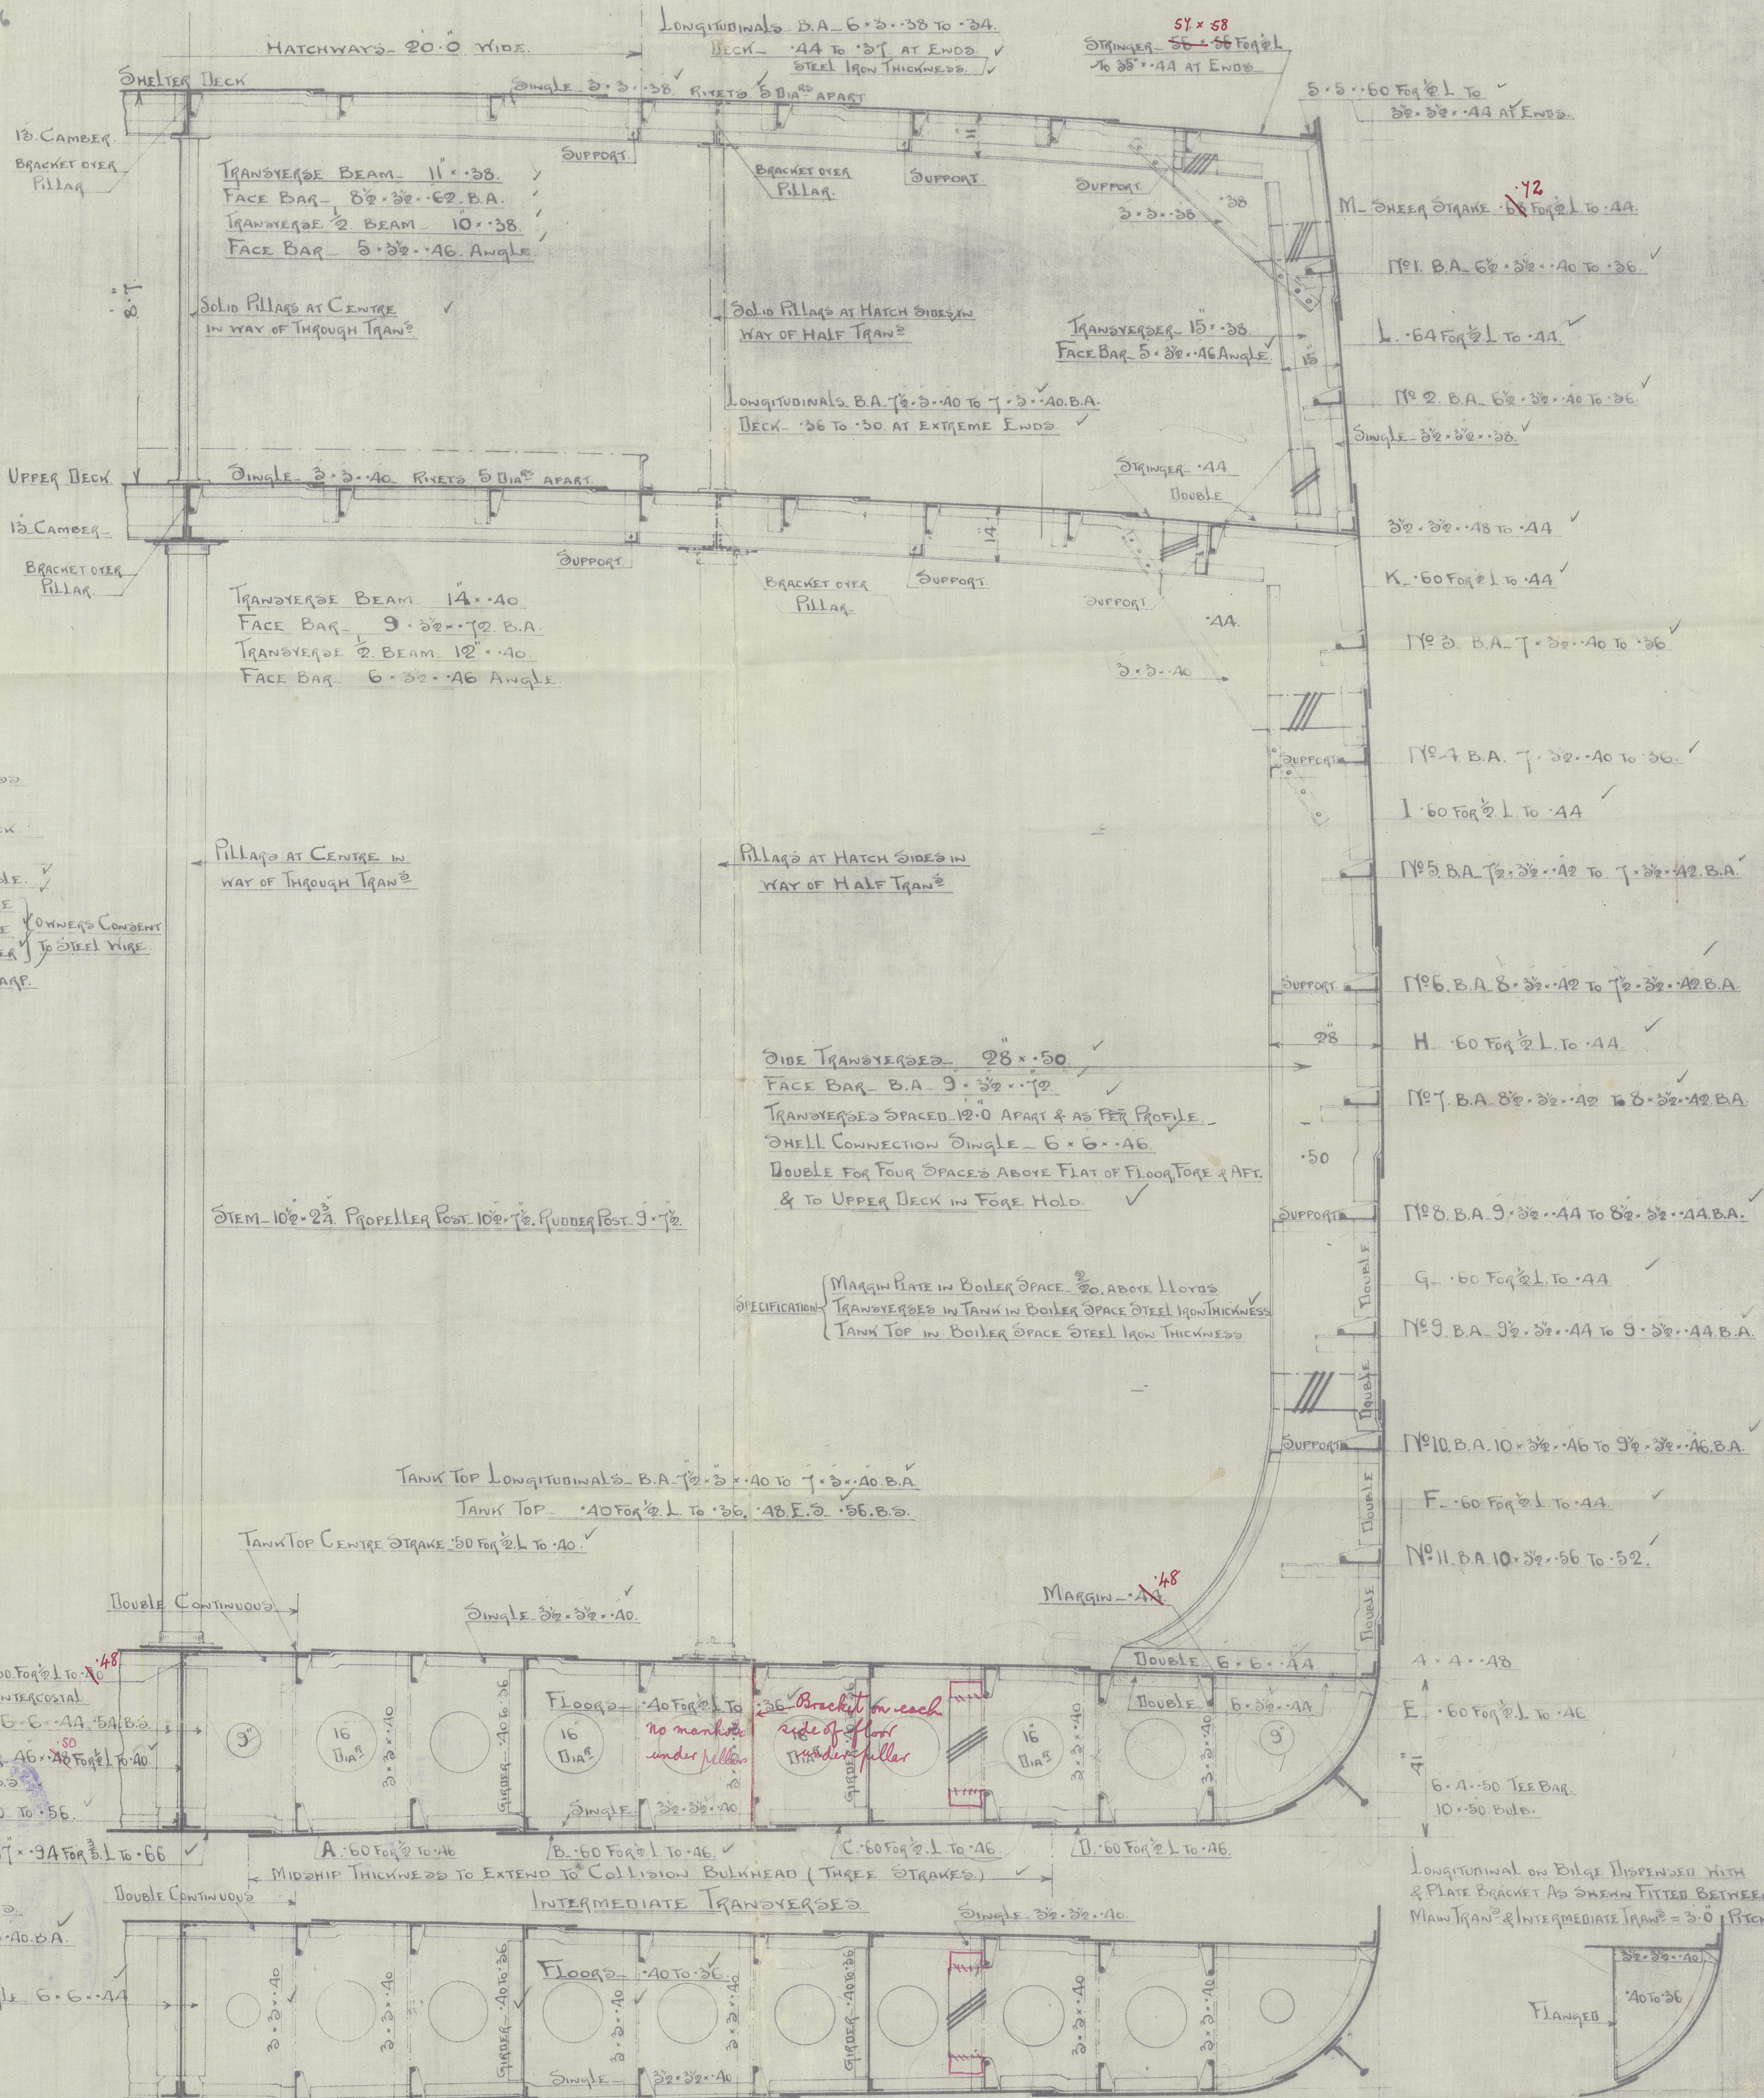

RICHARDSON, DUCK & CO LTD
SHIPBUILDERS
STOCKTON-ON-TEES


TRACING NO 4251
JAN 27 1915.

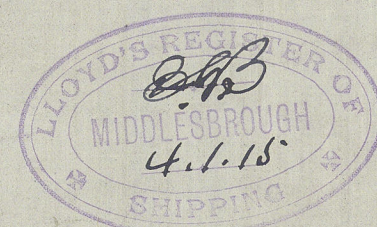

© 2021
Lloyd's Register
Foundation
W812-0001







Miss Richardson Buck Hall
W 650

Mid. Sec.

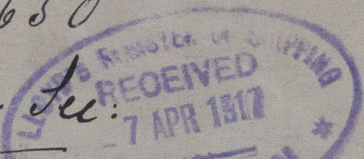

Sp Skeda

Indb report W. 9686

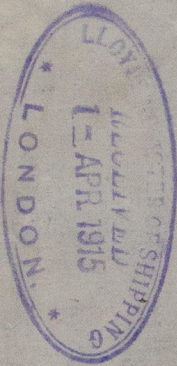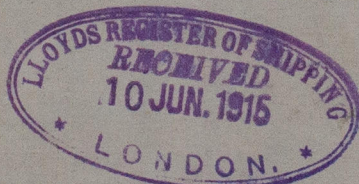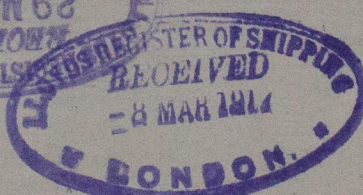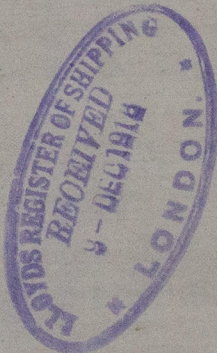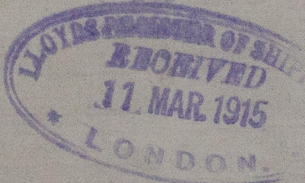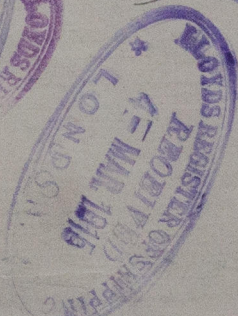

RETAIN



© 2021

Lloyd's Register
Foundation

W872-0007