



25.7.02  
9.2.03  
24.2.03  
20.4.03

No 150  
Steel Screw Steamer  
279'-10" x 40'-0" x 22'-0" moulded  
Scale 1/8" = 1'-0"

*Norm & Meys*  
*Rotterdam 18 July 1902*



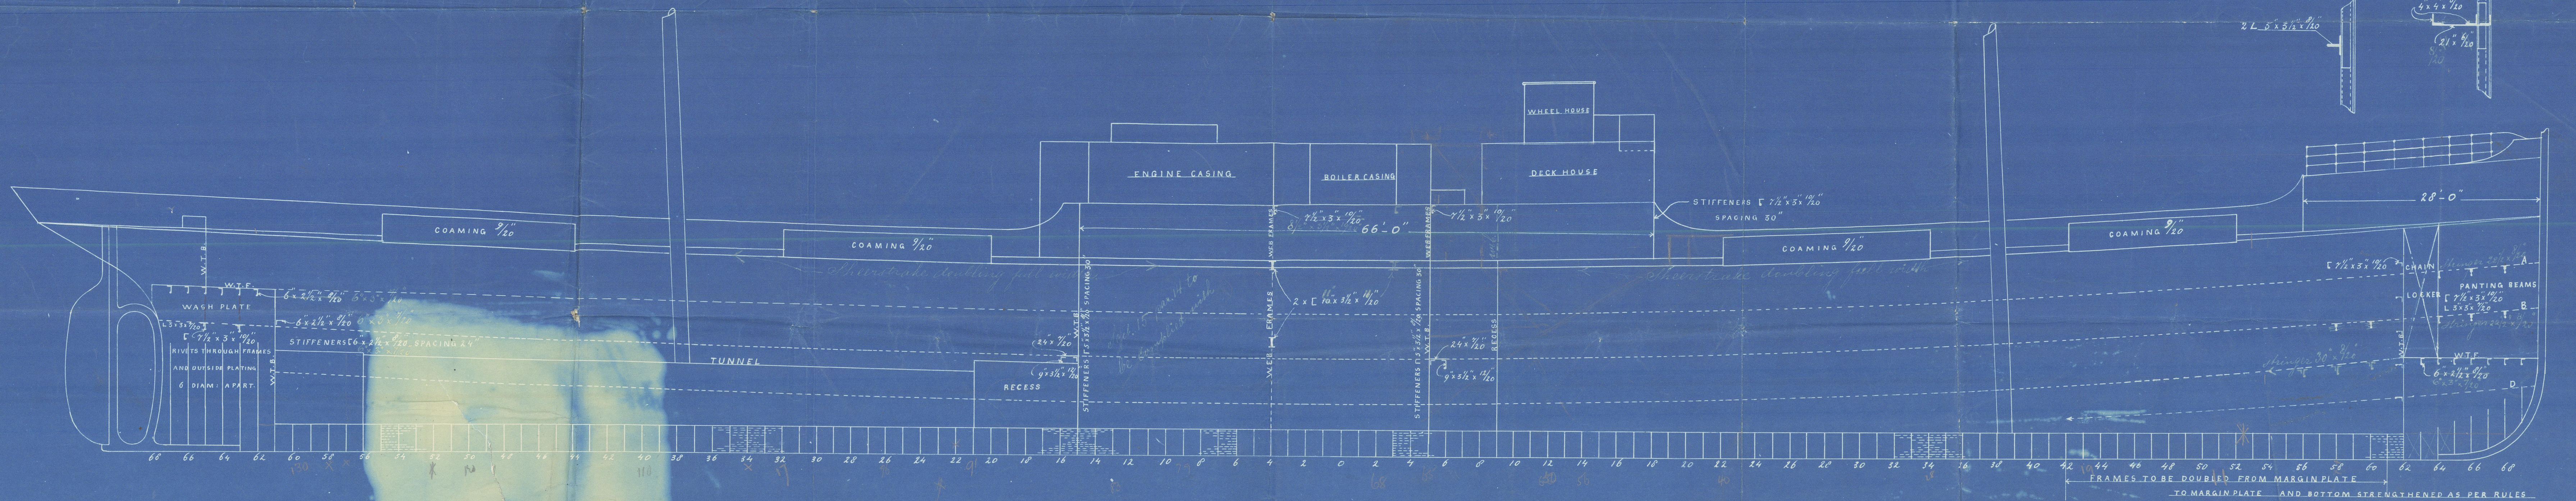


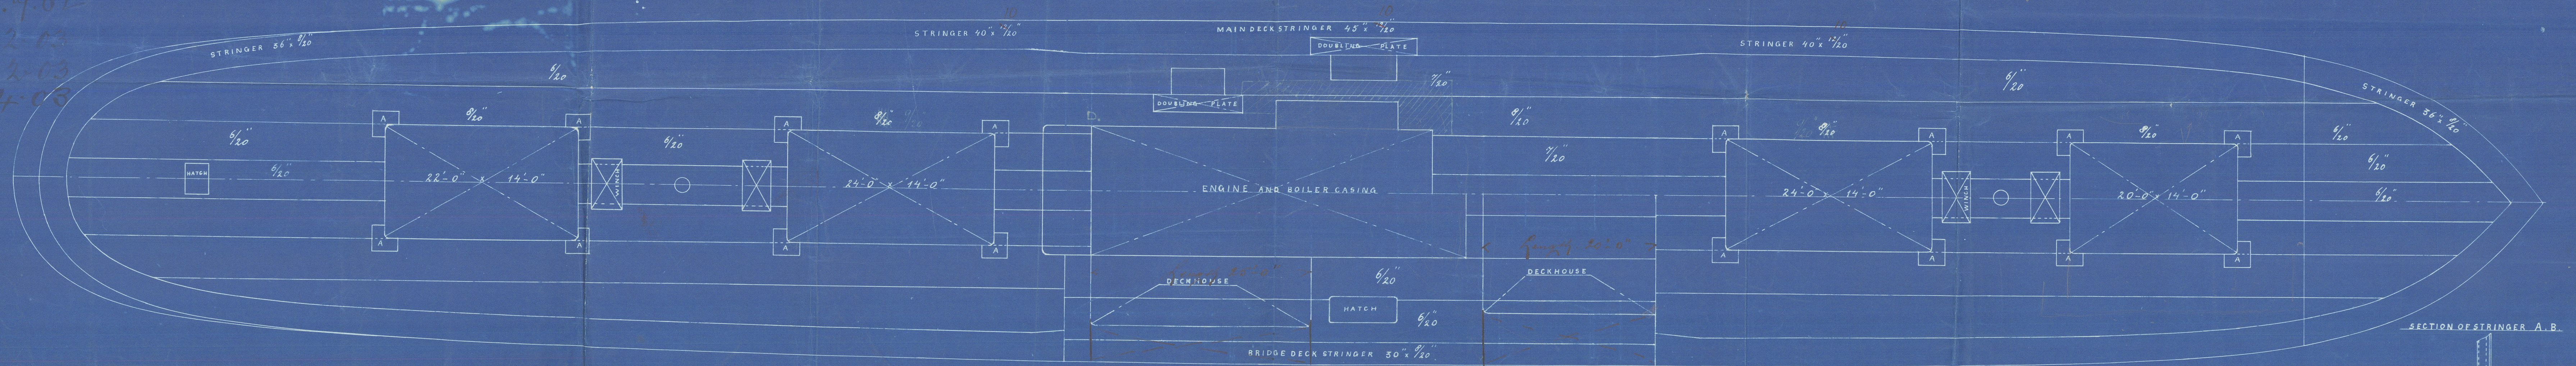

Part. of Rotterdam  
Report. no. 3413.

Steamer. Dorothea  
Yard. no. 150

Profile Plan.

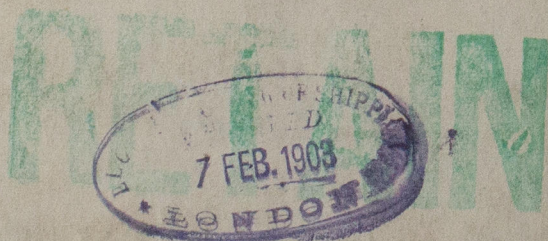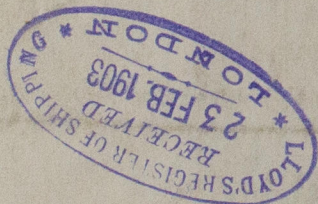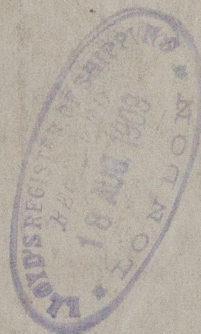

W872-0038



© 2021

Lloyd's Register  
Foundation





W872-0038



© 2021

Lloyd's Register  
Foundation