





S. S. Kingsholm

Midship Section  
9.



Profile No 355

Proposed. Twin Screw Motor ~~Steam~~

Class. A. for Bristol  
Channel purposes only

Isaac. J. Abdela & Whitcomb Ltd.  
Queen's Ferry  
Chester

Rev Rpt No 71687.

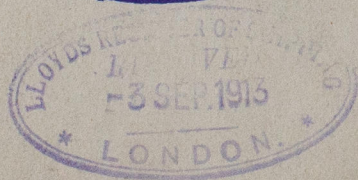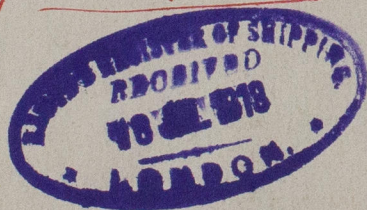

W872-0114

RETAIN



© 2021

Lloyd's Register