


Midship Section
Craig Taylor & Co.
No 98.

S.S. Bürgermeister Hackmann
Kbro Report No 3169.

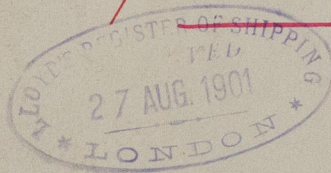

RETAIN



© 2021

Lloyd's Register
Foundation

W872-0193