

312 h. Bles

Messrs Richardsons Wentgar
& Co^{rs} Ltd. Sunderland

for

Messrs The Northumberland & S^{rs}



S. S. 184

Duplicate of h^o 305 & 311.

'Dalebank'

Sl. Rpt No 24909.

LLOYD'S TEST
N^o 2908
360 LBS
26-4-11 L.S.S.

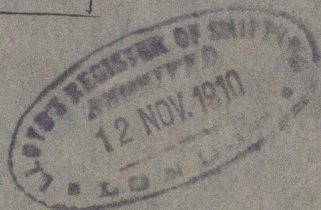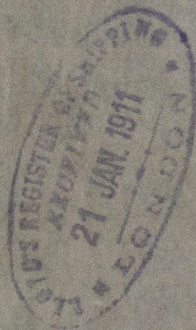

*See below
and attached from
Lloyd's*

copy of

REMAIN



© 2021

Lloyd's Register
Foundation

W873-0048